


03BH12-1001

0374_4130

155-71
POWER
INSTALLATIONS
BOLD HEAD
1.500

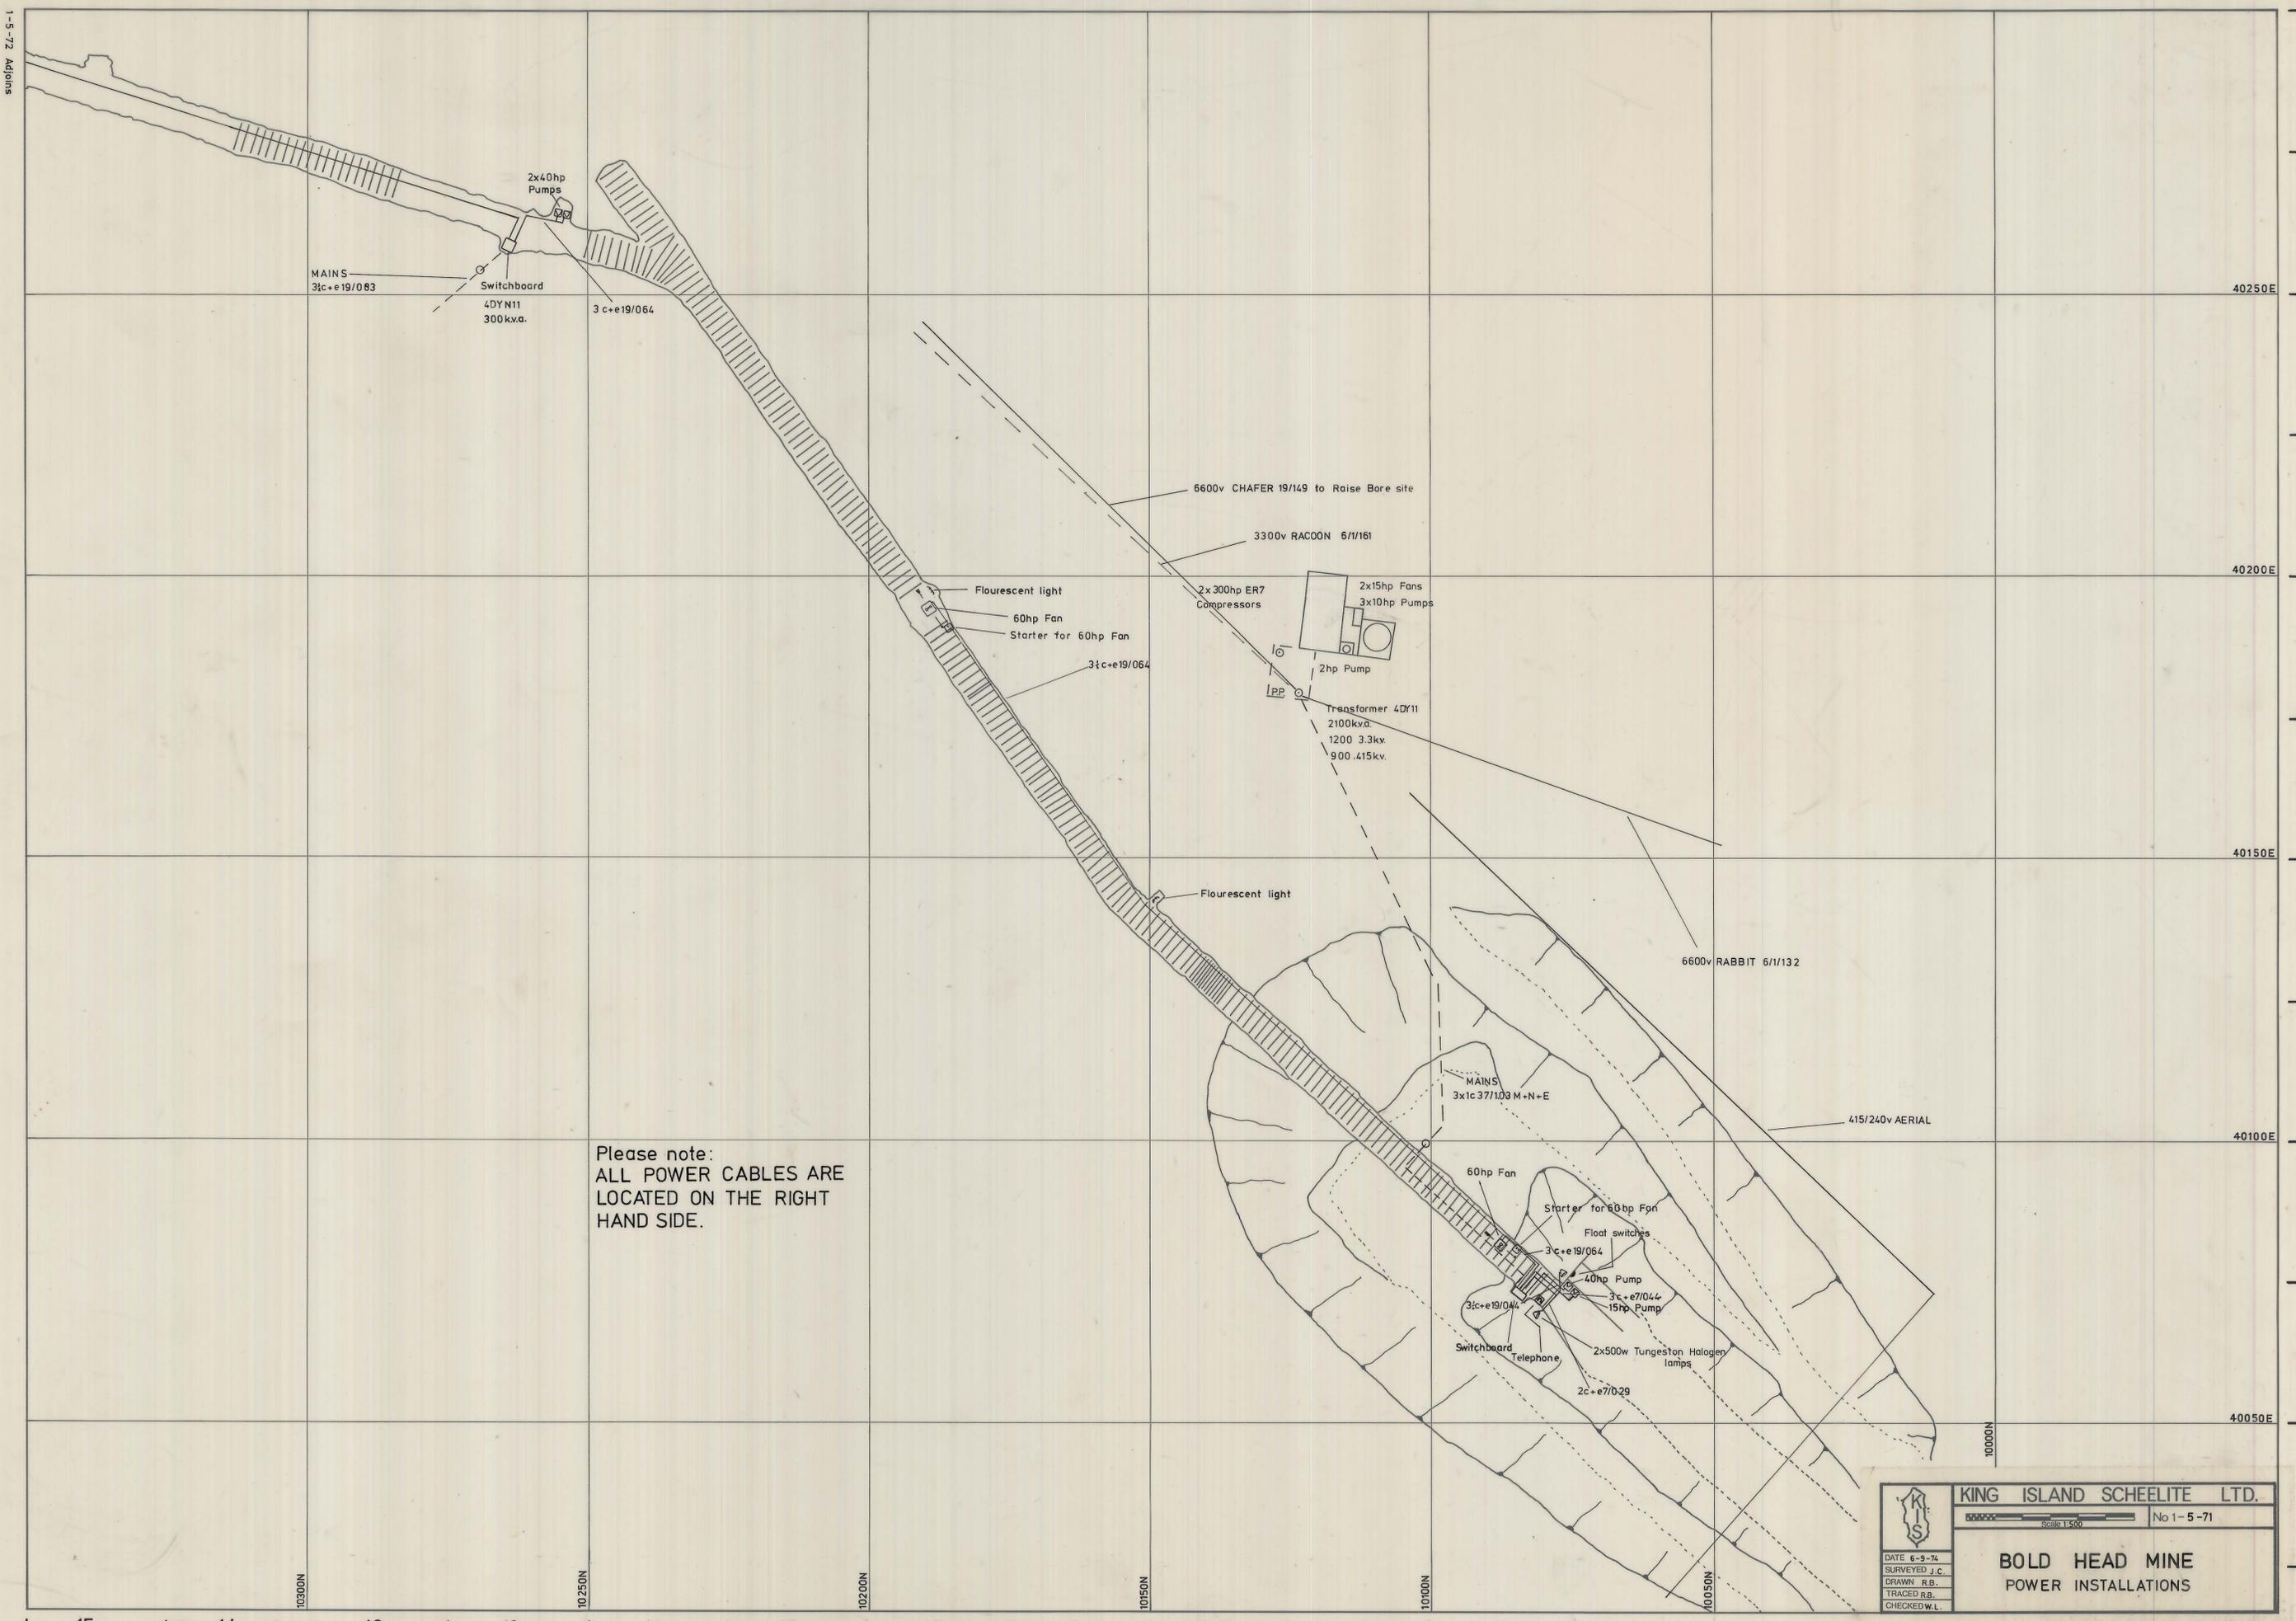

Please note:
ALL POWER CABLES ARE
LOCATED ON THE RIGHT
HAND SIDE.

	KING ISLAND SCHEELITE LTD.	
	Scale 1:500	No 1-5-71
DATE 6-9-74	SURVEYED J.C.	
DRAWN R.B.	TRACED R.B.	
CHECKED W.L.		
BOLD HEAD MINE POWER INSTALLATIONS		