


5 cm

03 BH 12-1002

0374_4131

1-5-72
POWER &
INSTALLATION
BOLD HEAD
1:500

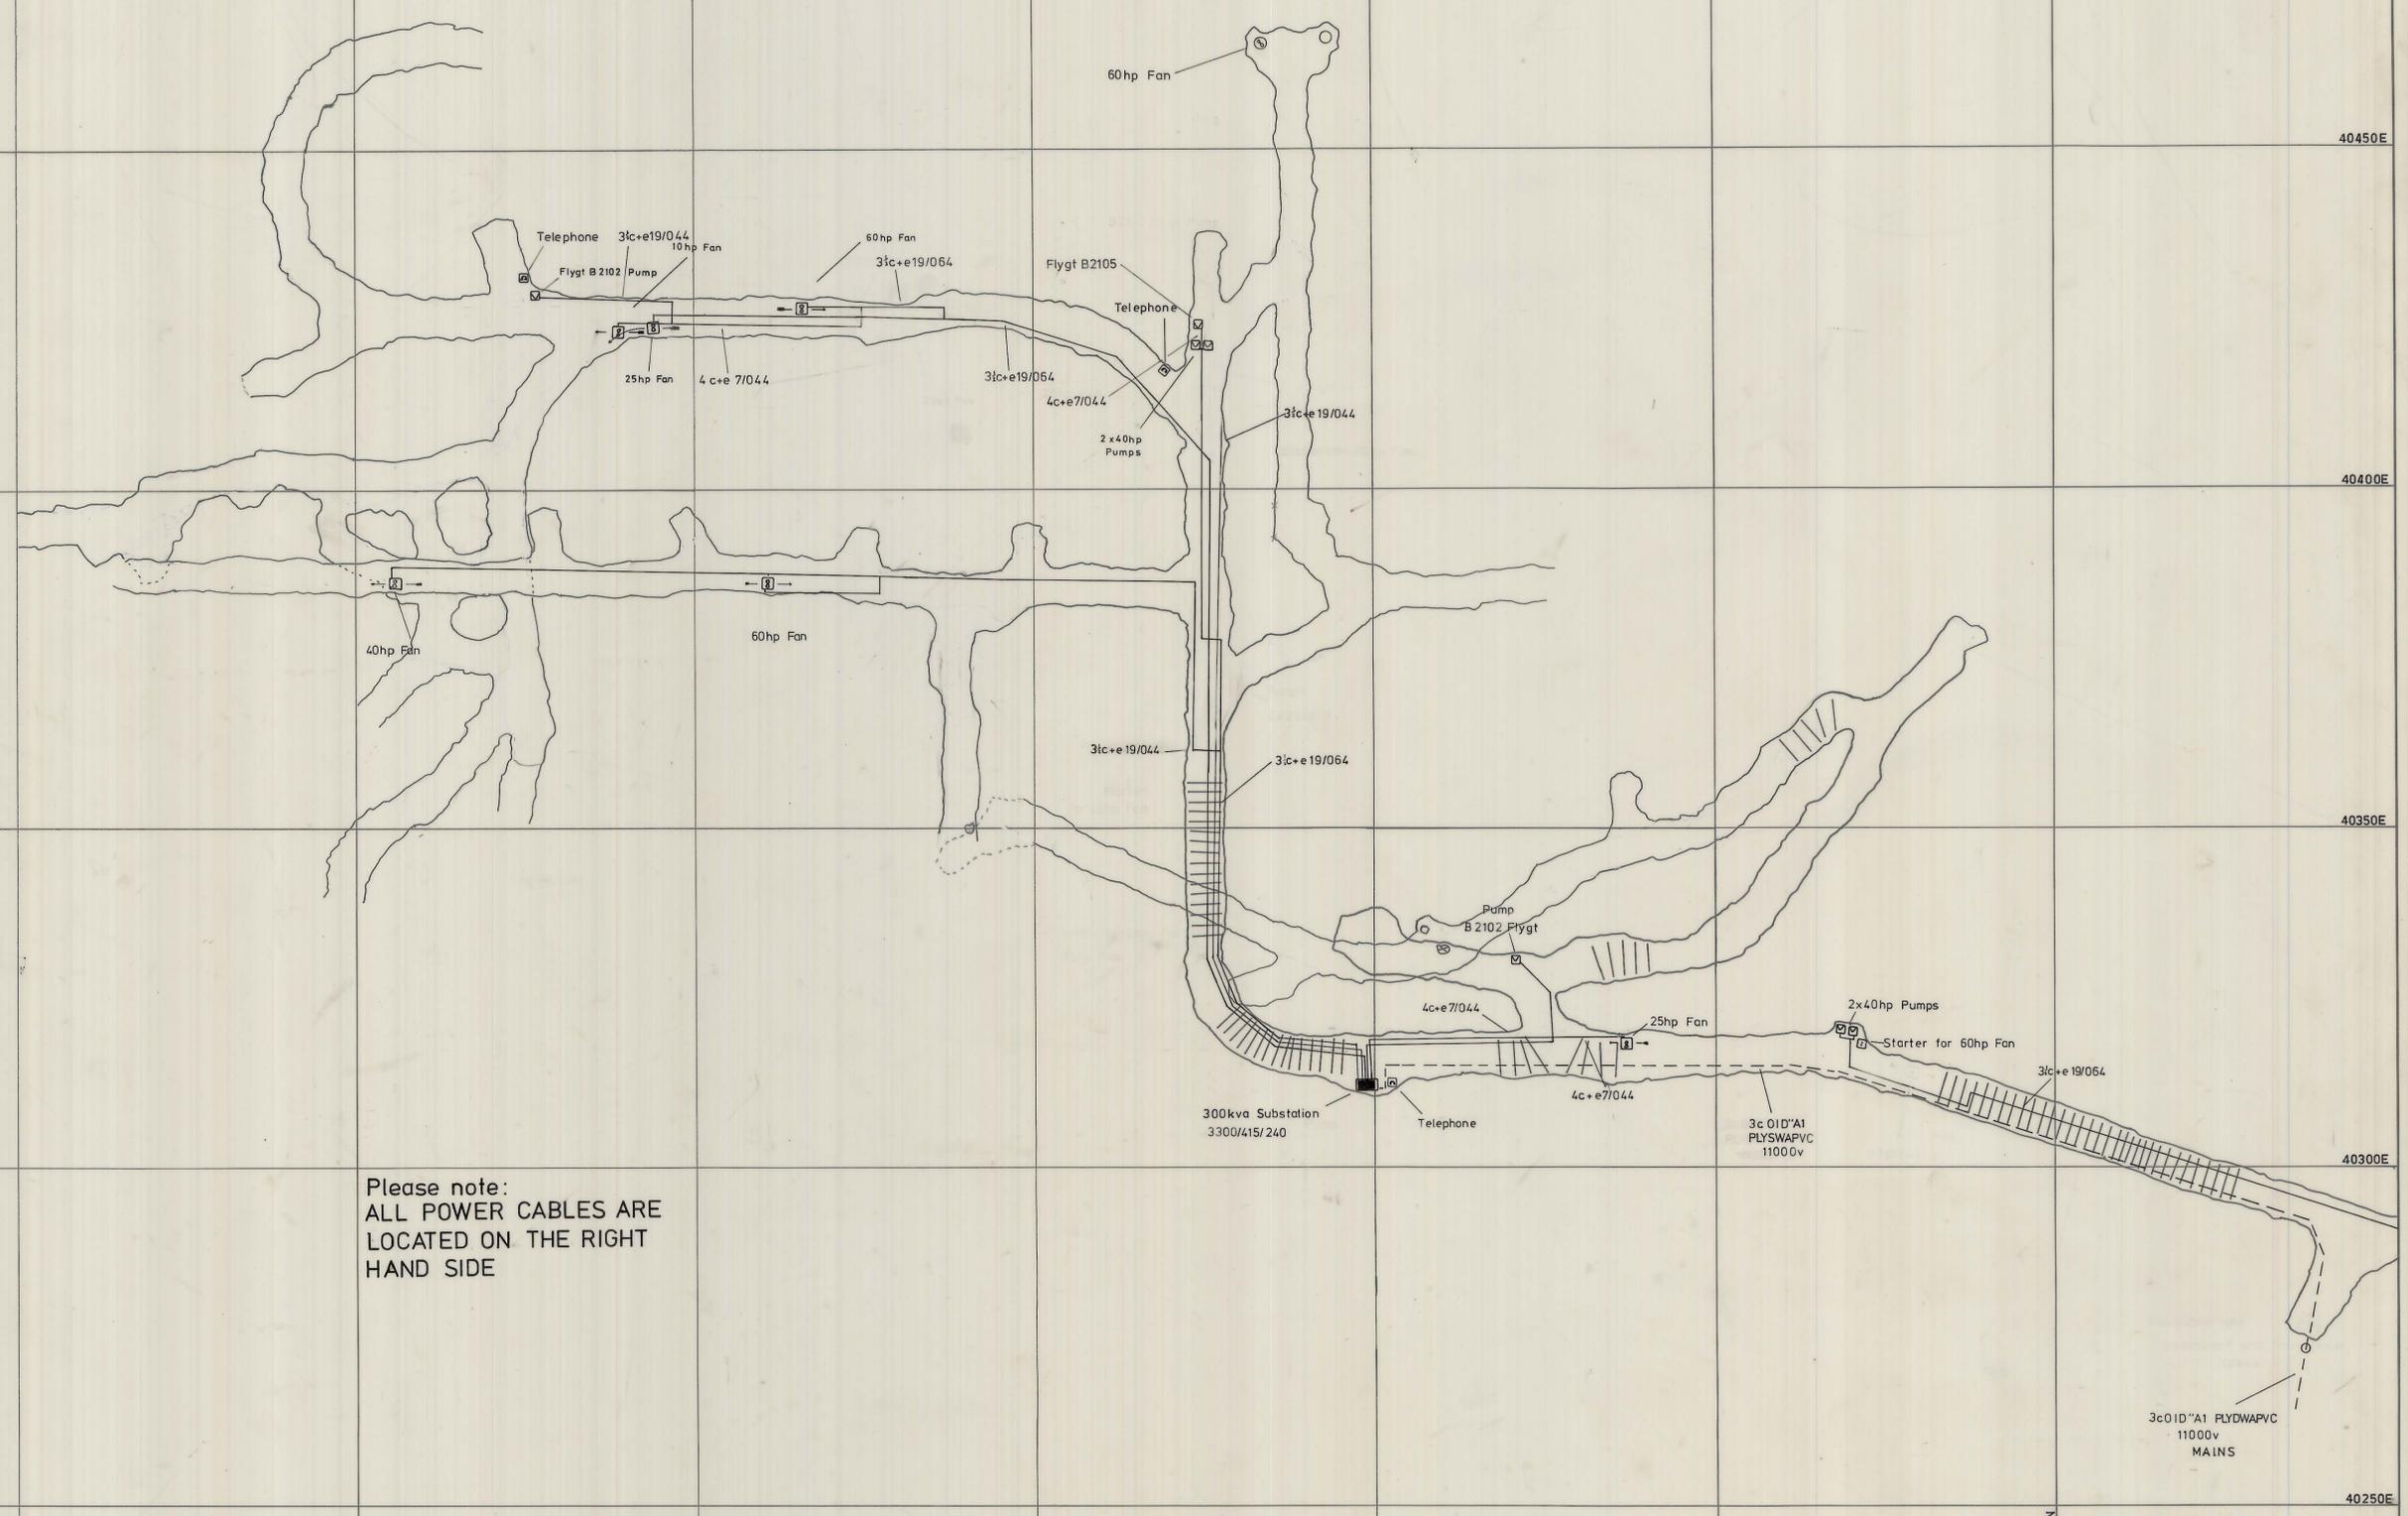

Please note:
ALL POWER CABLES ARE
LOCATED ON THE RIGHT
HAND SIDE

	KING ISLAND SCHEELITE LTD.	
	Scale 1:500	No 1-5-72
	BOLD HEAD MINE POWER INSTALLATIONS	
	DATE 6-9-74 SURVEYED J.C. DRAWN R.B. TRACED R.B. CHECKED D.W.L.	

10700N 10650N 10600N 10550N 10500N 10450N 10400N 10350E 10300E 10250E 31 30 29 28 27 26 25 24 23 22 21 20 19 18 17 16

T
S
R
Q
P
O
N
M
L
K
J