


03 BH 12-1004
0374_4133

1-5-62
LOCATION
OF SERVICES
1:500
BOLD HEAD

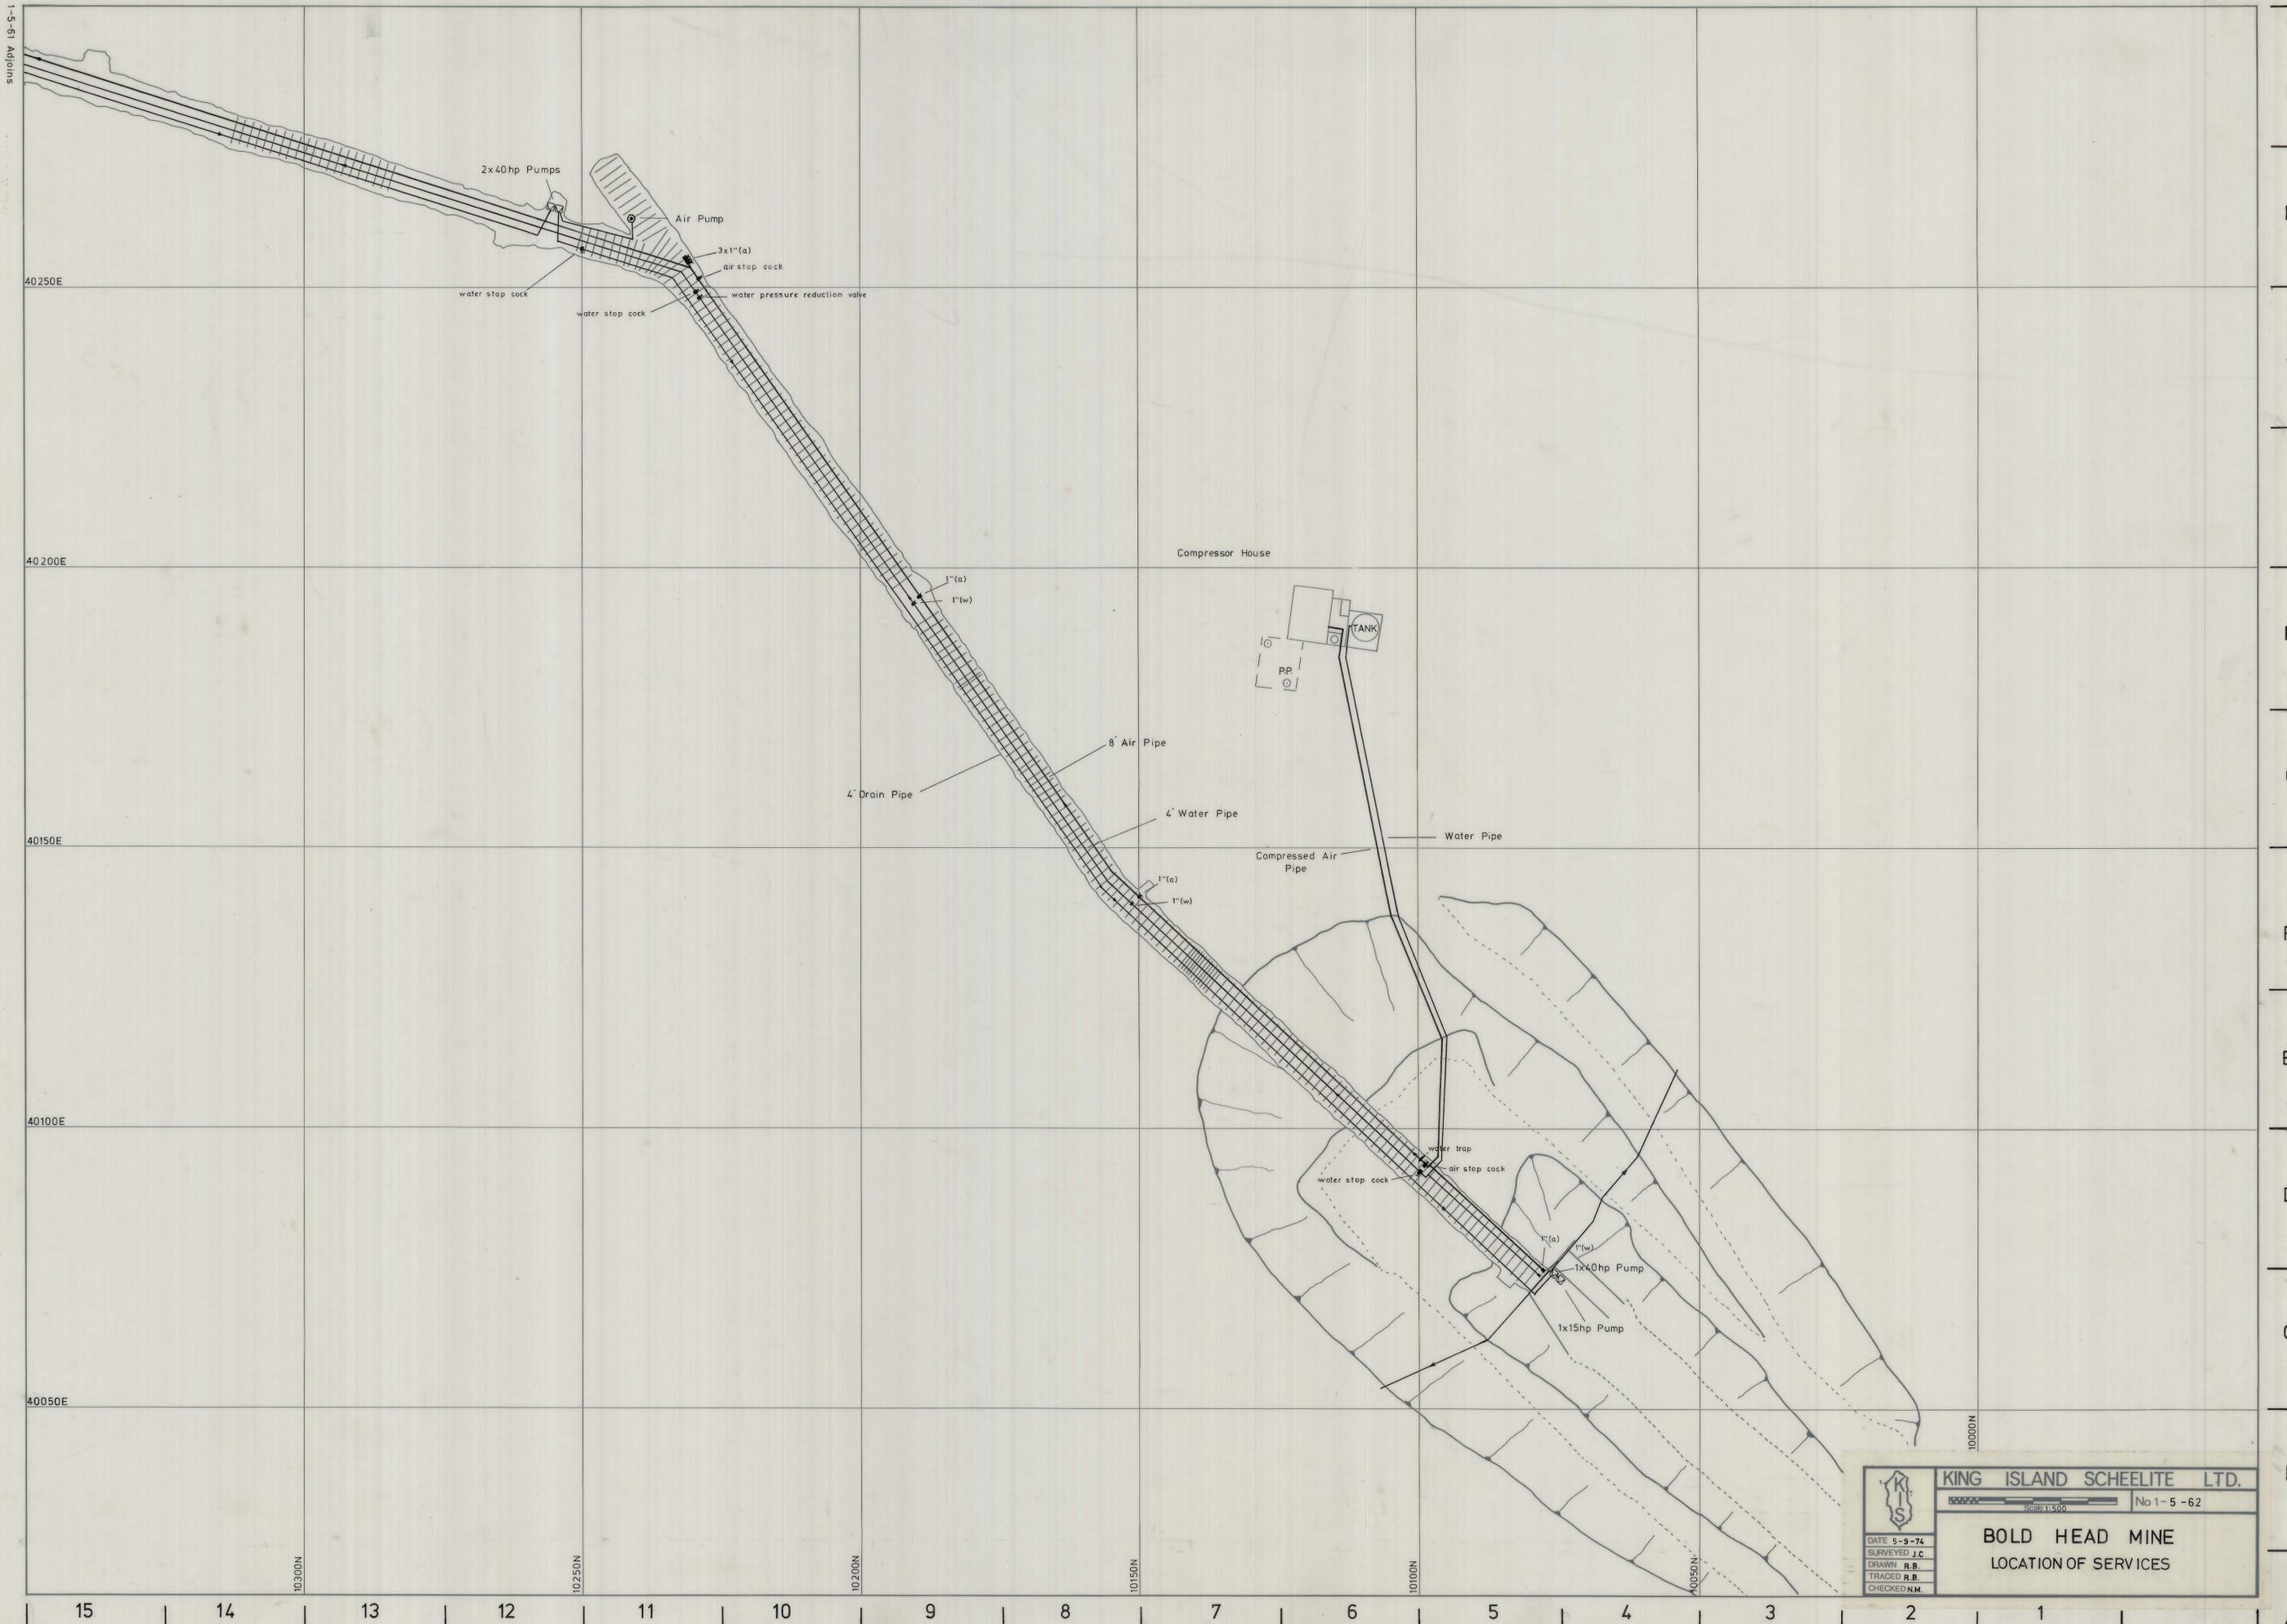

	KING ISLAND SCHEELITE LTD.	
	Scale 1:500	No 1-5-62
BOLD HEAD MINE		
LOCATION OF SERVICES		
DATE 5-9-74	SURVEYED J.C.	
DRAWN R.B.	TRACED R.B.	
CHECKED N.M.		