




0374\_4136

HOLE N<sup>o</sup> 1. 19.33m @ 47°44'

BEARING 270°

START 10 621 N 40 385 E

TARGET 10 621 N 40 371 E

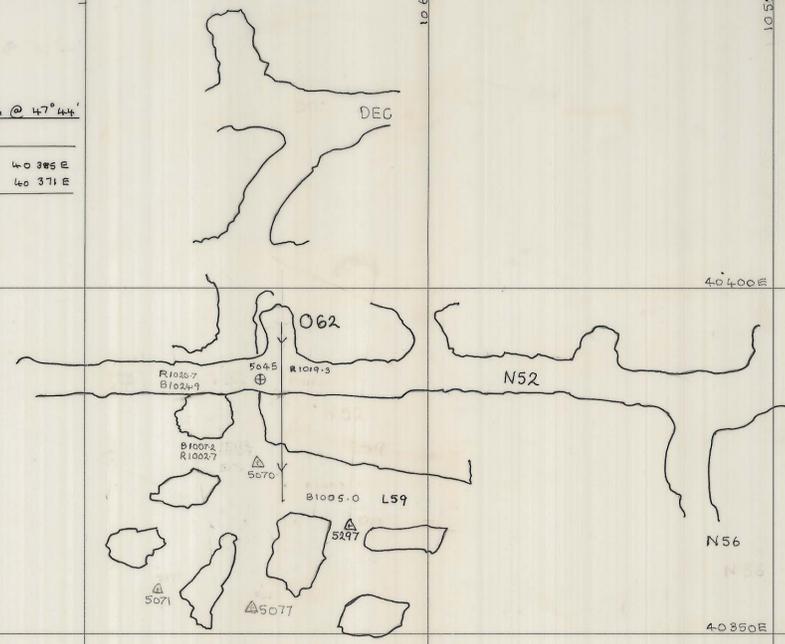


HOLE N<sup>o</sup> 3. 18.34m @ 91°8'

BEARING 28°09'

AMENDED 18-1-80

START 10 623.5 N 40 367.6 E

TARGET 10 623.5 N 40 362.5 E

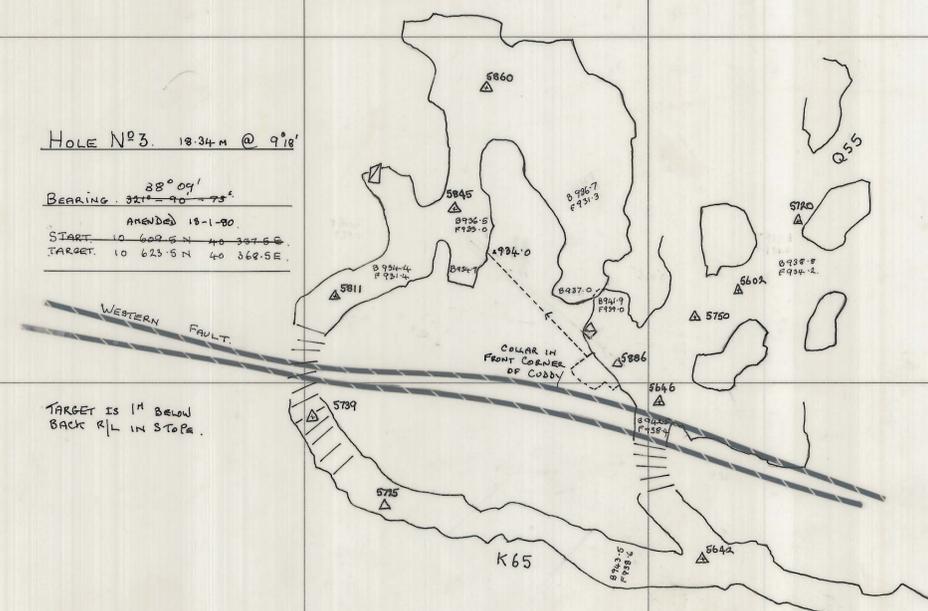


TARGET IS 1M BELOW BACK R/L IN STOPS.

HOLE N<sup>o</sup> 2. 63.58m @ 71°38'

BEARING 220°-09' - 22°

START 10 621.5 N 40 367 E

TARGET 10 609.5 N 40 353.5 E

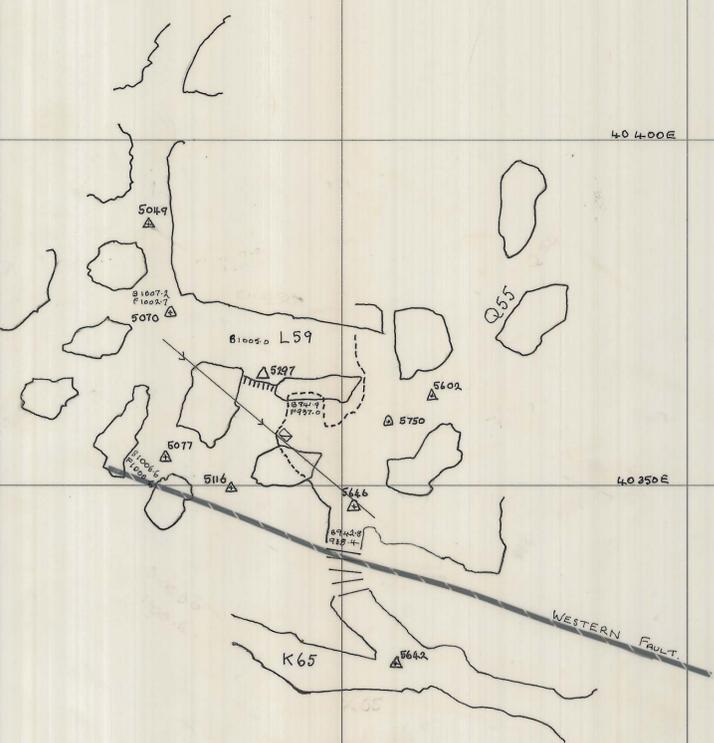

APPROVAL	COPY
PLANNING ENG.: <i>C. Sinden</i>	
SENIOR PLAN. ENG.: <i>W. Crawley</i>	
MINE SUPT.: <i>W.D. Crawley</i>	2 LARGE
G. MINING SUPT.:	
SENIOR SURV'R.:	
SENIOR GEOLOGIST: <i>J. G. Brown</i>	No. 1
SURVEYOR:	

SCALE 1:500

4 OF 54 HOLES

LOCATION

SUBJECT  
CRAWMASTER HOLES FOR SANDFILL LINE TO R60 STOPE, AND POSSIBLE FIXING OF CI OR C2.

← north