




04BH 02-1002

1:250
BOLD HEAD MINE
RISE SITES
ENVIRONS

0374-4150

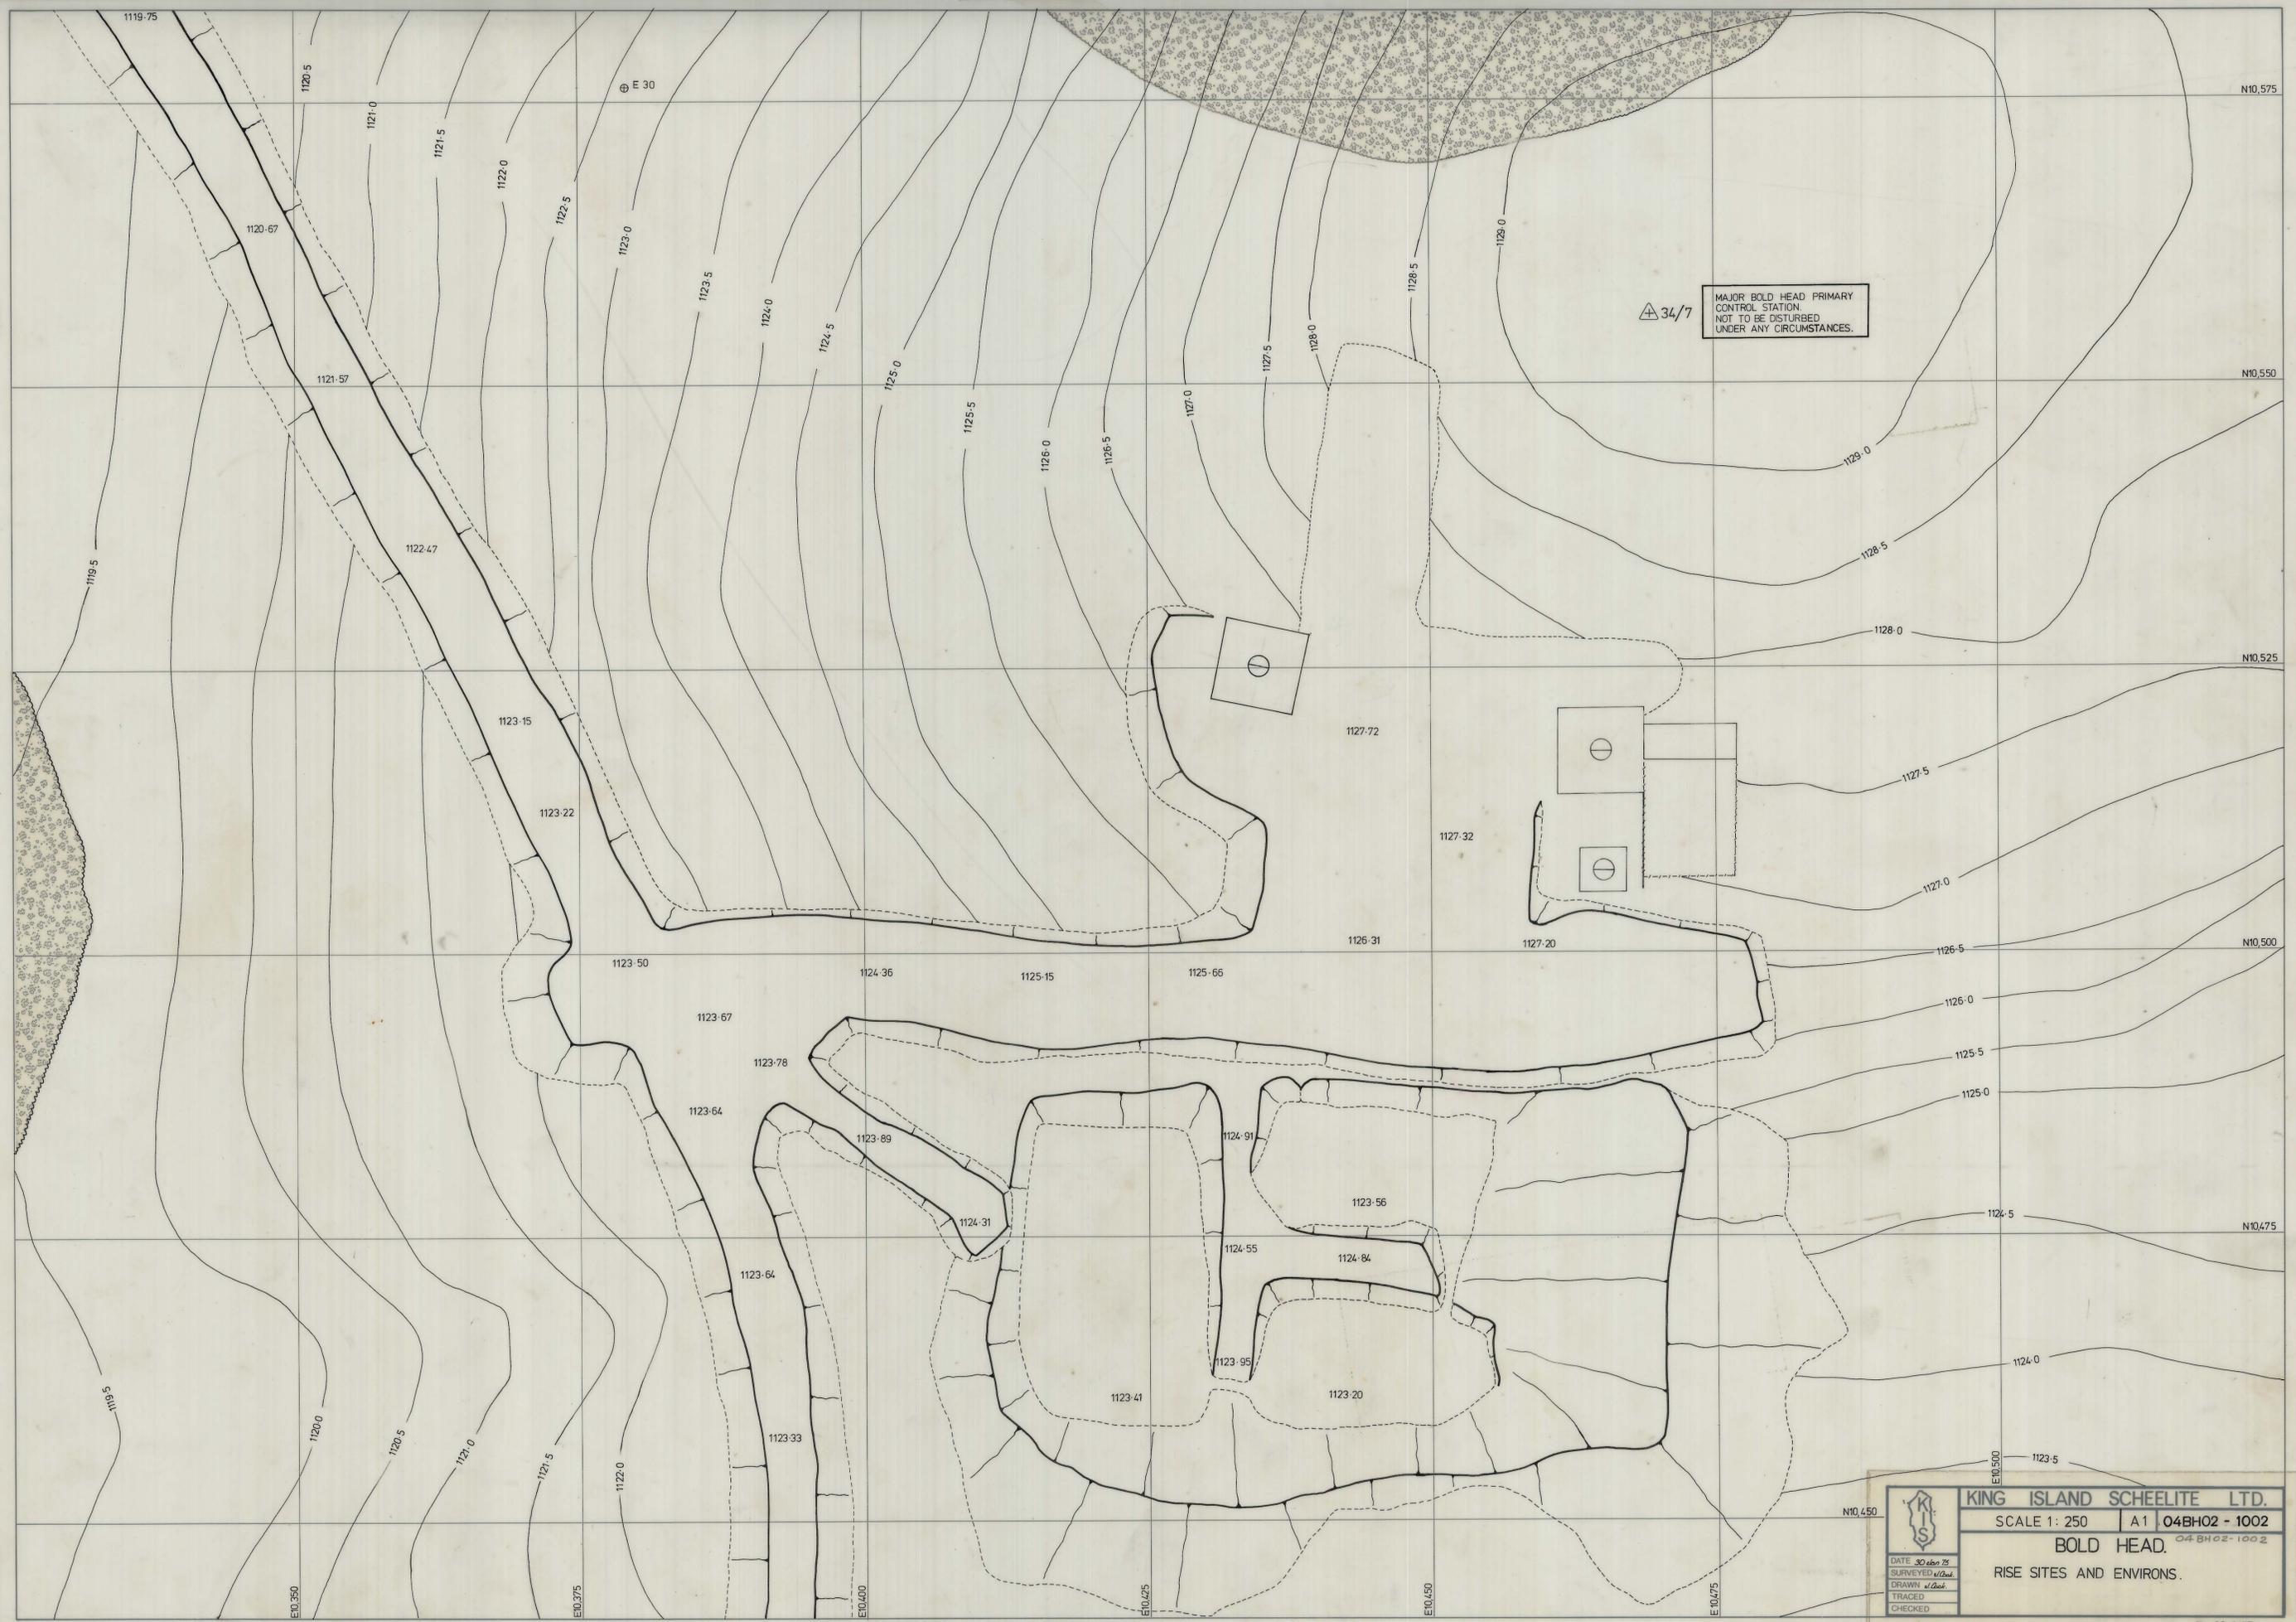

MAJOR BOLD HEAD PRIMARY CONTROL STATION NOT TO BE DISTURBED UNDER ANY CIRCUMSTANCES.

	KING ISLAND SCHEELITE LTD.	
	SCALE 1: 250	A1 04BH02 - 1002
	BOLD HEAD.	
	RISE SITES AND ENVIRONS.	
	DATE 30 Nov 74	
SURVEYED <i>at Desk</i>		
DRAWN <i>at Desk</i>		
TRACED		
CHECKED		