


5 cm

048H03-1001

1:500  
BOLD HEAD MINE  
Raise Sites

0374-4151

27 JUN 1981

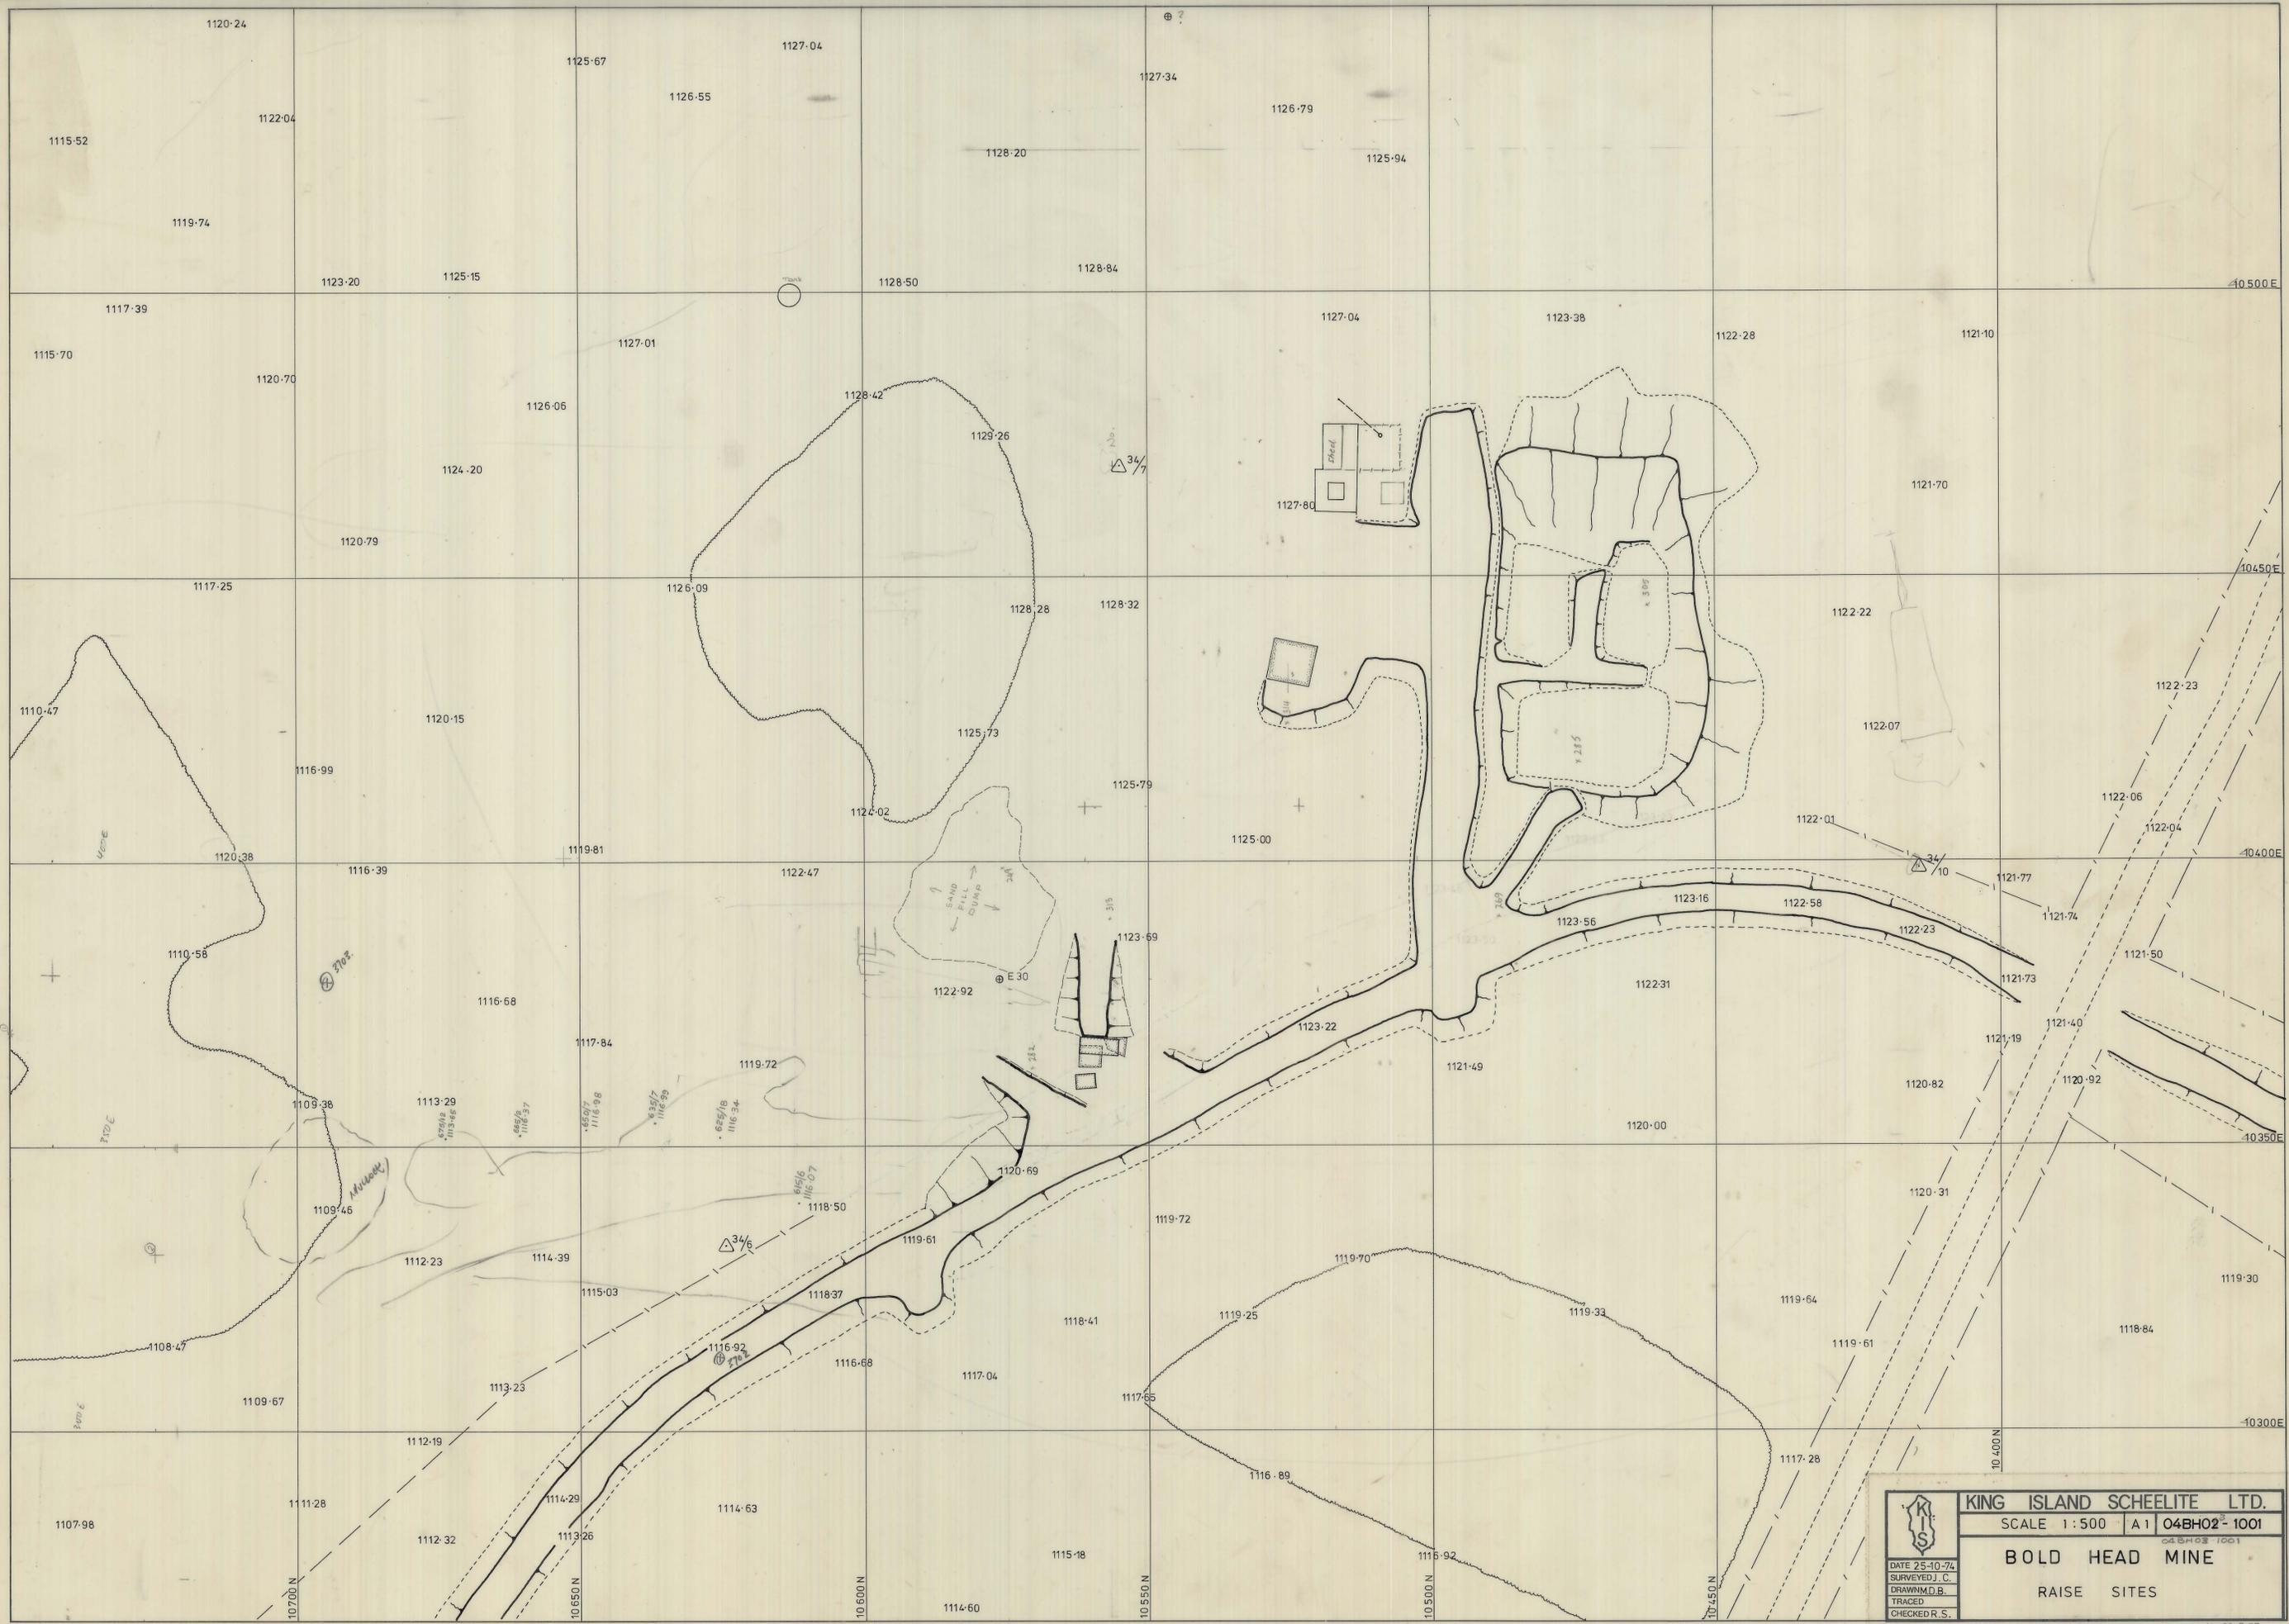

	KING ISLAND SCHEELITE LTD.	
	SCALE 1:500	A1 048H02-1001
	BOLD HEAD MINE	
	RAISE SITES	
DATE 25-10-74	SURVEYED J.C.	
DRAWN M.D.B.		
TRACED		
CHECKED R.S.		