



1:100
BOLD HEAD MINE
X-CUT TURN OFF
1-5-53

0374_4154



5 cm

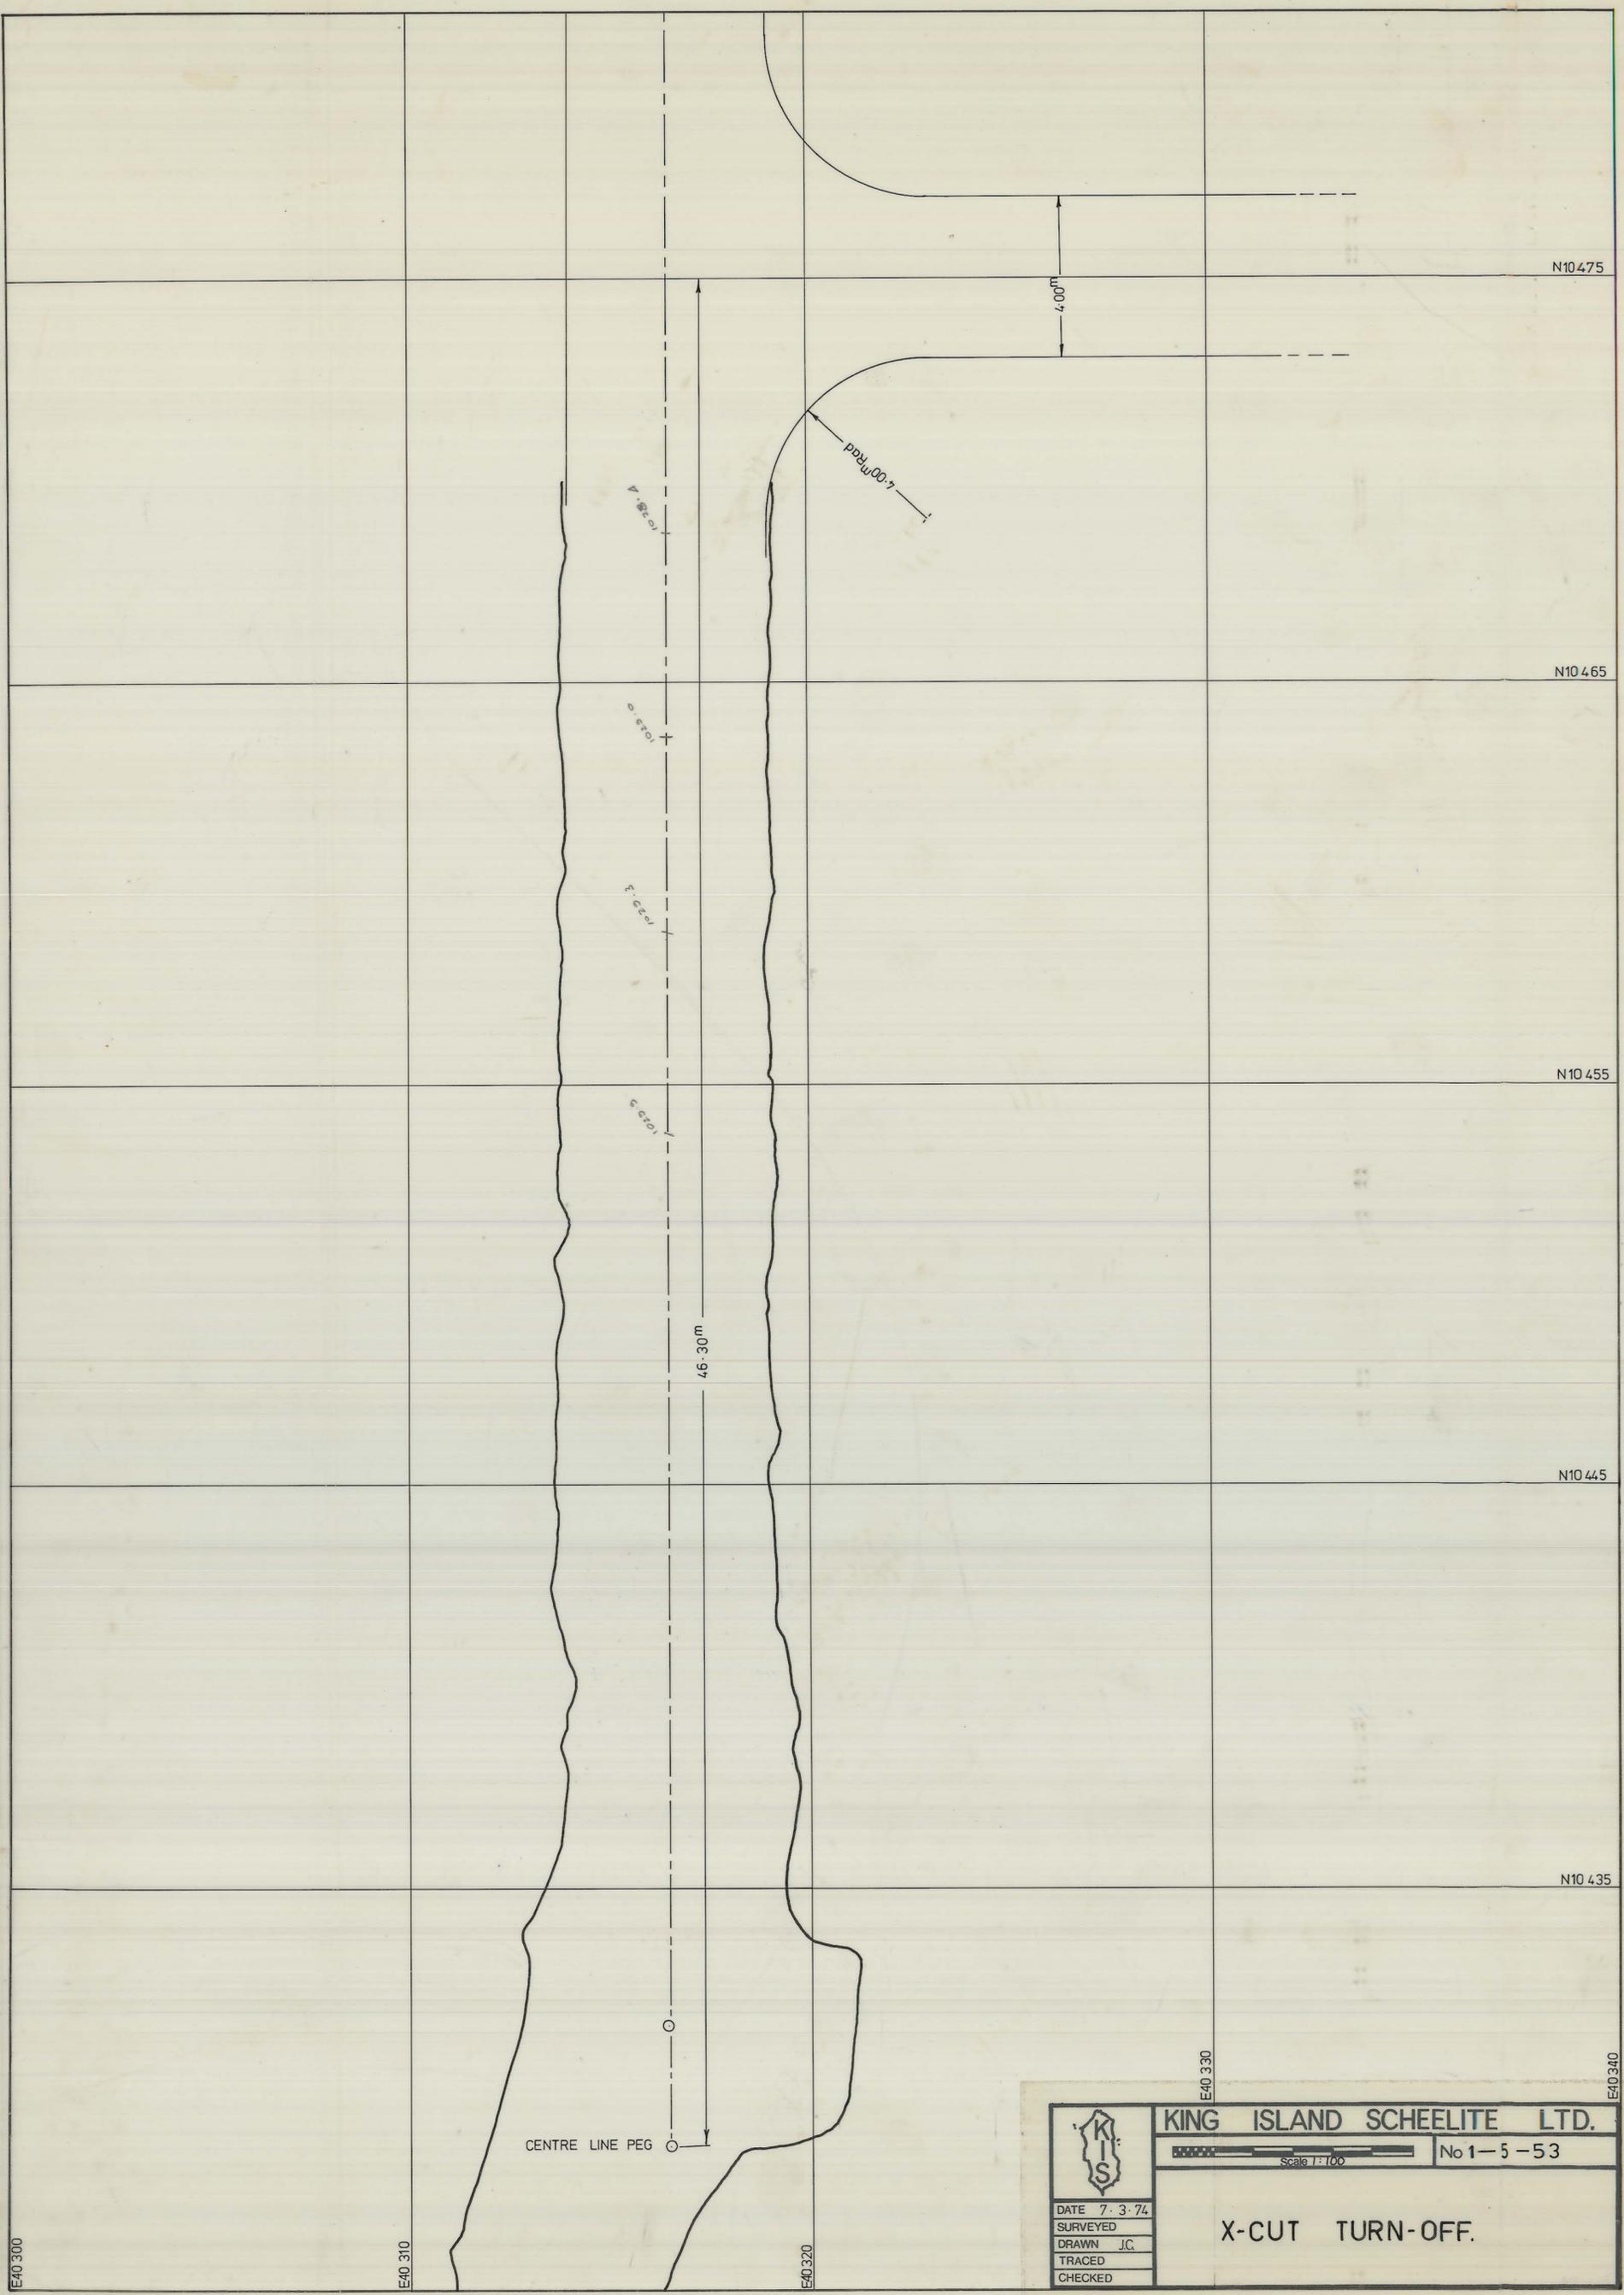

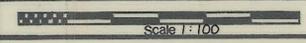	KING ISLAND SCHEELITE LTD.	
	 Scale 1:100	No 1-5-53
DATE 7-3-74 SURVEYED DRAWN J.C. TRACED CHECKED		
X-CUT TURN-OFF.		