
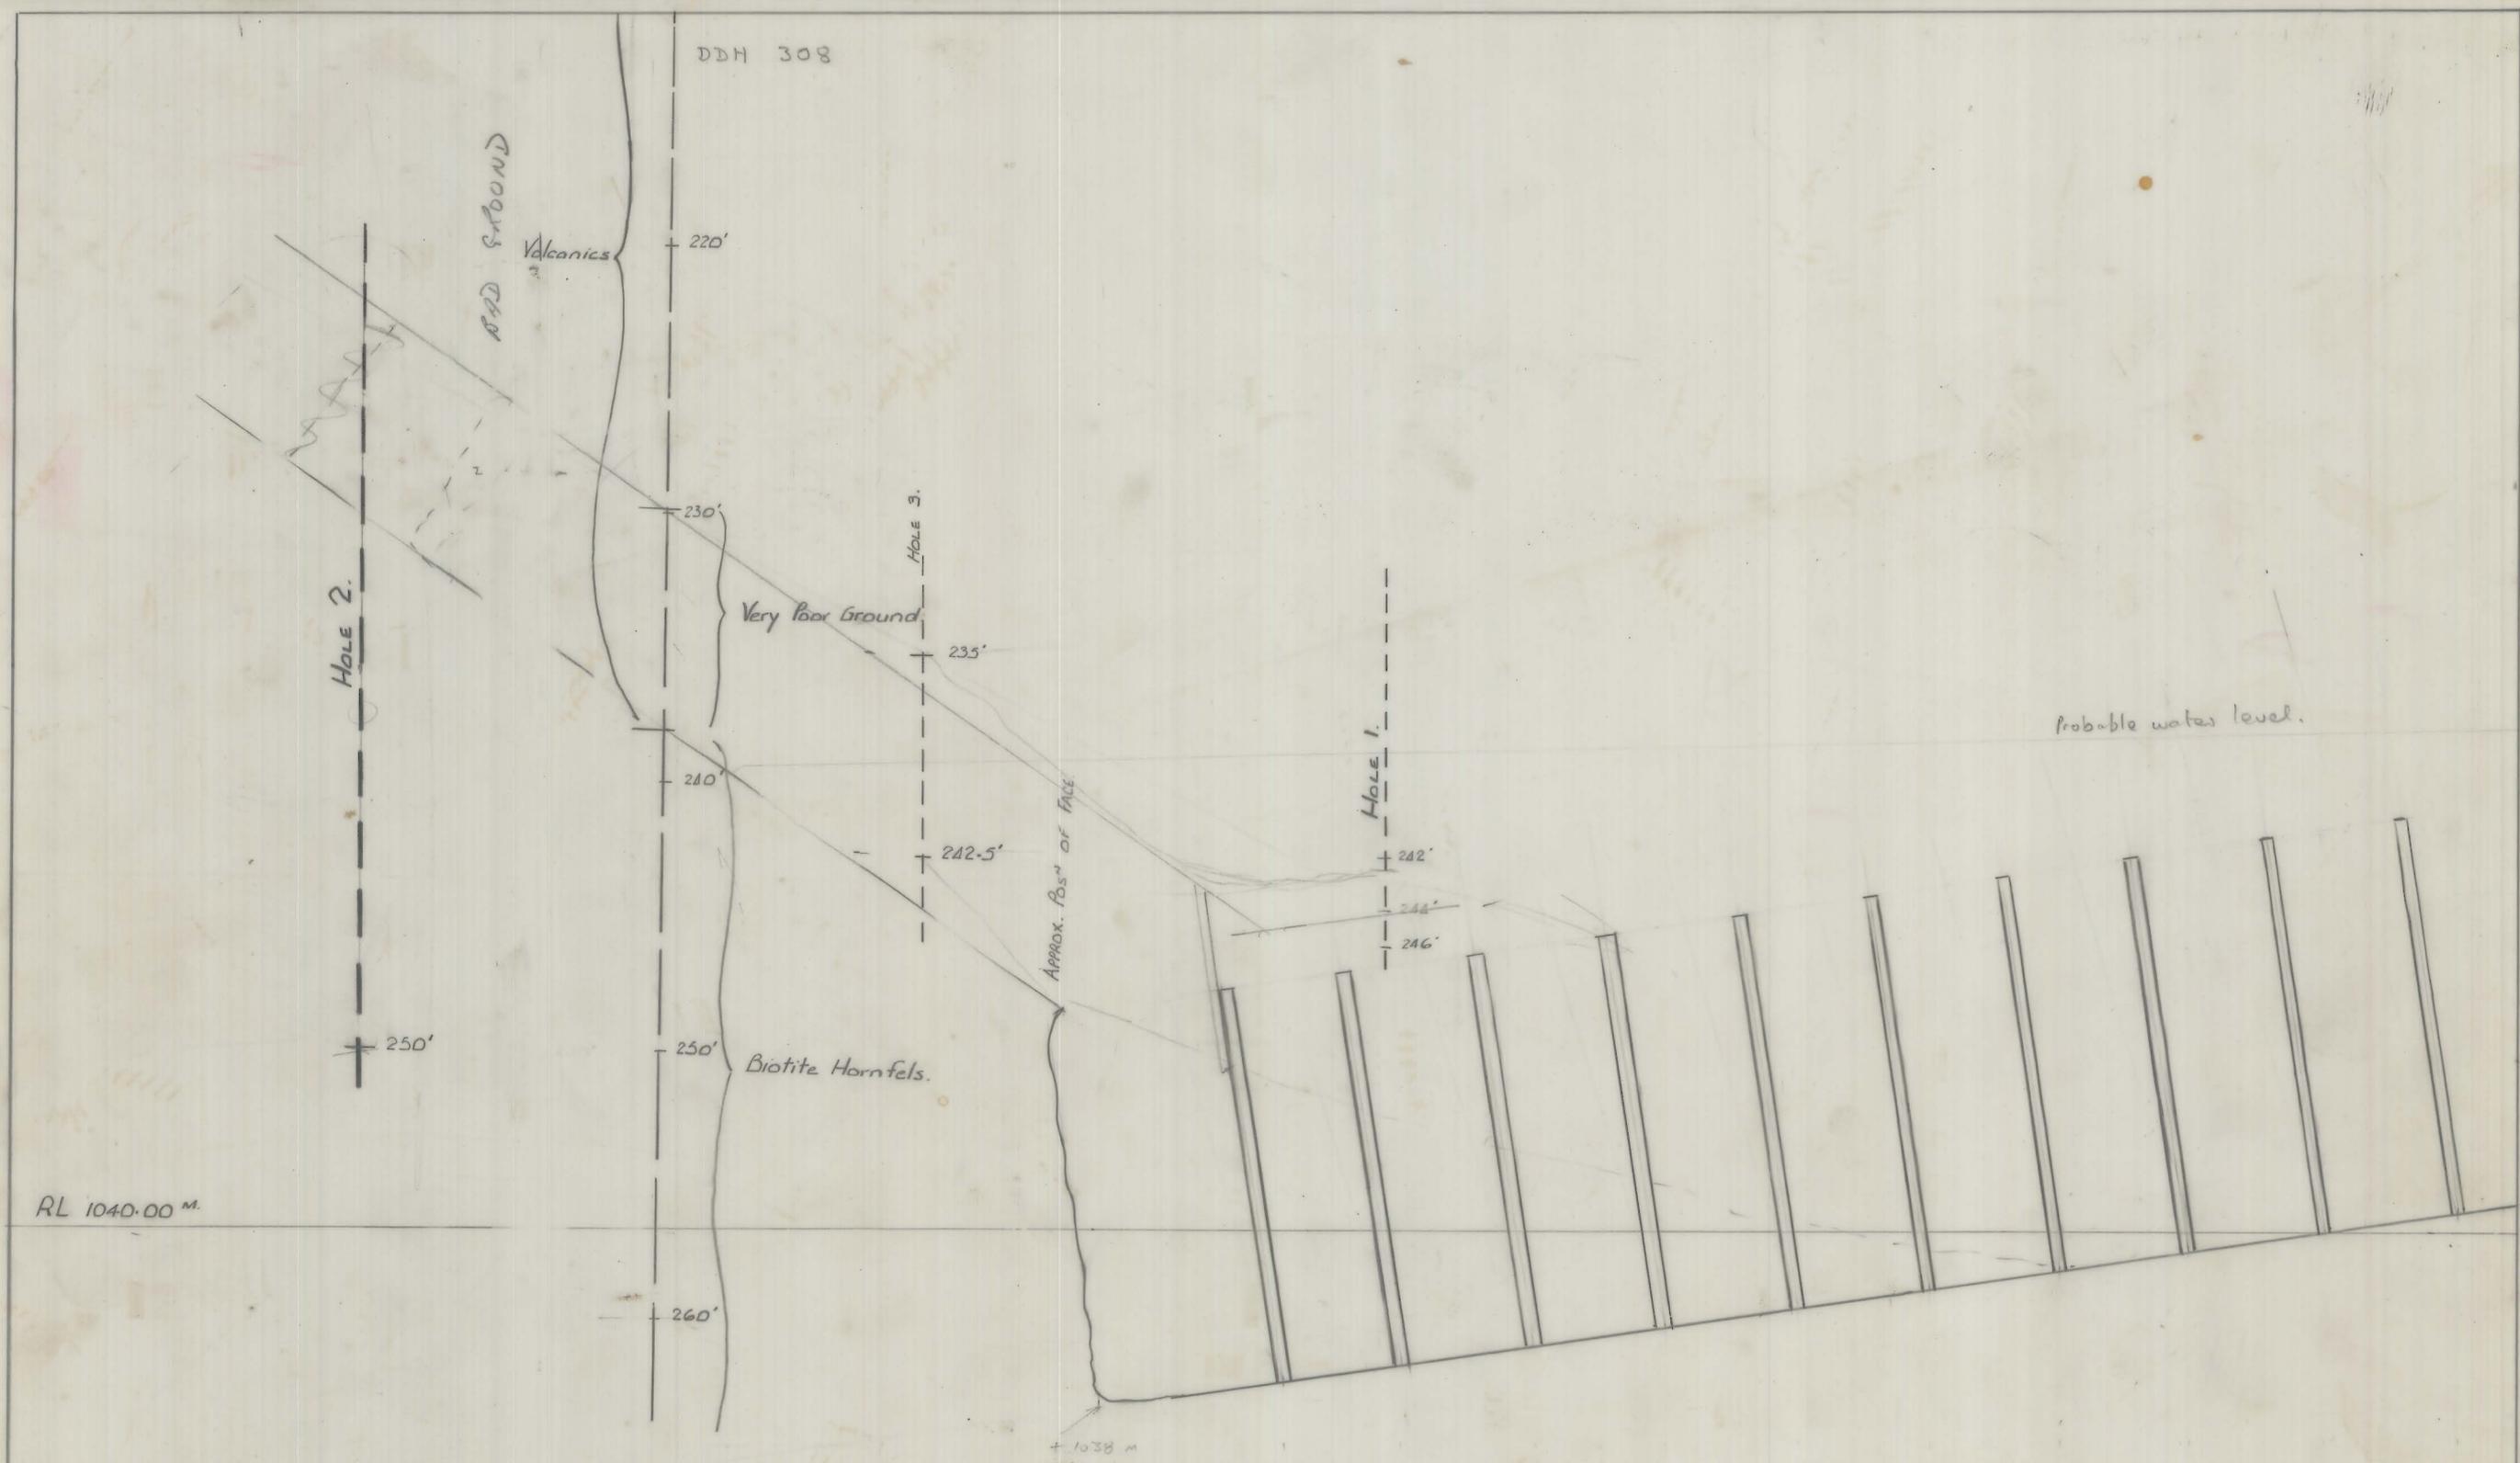


5 cm

0374_4157

1:50
BOLD HEAD MINE
SECTION OF END OF WEST RAMP
POSITION OF HOLES
1-5-45

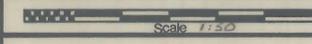

	KING ISLAND SCHEELITE LTD.	
		No 1-5-45
<p>DATE 20 DEC 73 SURVEYED DRAWN J.C. TRACED CHECKED</p>		
<p>SECTION OF END OF WEST RAMP POSITION OF HOLES.</p>		