


5 cm

0374_4158

11100
BOLD HEAD NINE
LINE PED POSITIONS IN
MAIN DECLINE
1-5-81

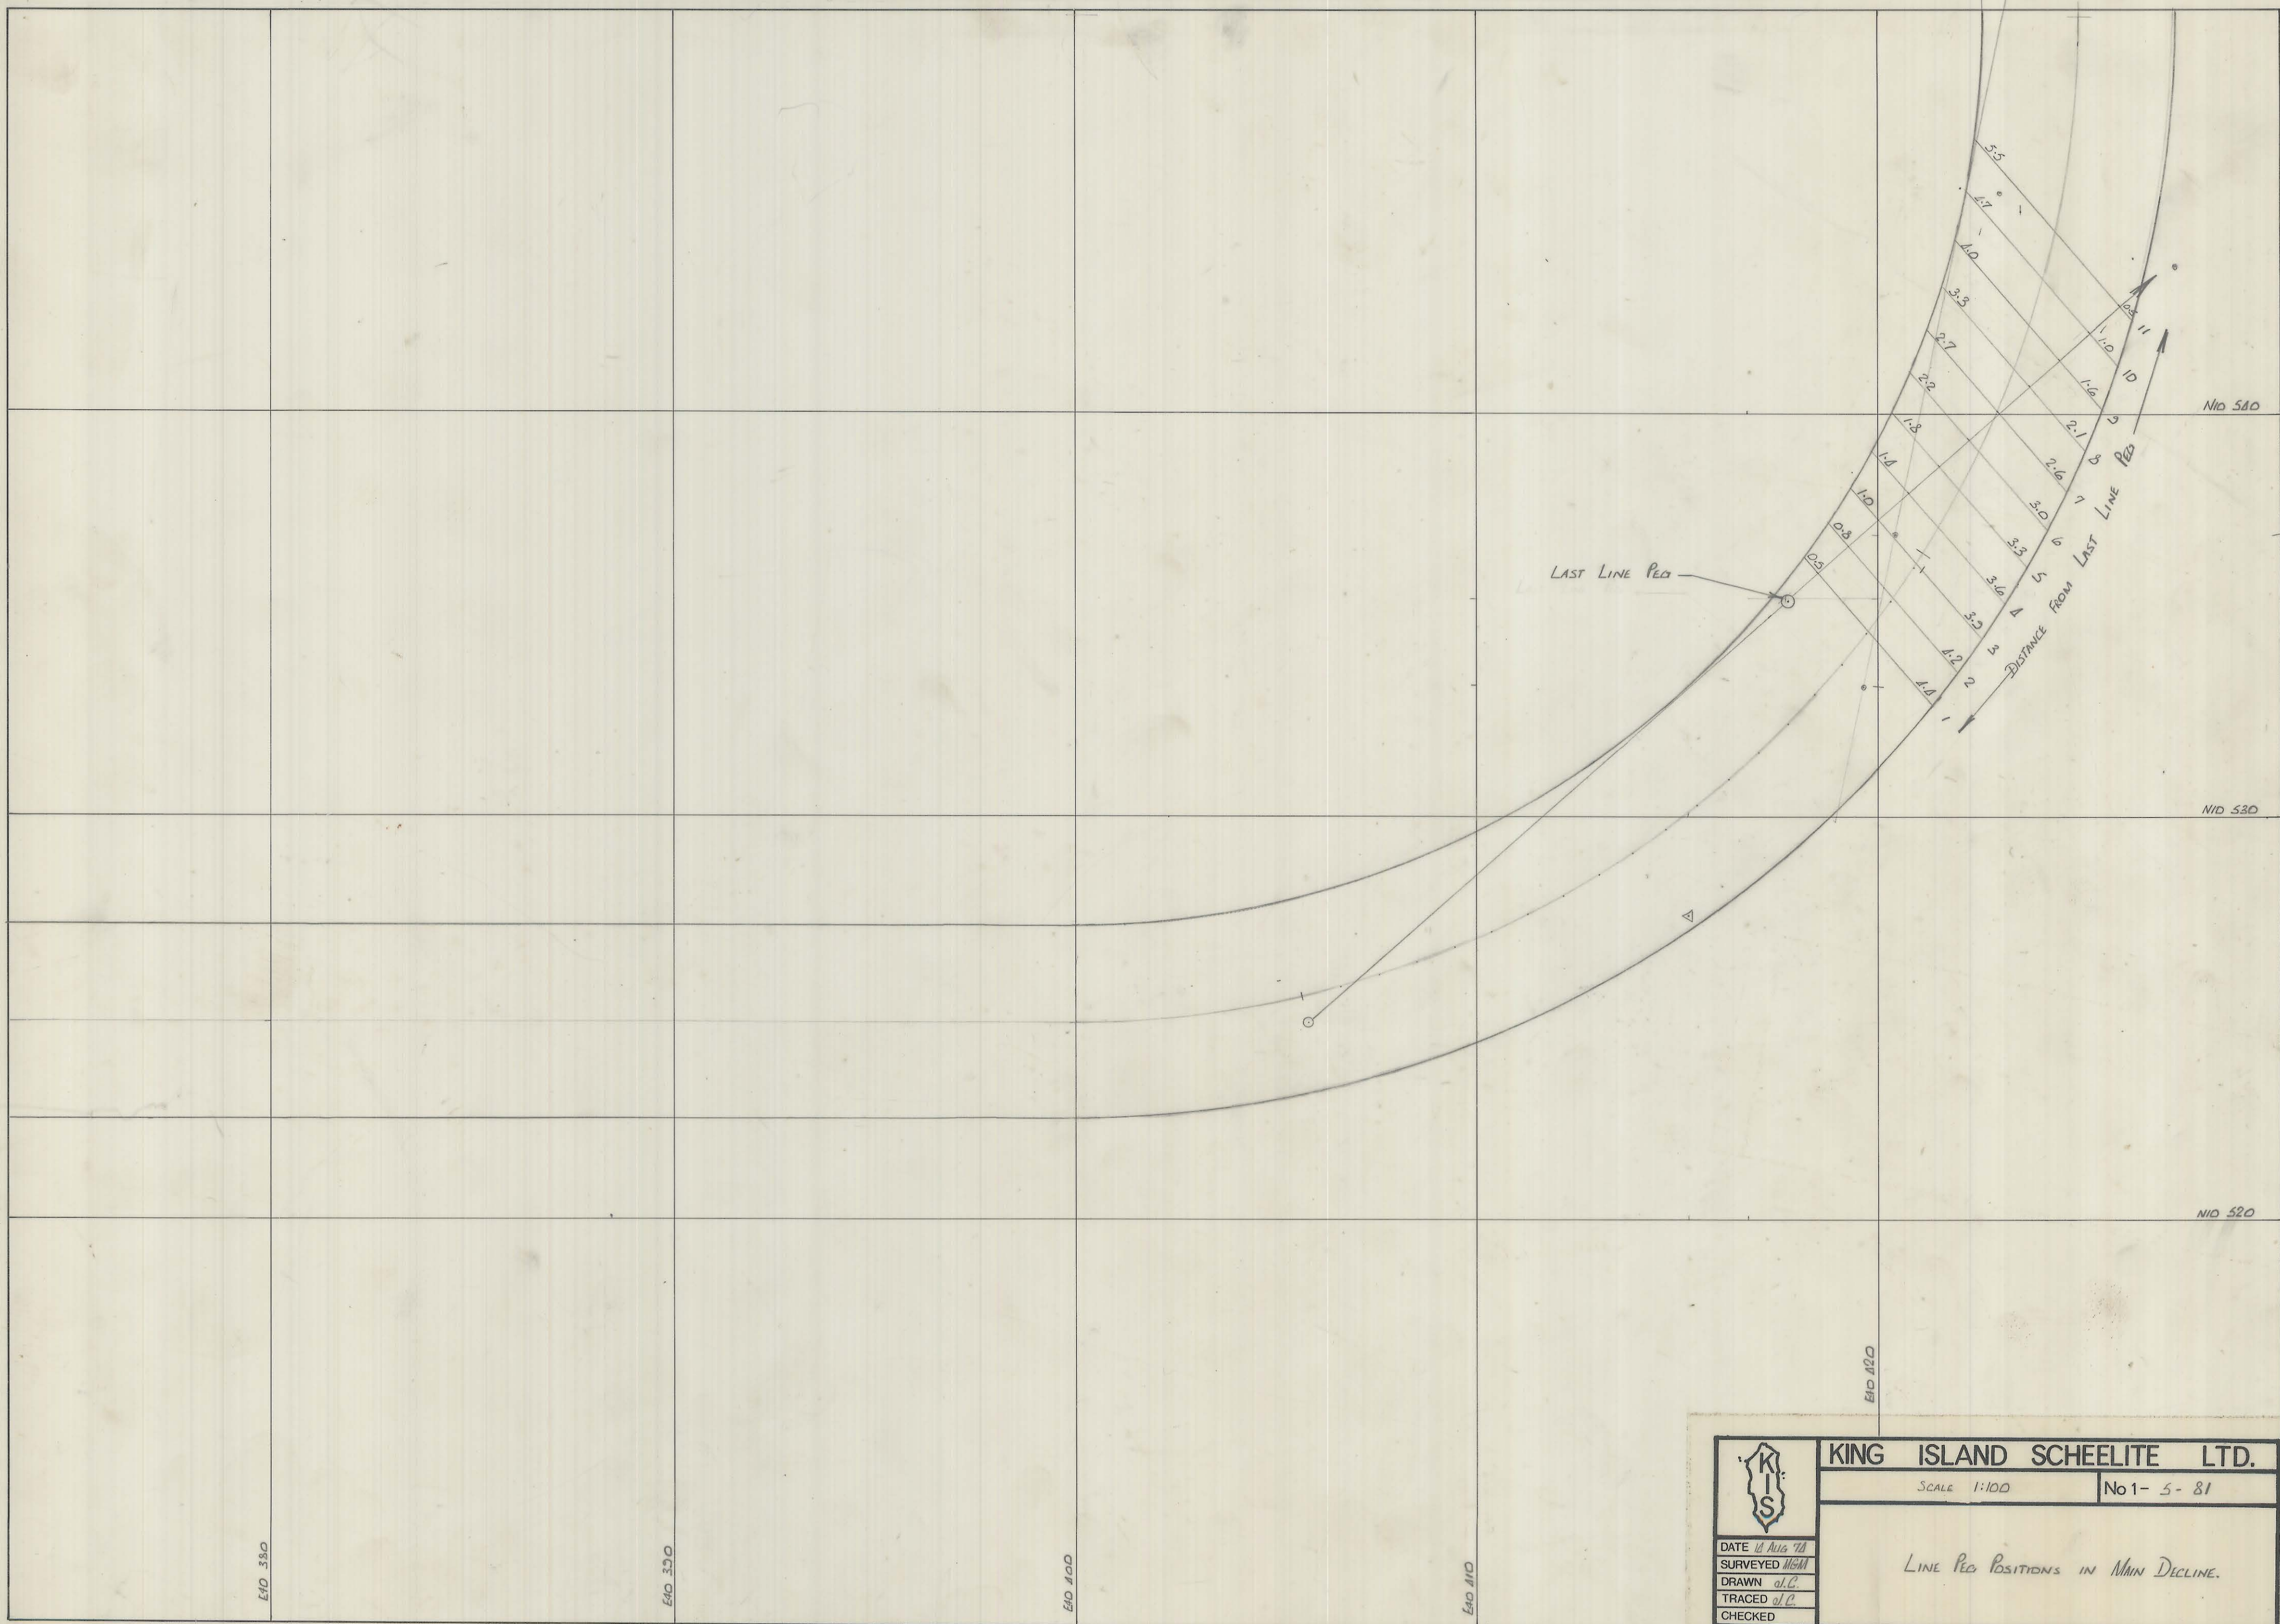

KING ISLAND SCHEELITE LTD.

SCALE 1:100

No 1- 5- 81

DATE 10 AUG 78
SURVEYED MCH 79
DRAWN A.L.C.
TRACED J.P.
CHECKED

LINE PED POSITIONS IN MAIN DECLINE.