


5 cm

04BH11-1002

0374_4160

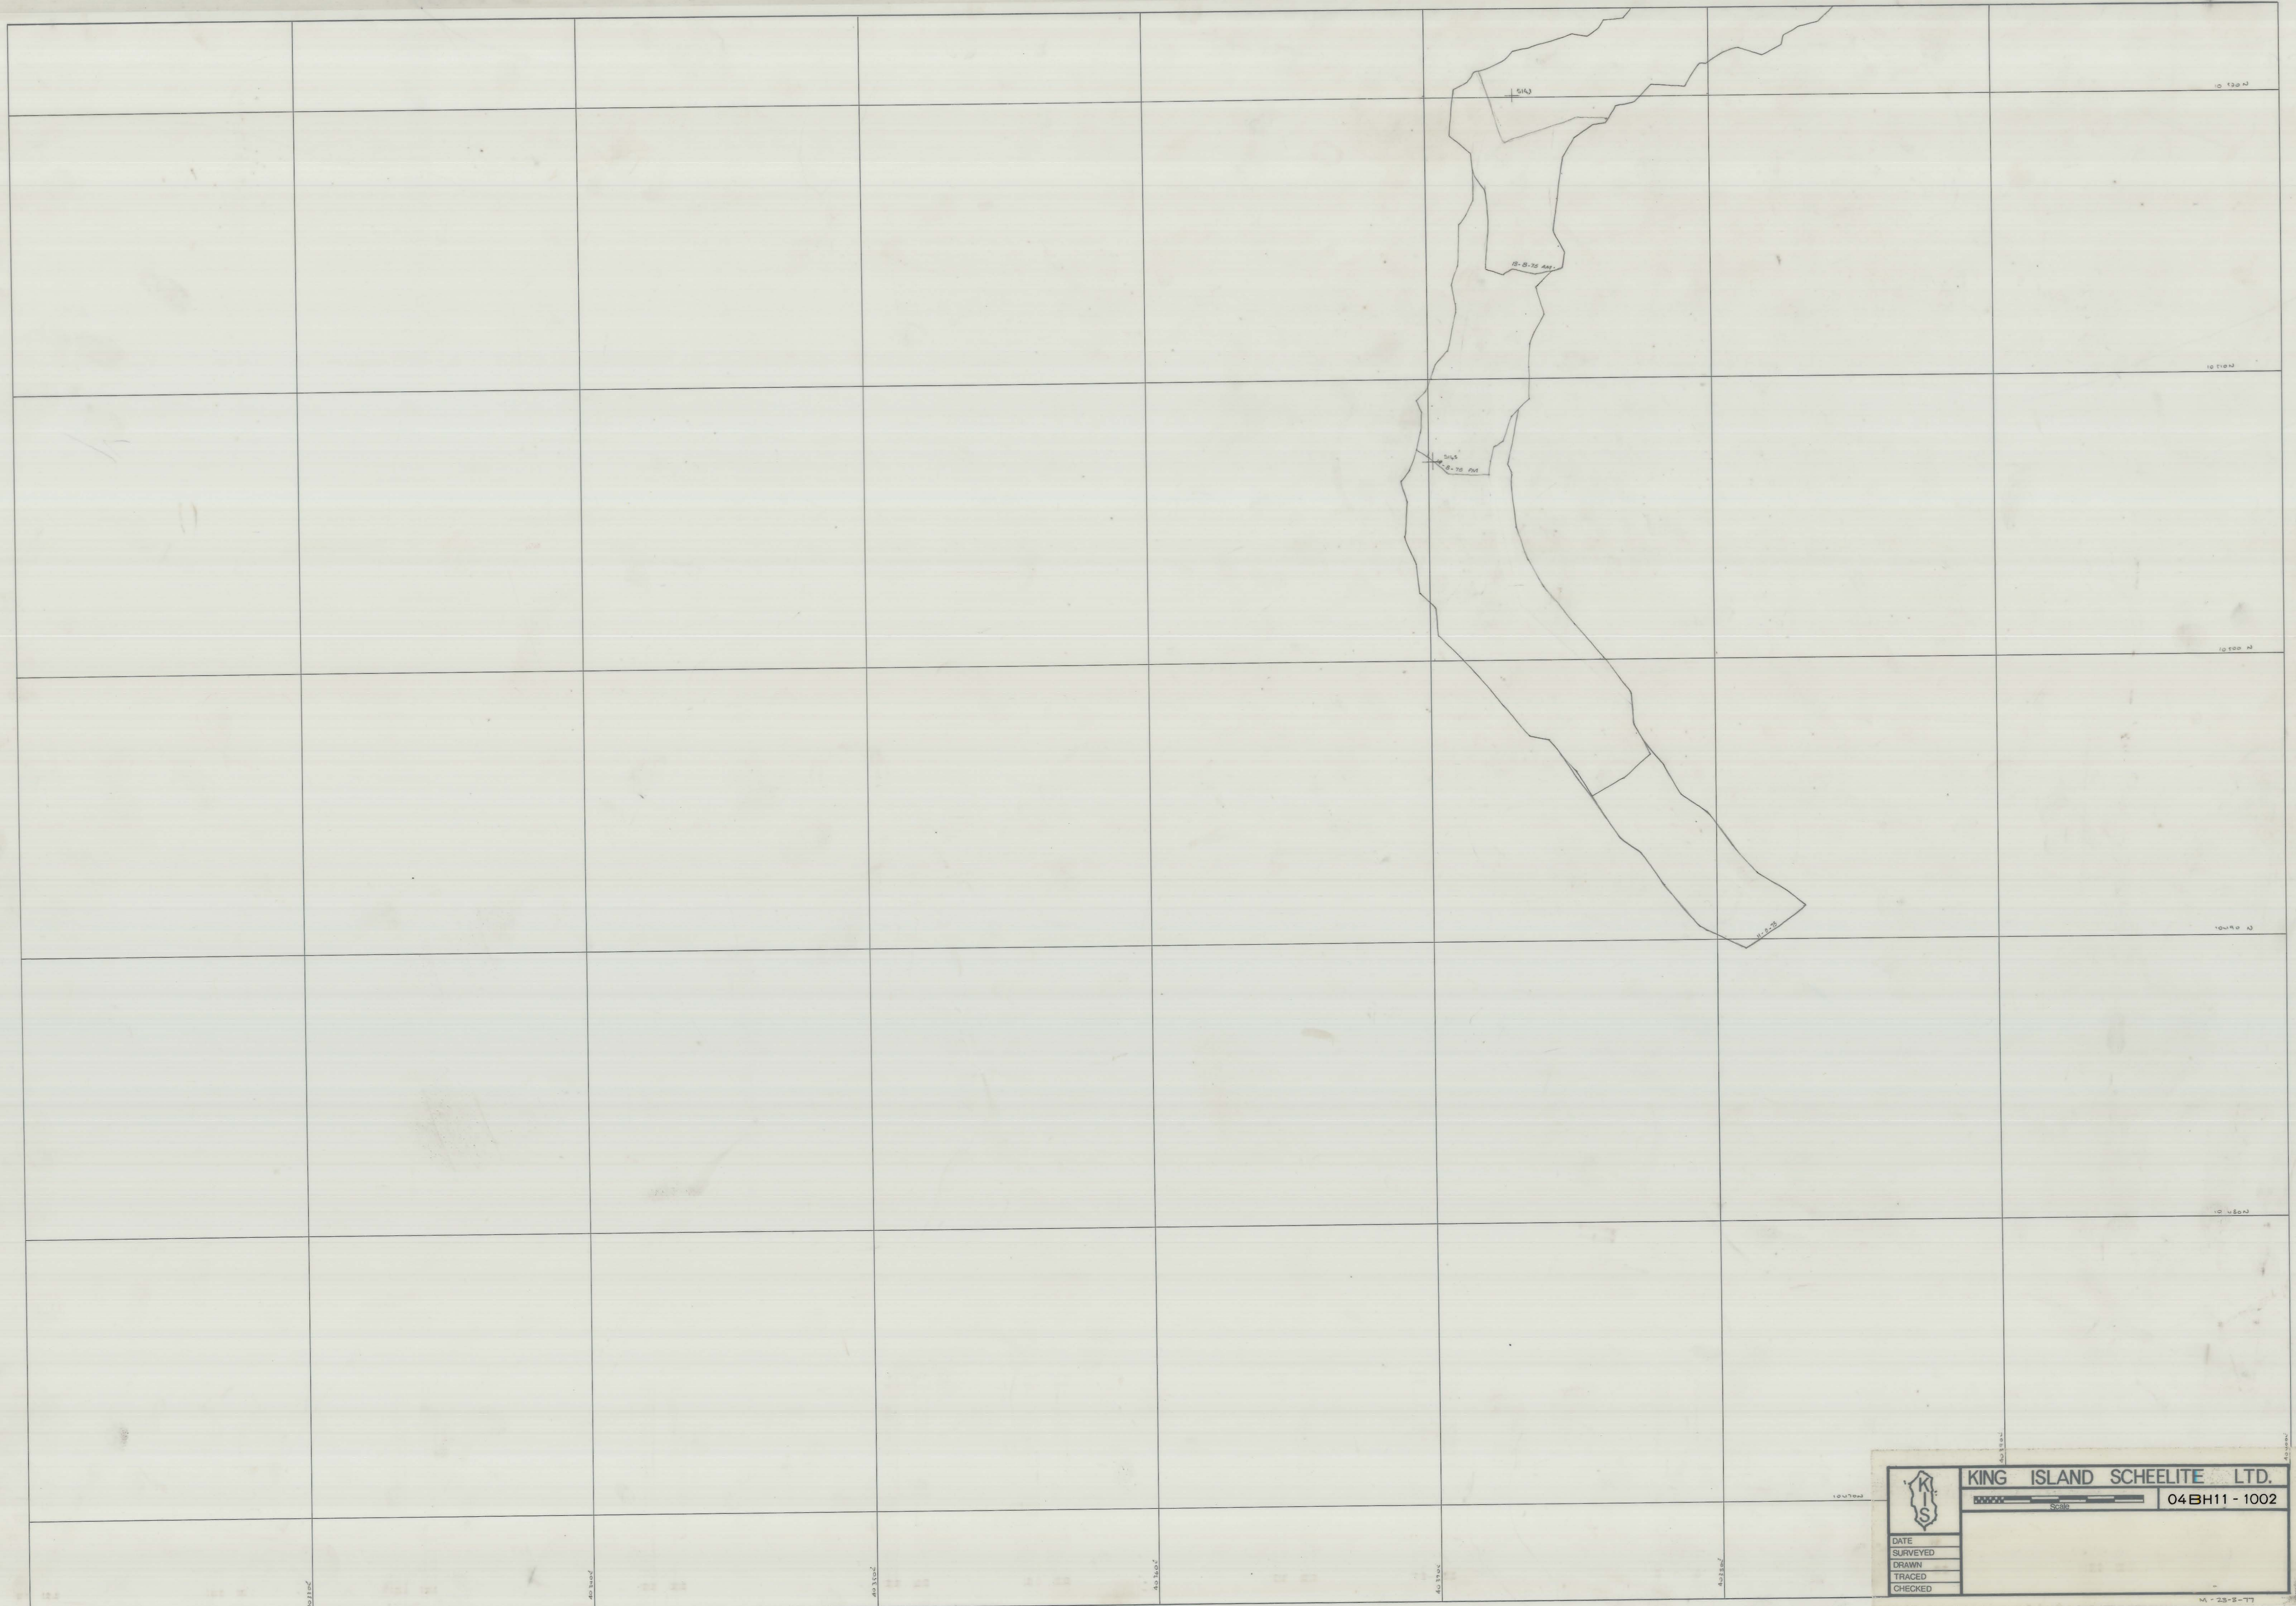

	KING ISLAND SCHEELITE LTD.	
	04BH11 - 1002	
	DATE	
	SURVEYED	
	DRAWN	
TRACED		
CHECKED		