


5 cm

04 BH11 - 1004

0374_4162



SCALE 1: 100	north	LOCATION	BOLD HEAD	
		SUBJECT		

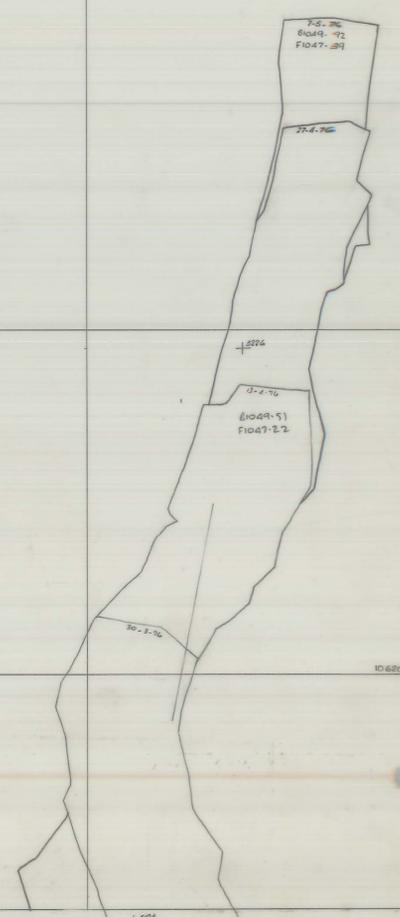

10620 N.

11-23-8-11