


5 cm

04 BH11-1005

0374-4163

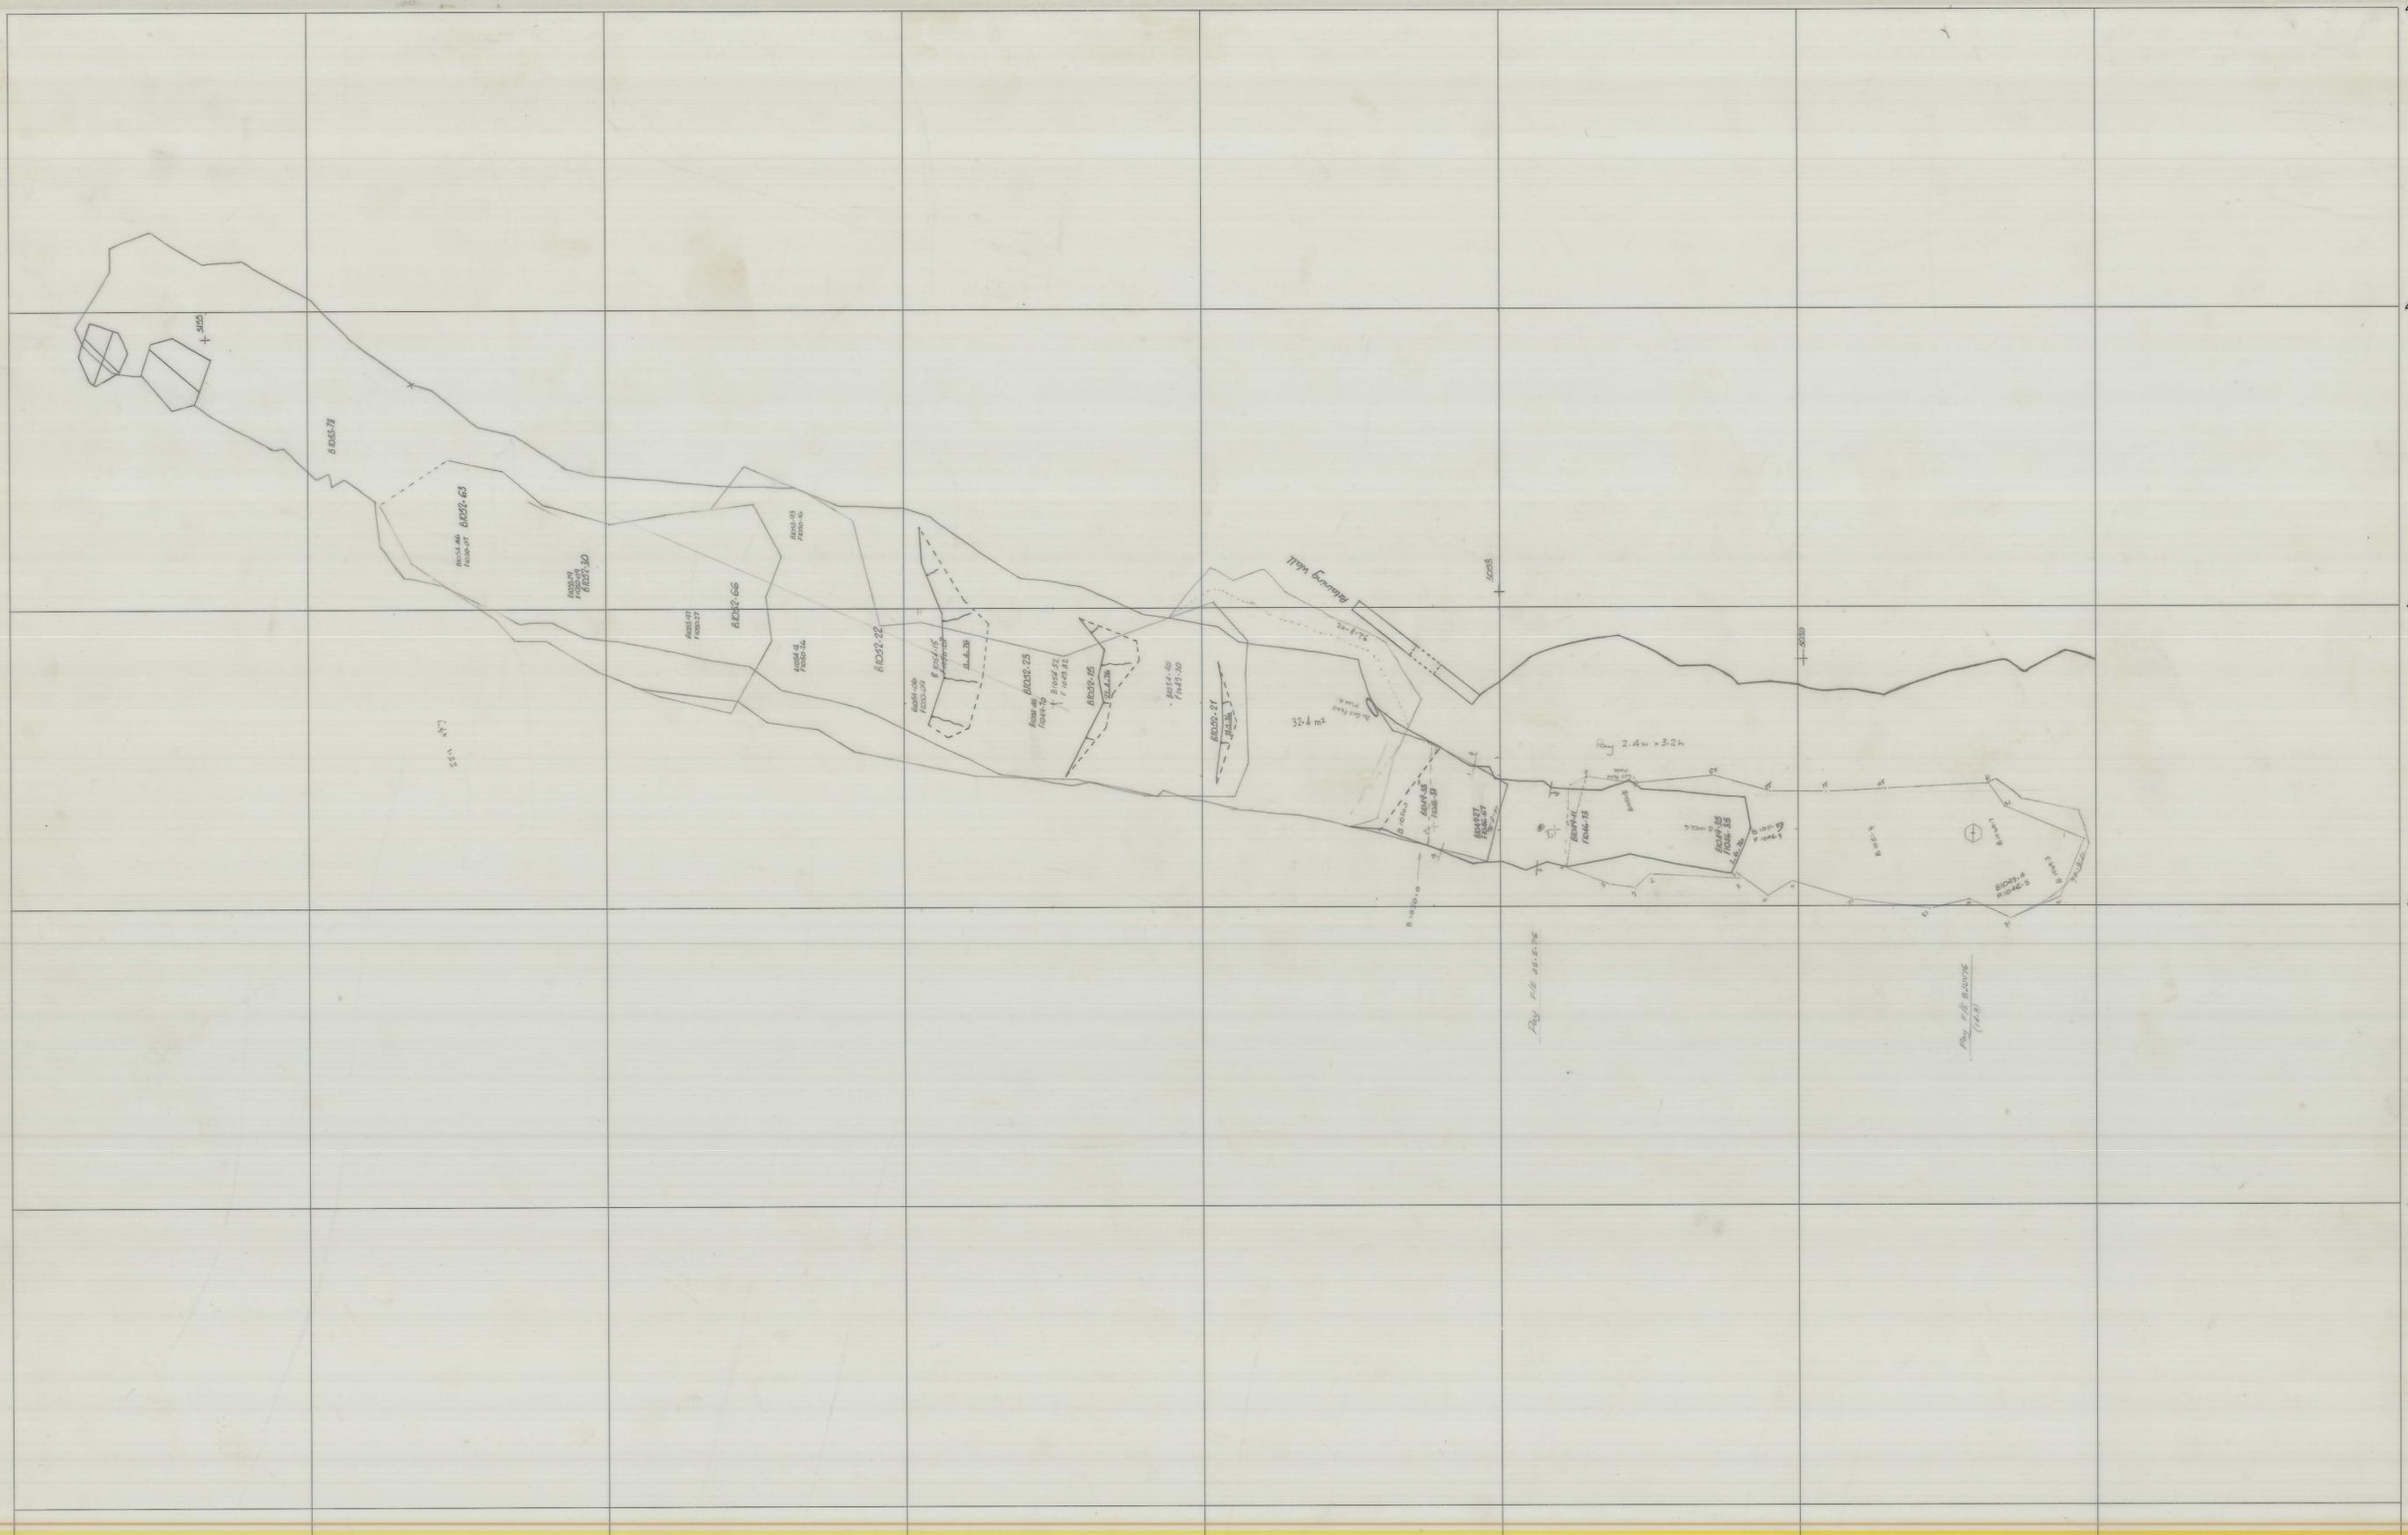

KING ISLAND SCHEELITE		APPROVAL		COPY
DATE:	SCALE: 1:100	PLANNING ENG.:		
MINE: BOLD HEAD	DWG/NO.: 04BH11-1005	SENIOR PLAN. ENG.:		
H50 STOPE		MINE SUPT.:		
		G. MINING SUPT.:		
		SENIOR SURV'R.:		
		SENIOR GEOLOGIST:		
		SURVEYOR:		
PRELIMINARY	FINAL			

N10560 N10550 N10540 N10530 N10520 N10510 N10500 N10490

40300E 40310E 40320E 40330E 40340E 40350E

M - 23-3-77