


04BH11-1014

0374_4171

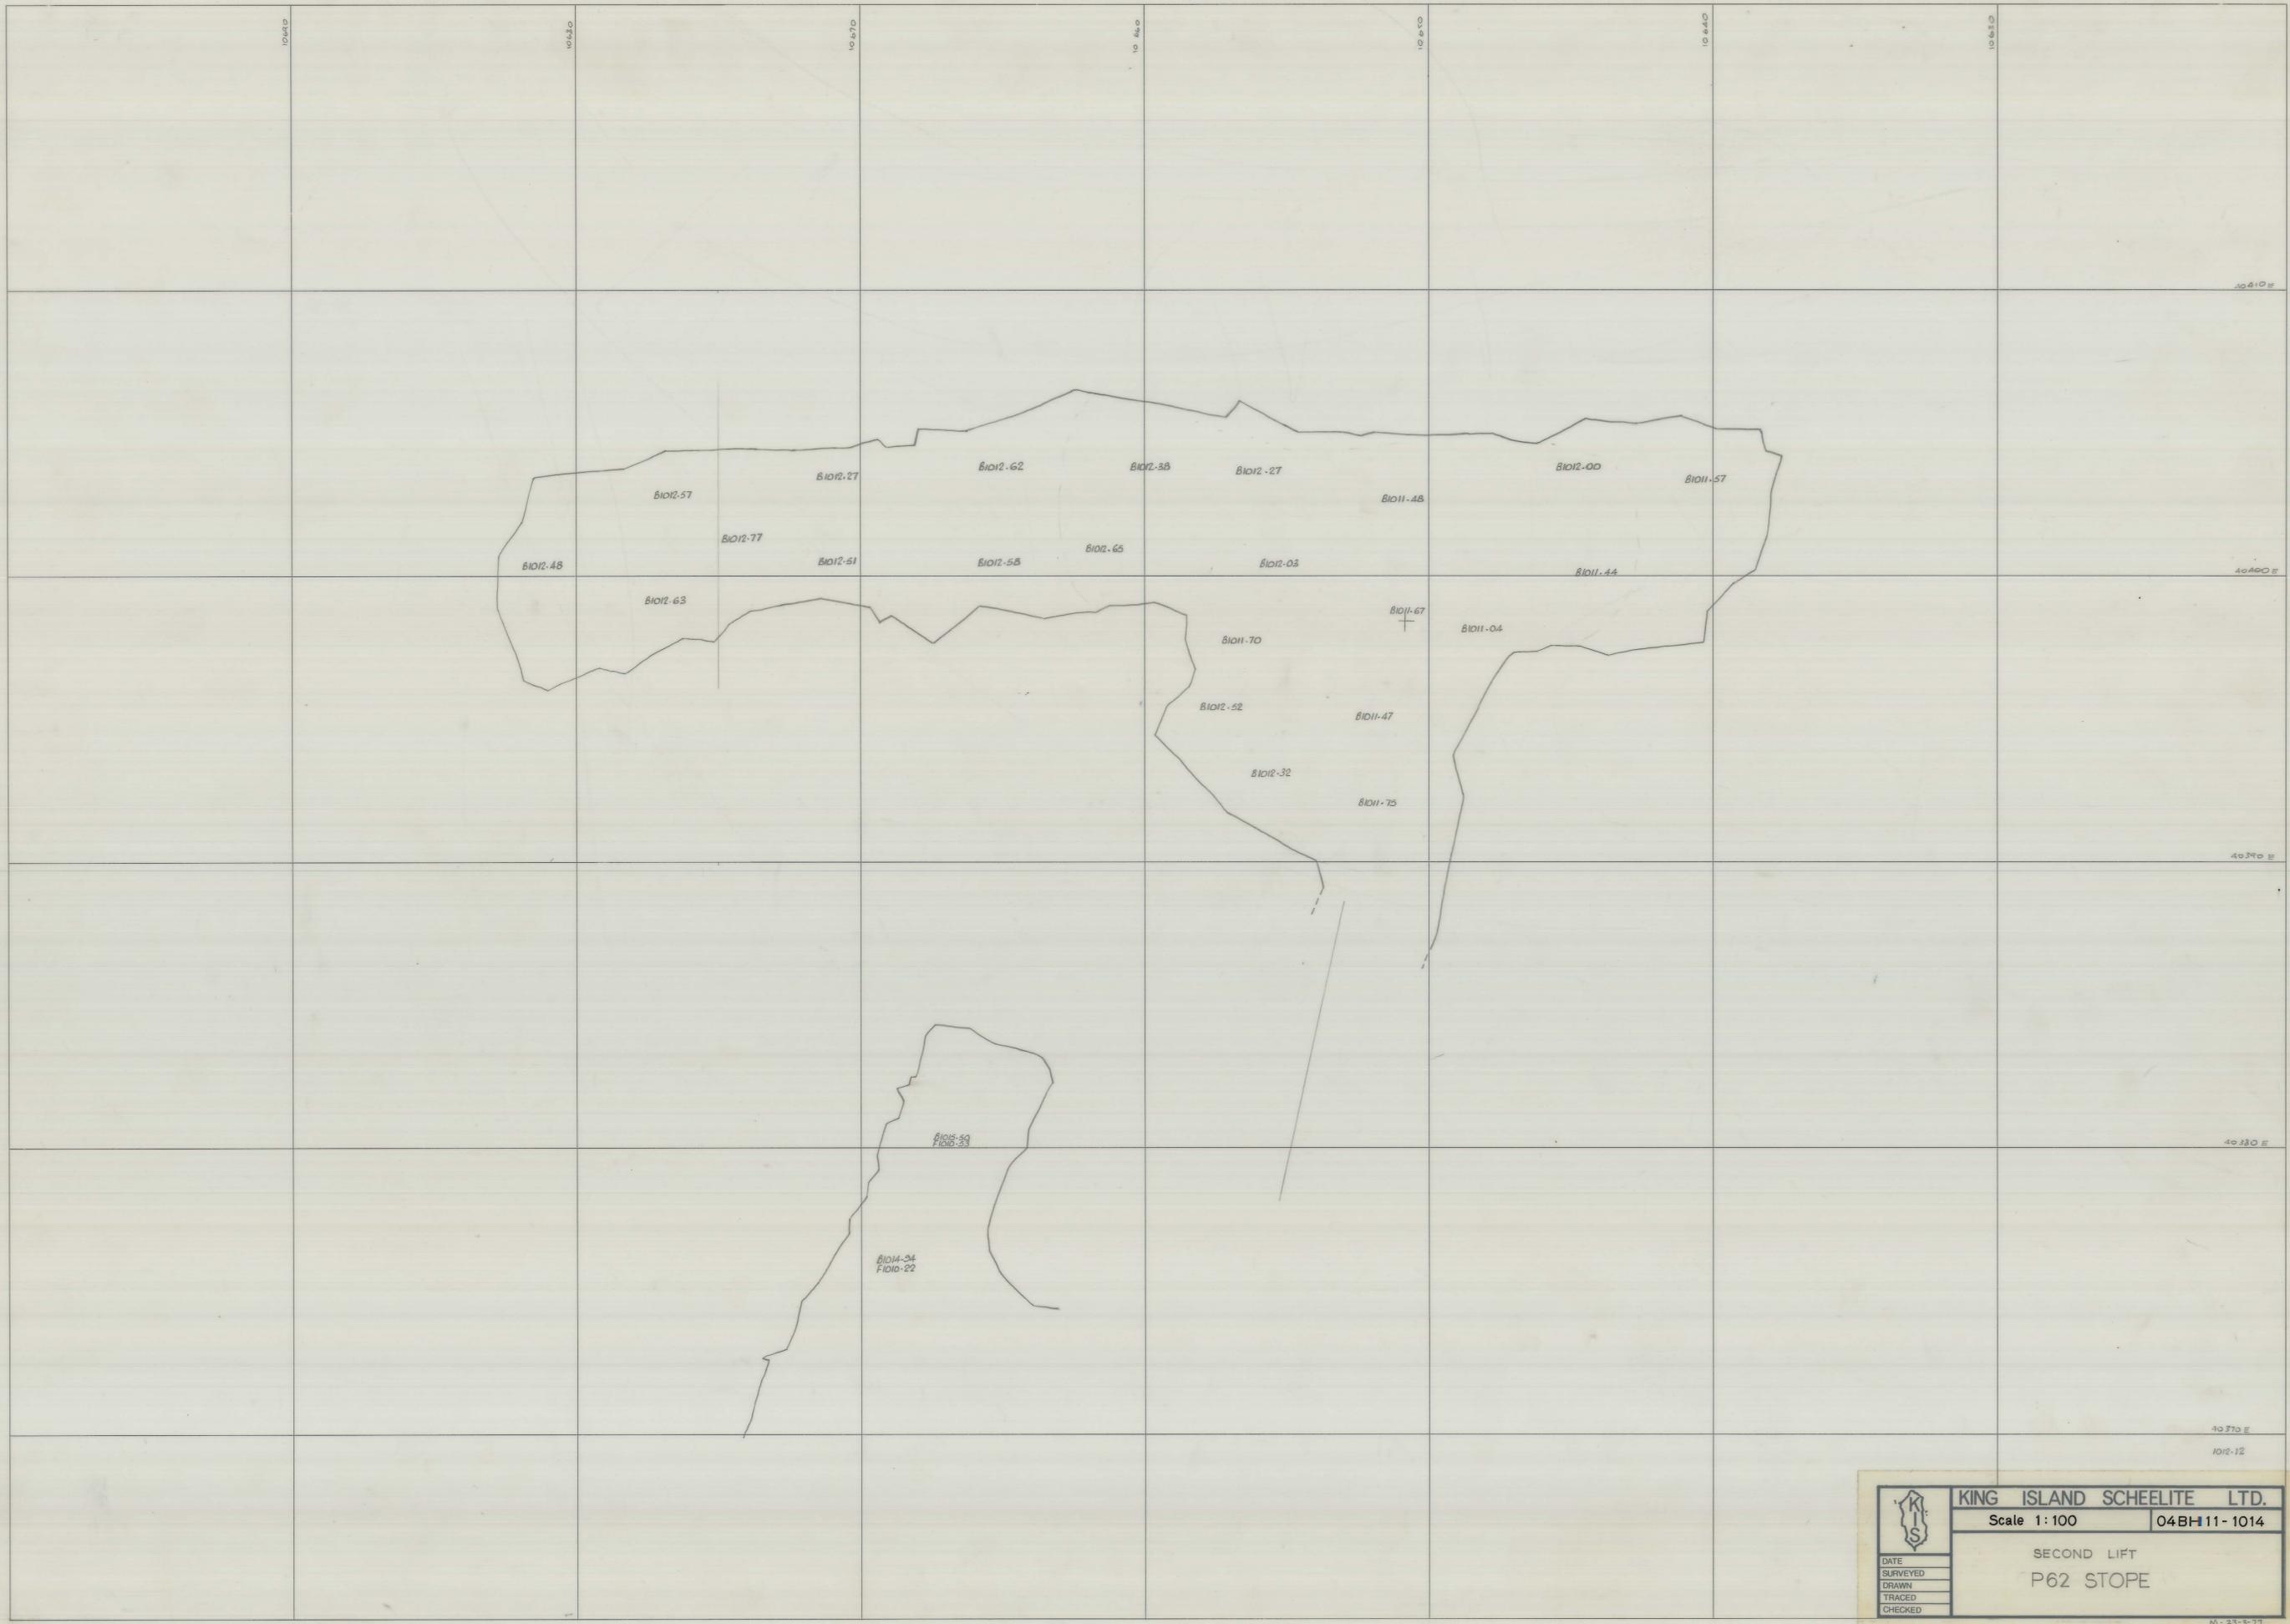

	KING ISLAND SCHEELITE LTD.	
	Scale 1:100	04BH11-1014
	SECOND LIFT	
	P62 STOPE	