


5 cm

04 BH 11 - 1017

0374_4174

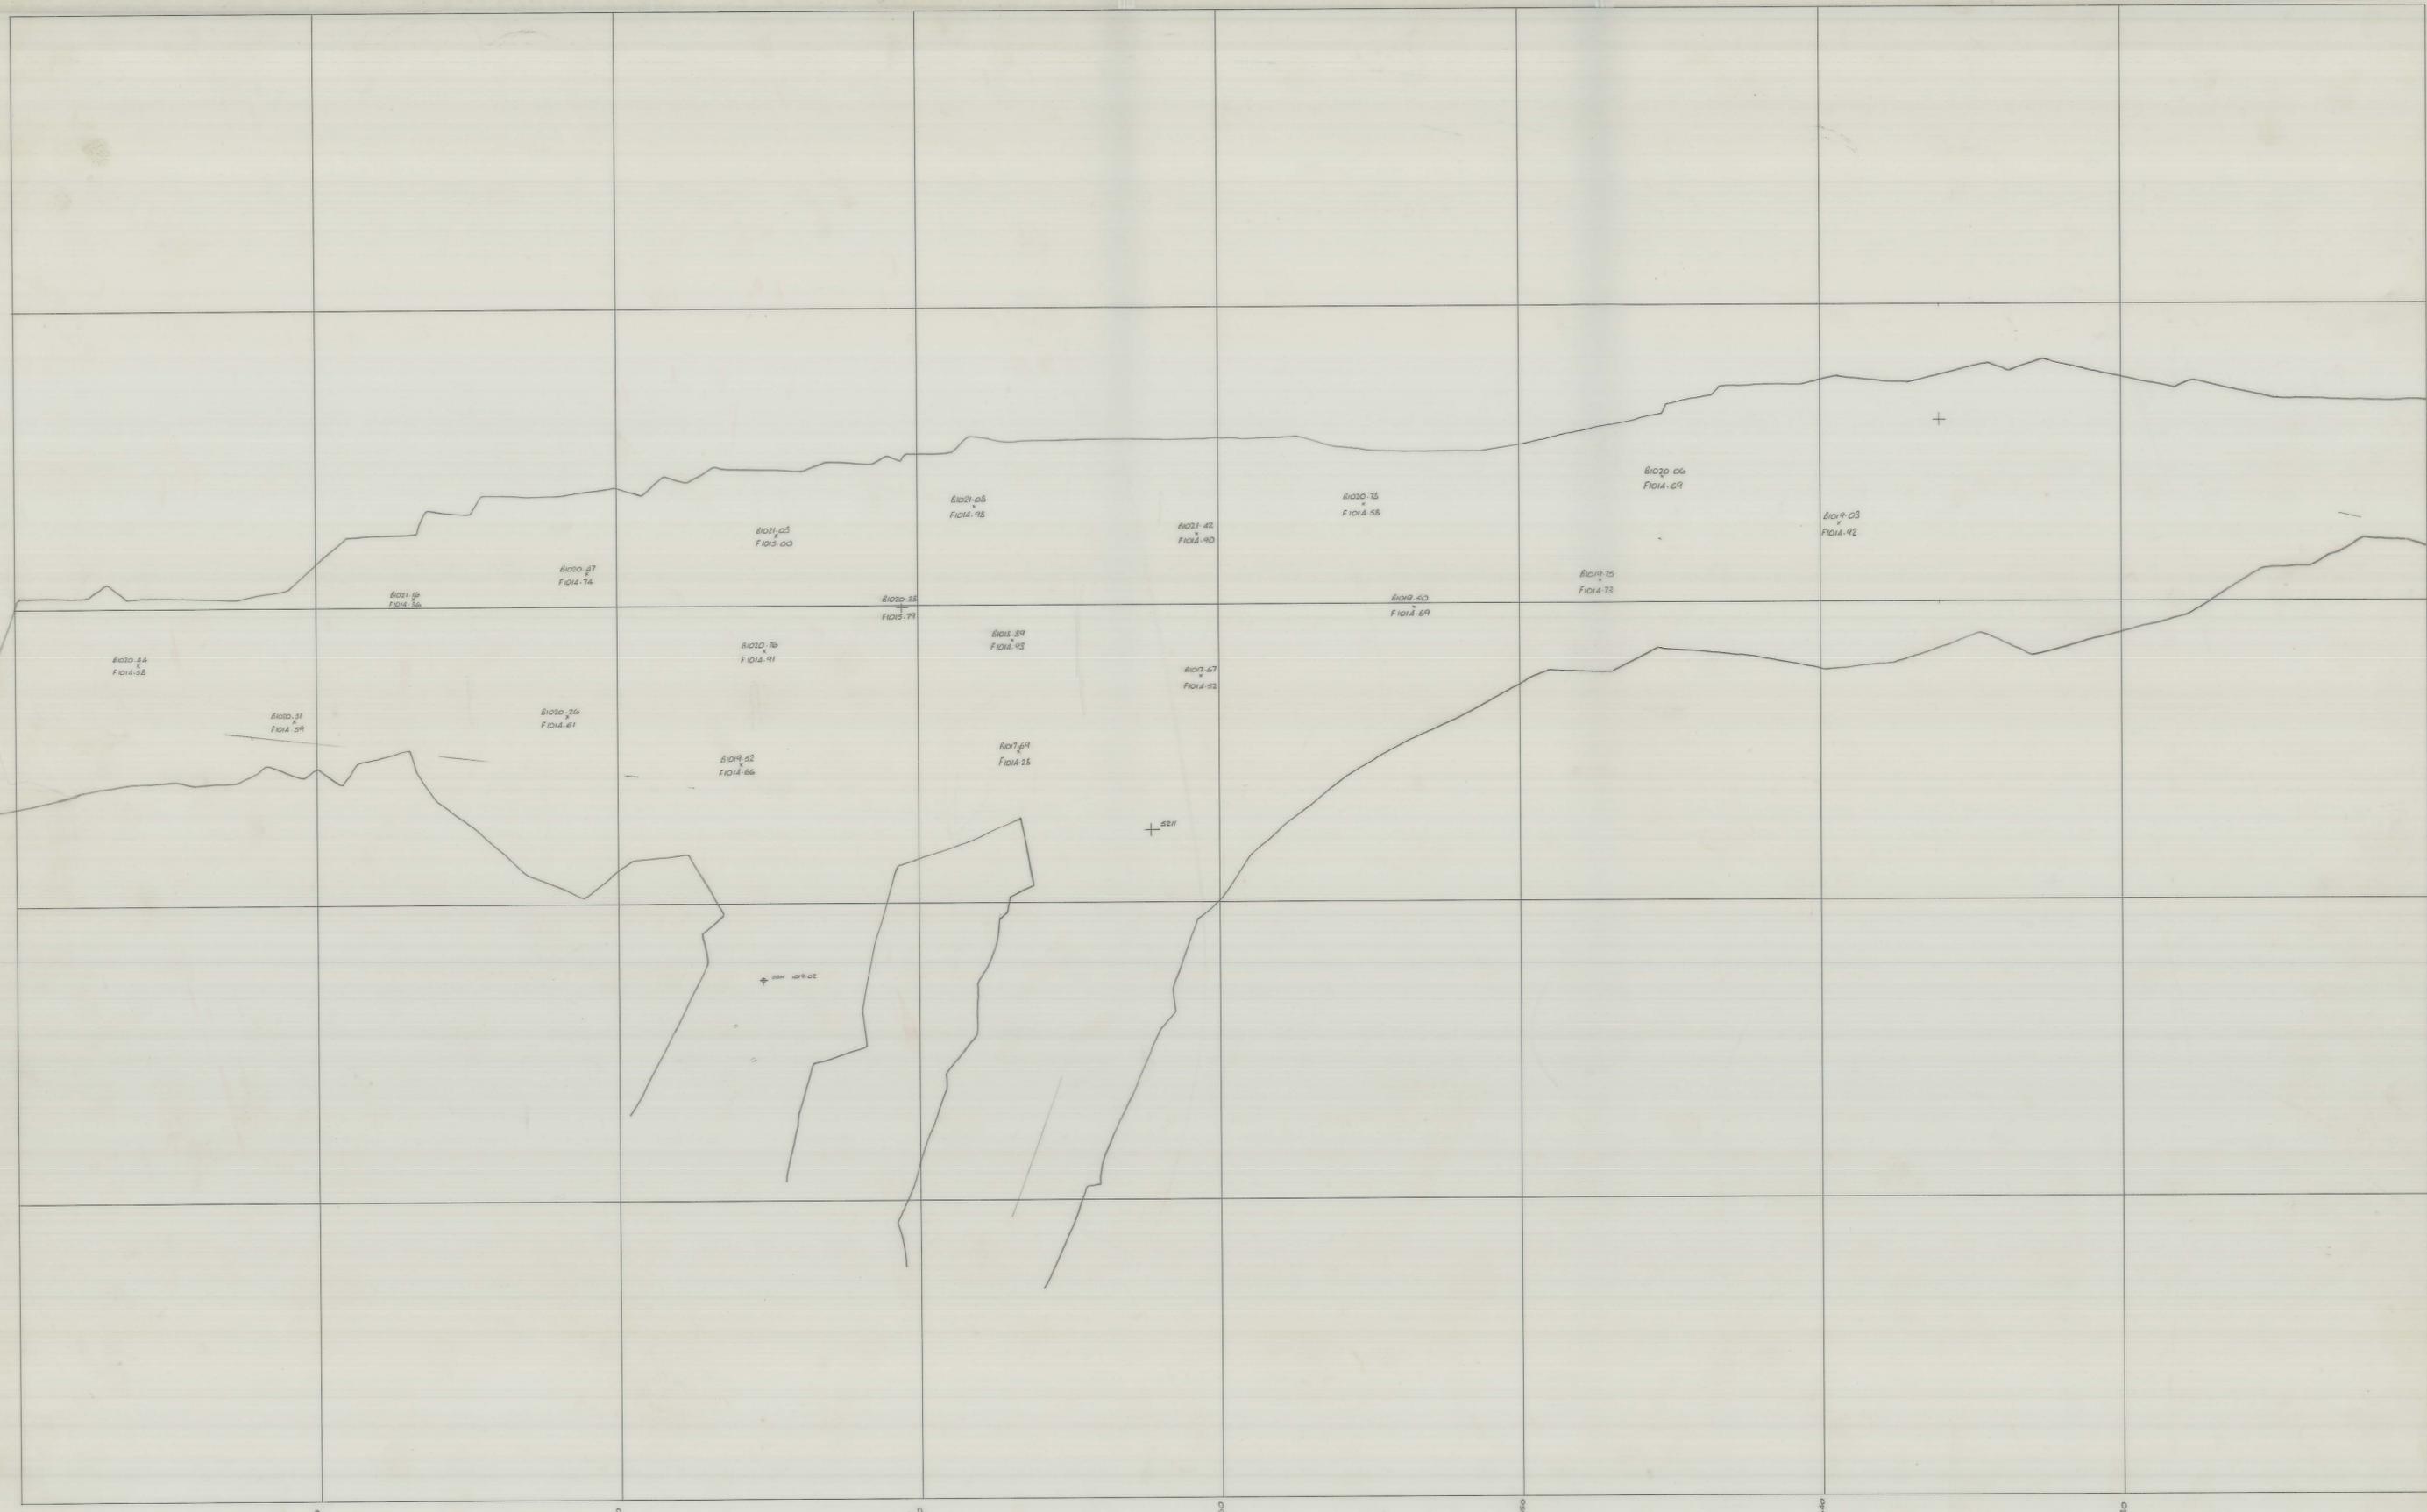

N10 640 N10 650 N10 660 N10 670 N10 680 N10 690 N10 700 N10 710
 E10 380 E10 390 E10 400 E10 410

SCALE 1:100	north	LOCATION	BOLD HEAD	 KING ISLAND SCHEELITE A DIVISION OF WARMAN INTERNATIONAL GRASSY KING ISLAND PLAN NUMBER 04BH11 - 1017
		SUBJECT	FIFTH LIFT P 62 STOPE	