


5 cm

CA BH 11 - 1018

0374-4175

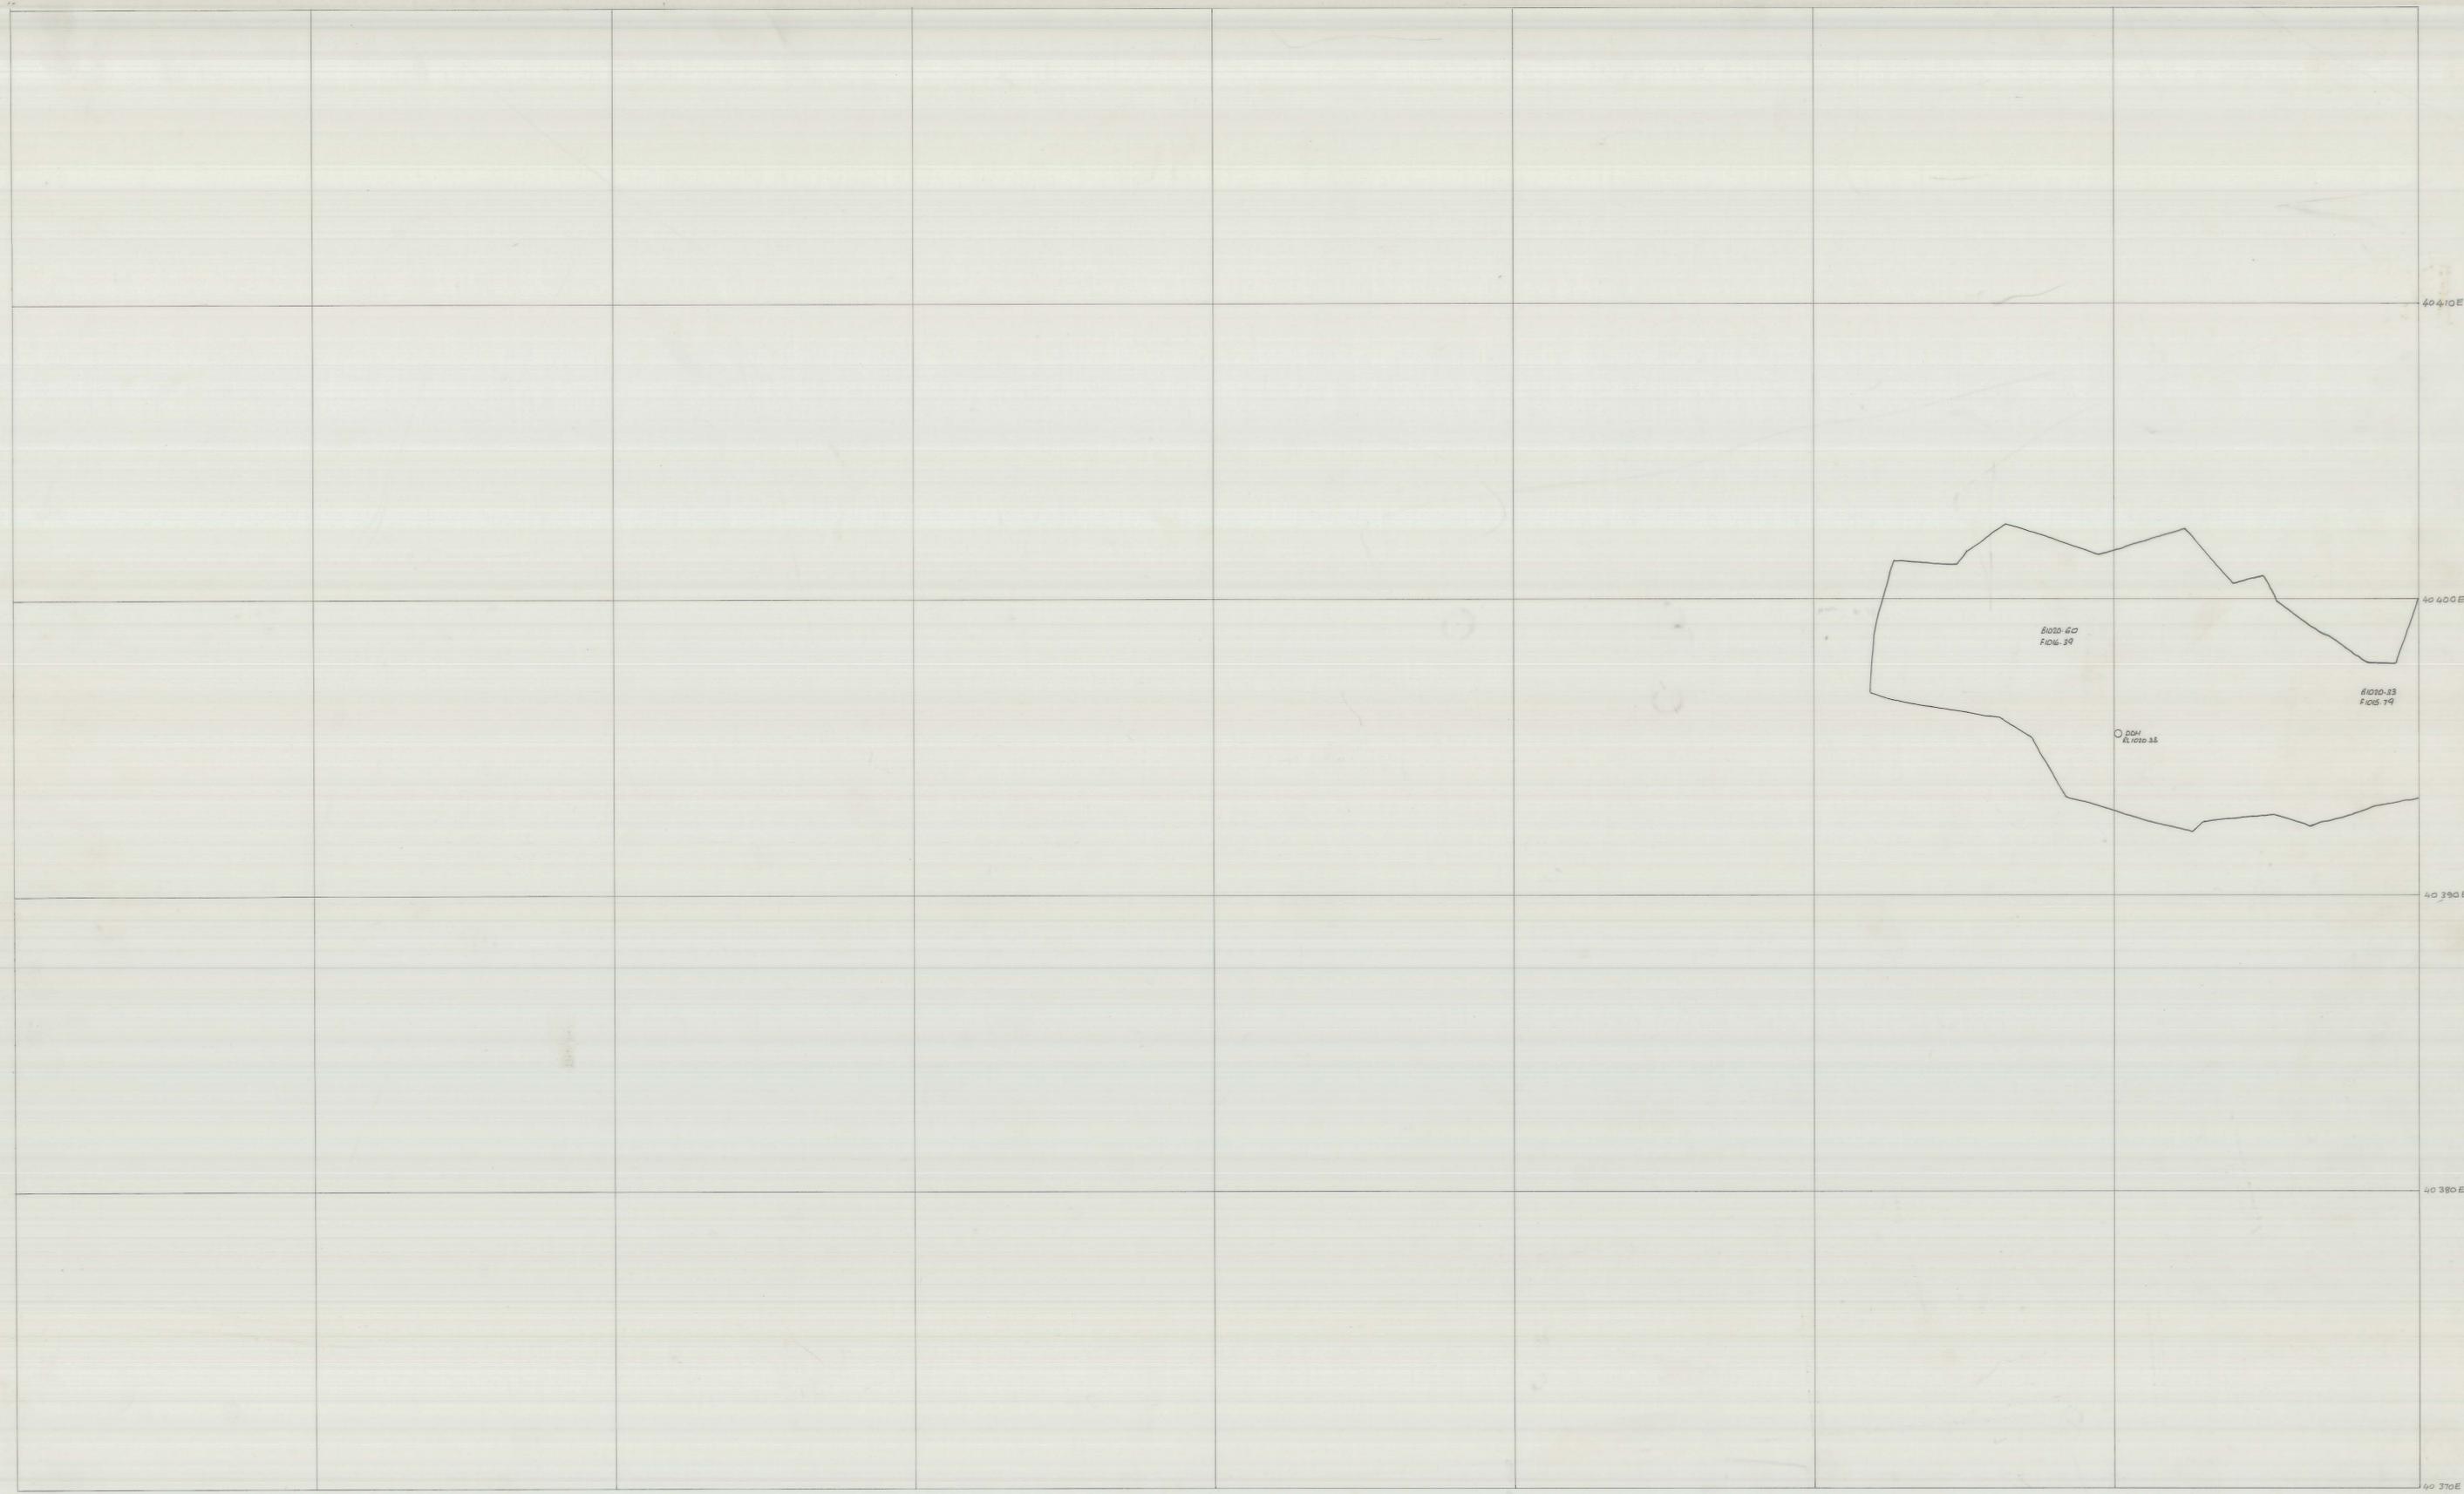

	<p>SCALE 1:100</p>	<p>north</p>	<p>LOCATION BOLD HEAD</p> <p>SUBJECT FIFTH LIFT P 62 STOPE</p>	<p>1016-5 LIFT</p> <p><b>KIS</b> KING ISLAND SCHEELITE A DIVISION OF WARMAN INTERNATIONAL</p> <p>GRASSY KING ISLAND</p> <p>PLAN NUMBER 04BH11 - 1018</p>
--	--------------------	--------------	--	--