


0374_4181

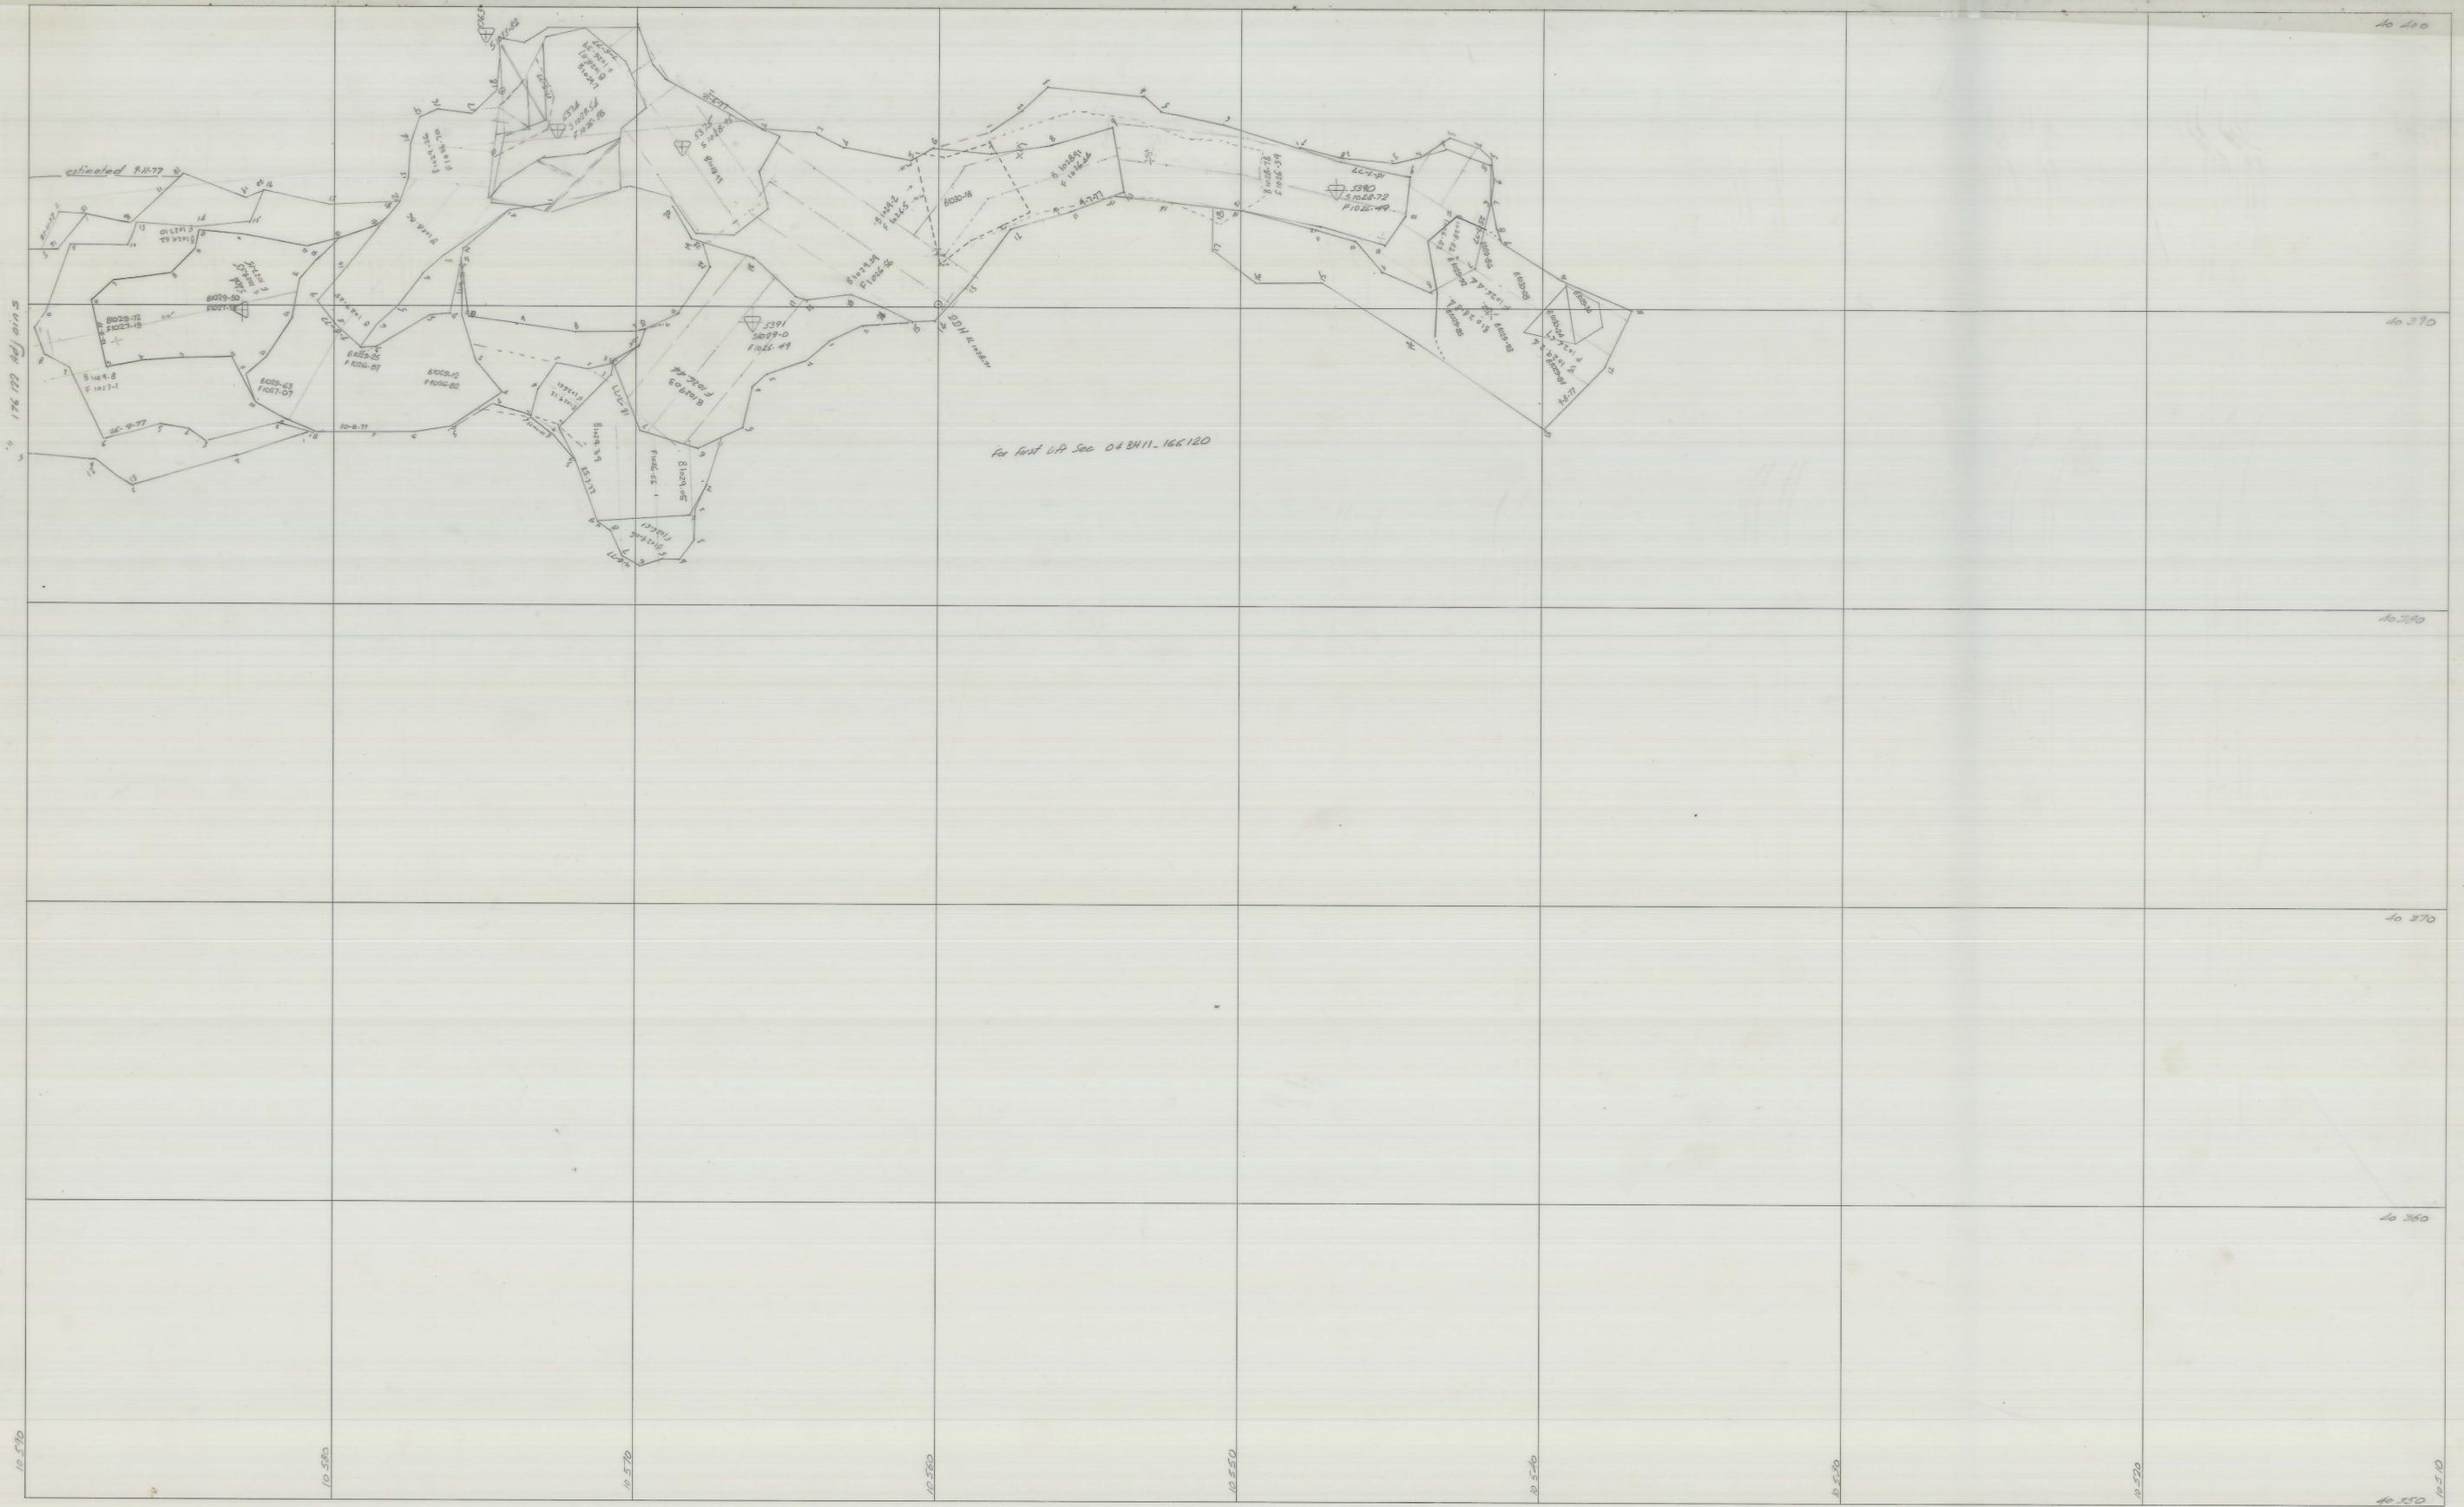

10.570

10.580

10.590

10.600

10.610

10.620

10.630

10.640

10.650

SCALE 1:100



north

LOCATION

BOLD HEAD MINE

SUBJECT

P57 STOPE



GRASSY KING ISLAND

PLAN NUMBER

04 BH 11-1