


5 cm

0374_4184

043411 1A1 224

043

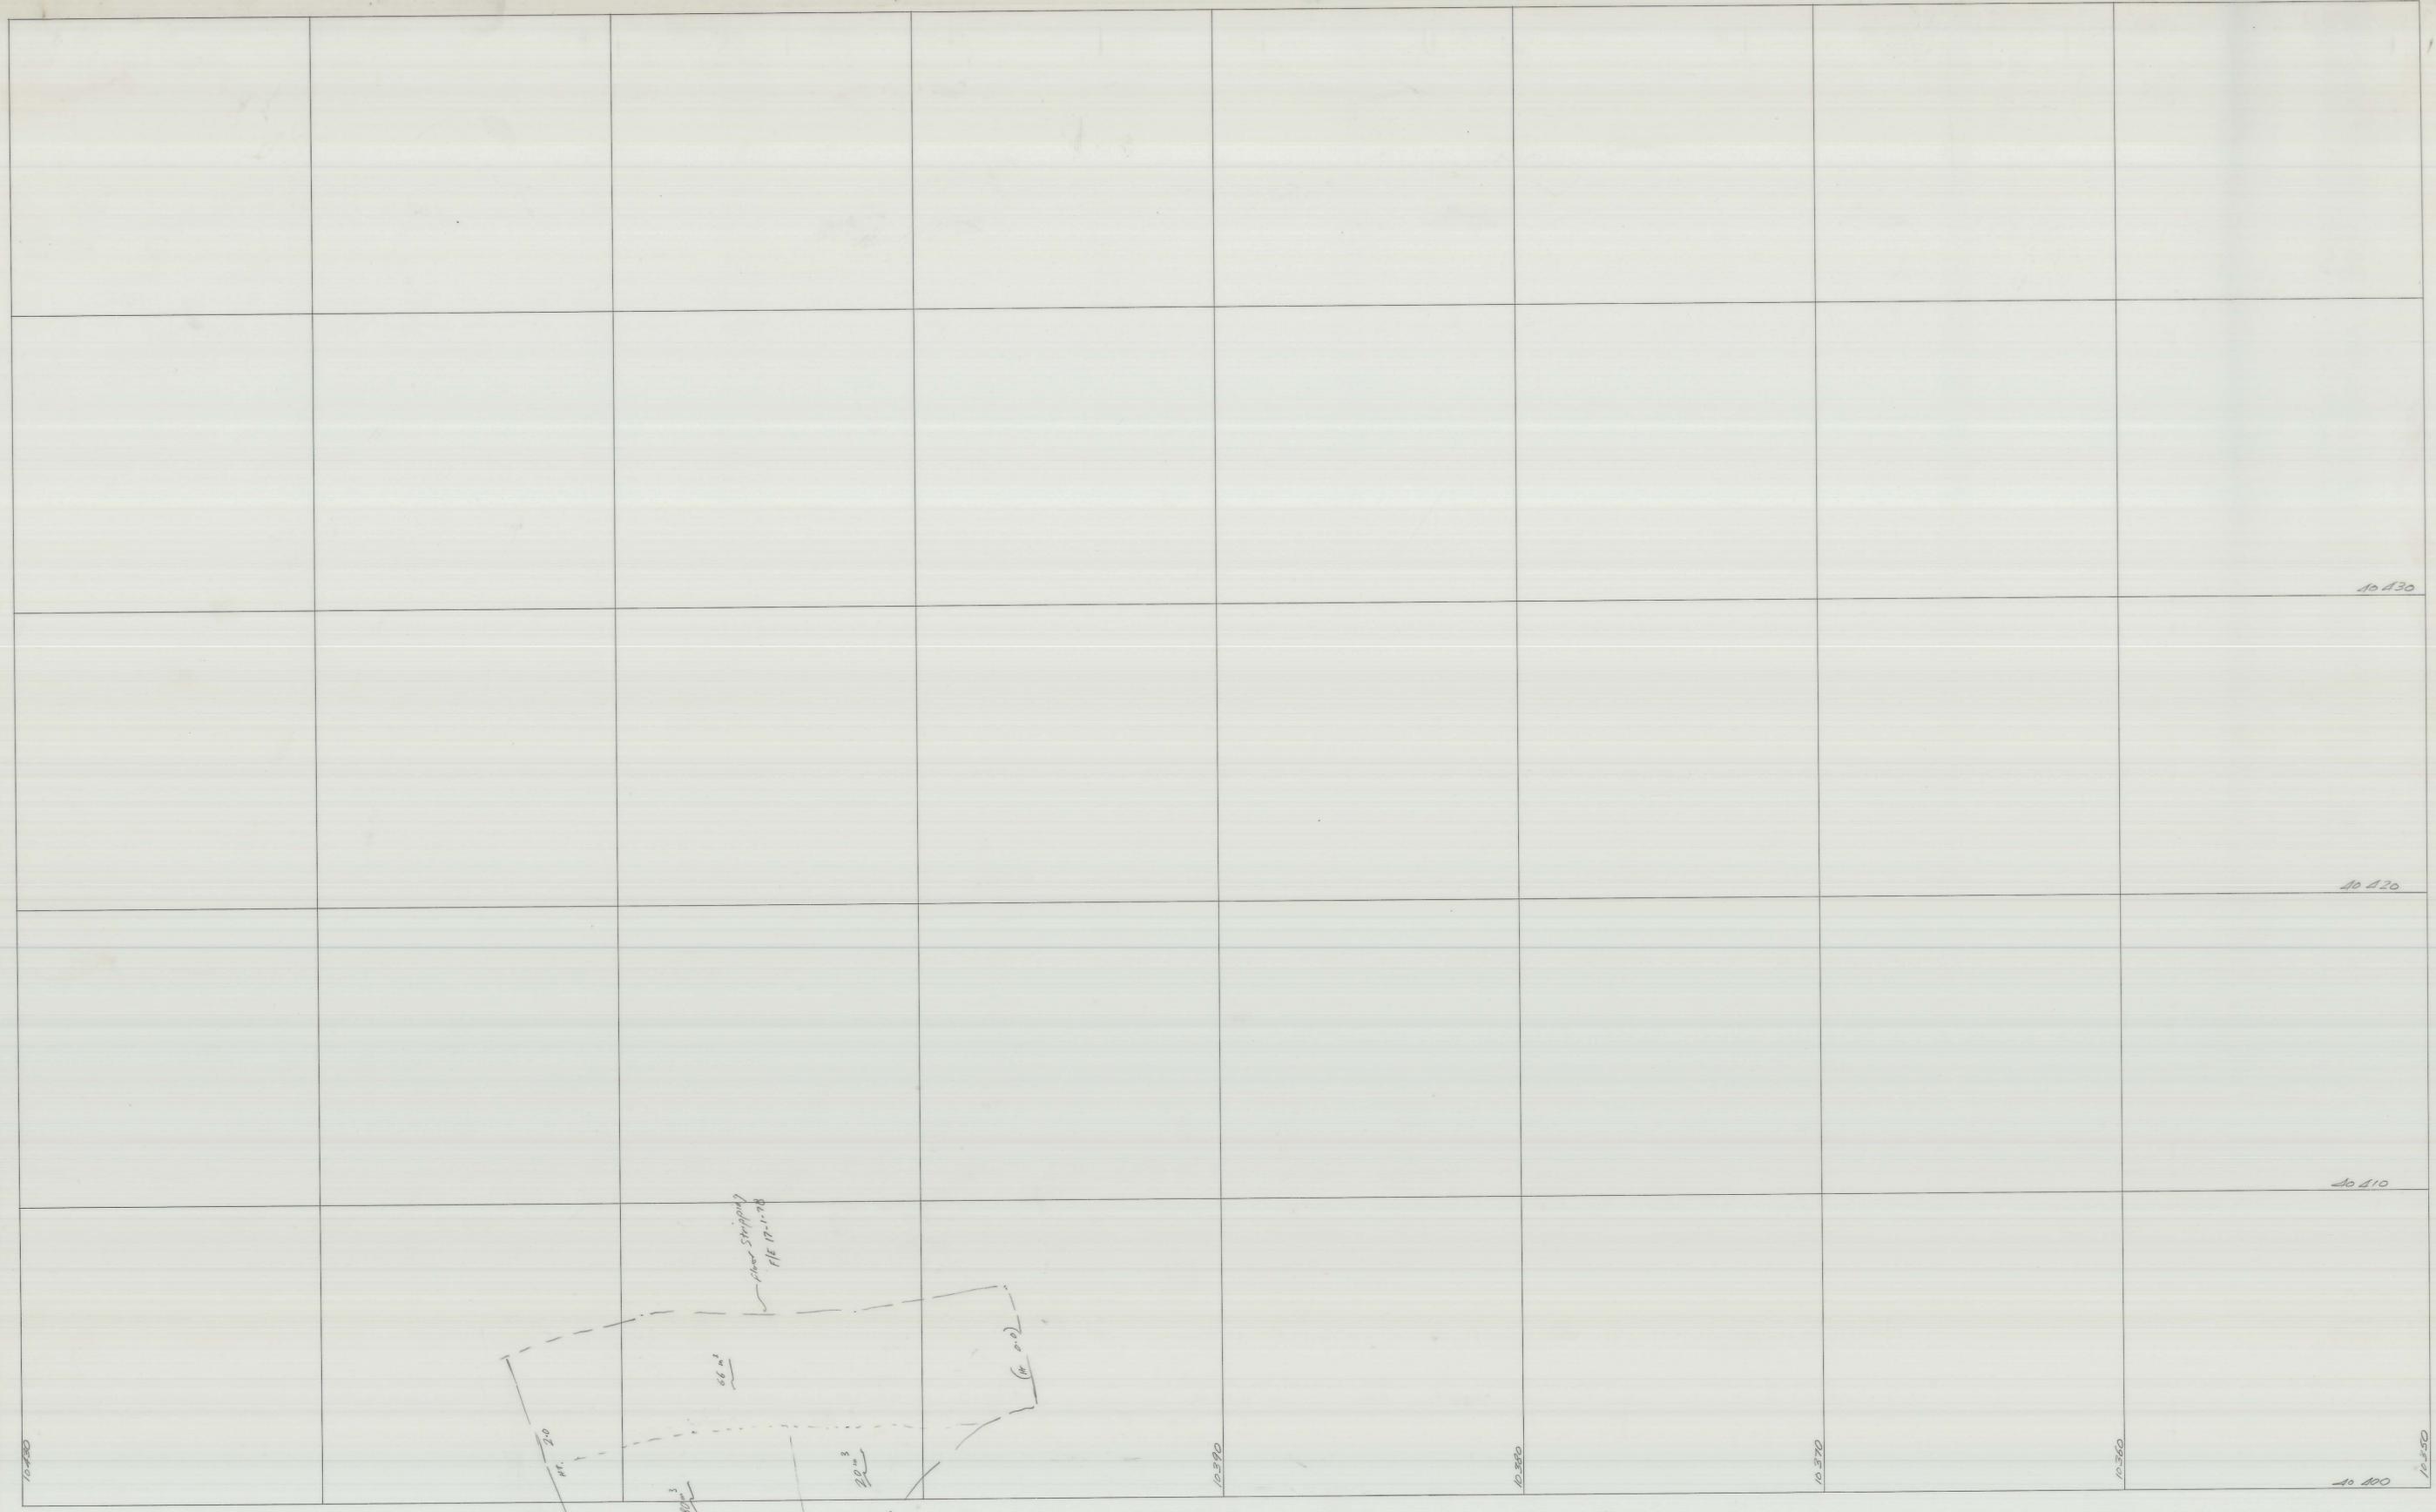

SCALE 1:100

LOCATION

SUBJECT

043 Floor Stripping

north



GRASSY KING ISLAND

PLAN NUMBER

043411-1A1 224