




0374_4186

04 BH 11 156 214

R 47
0 16
0 47

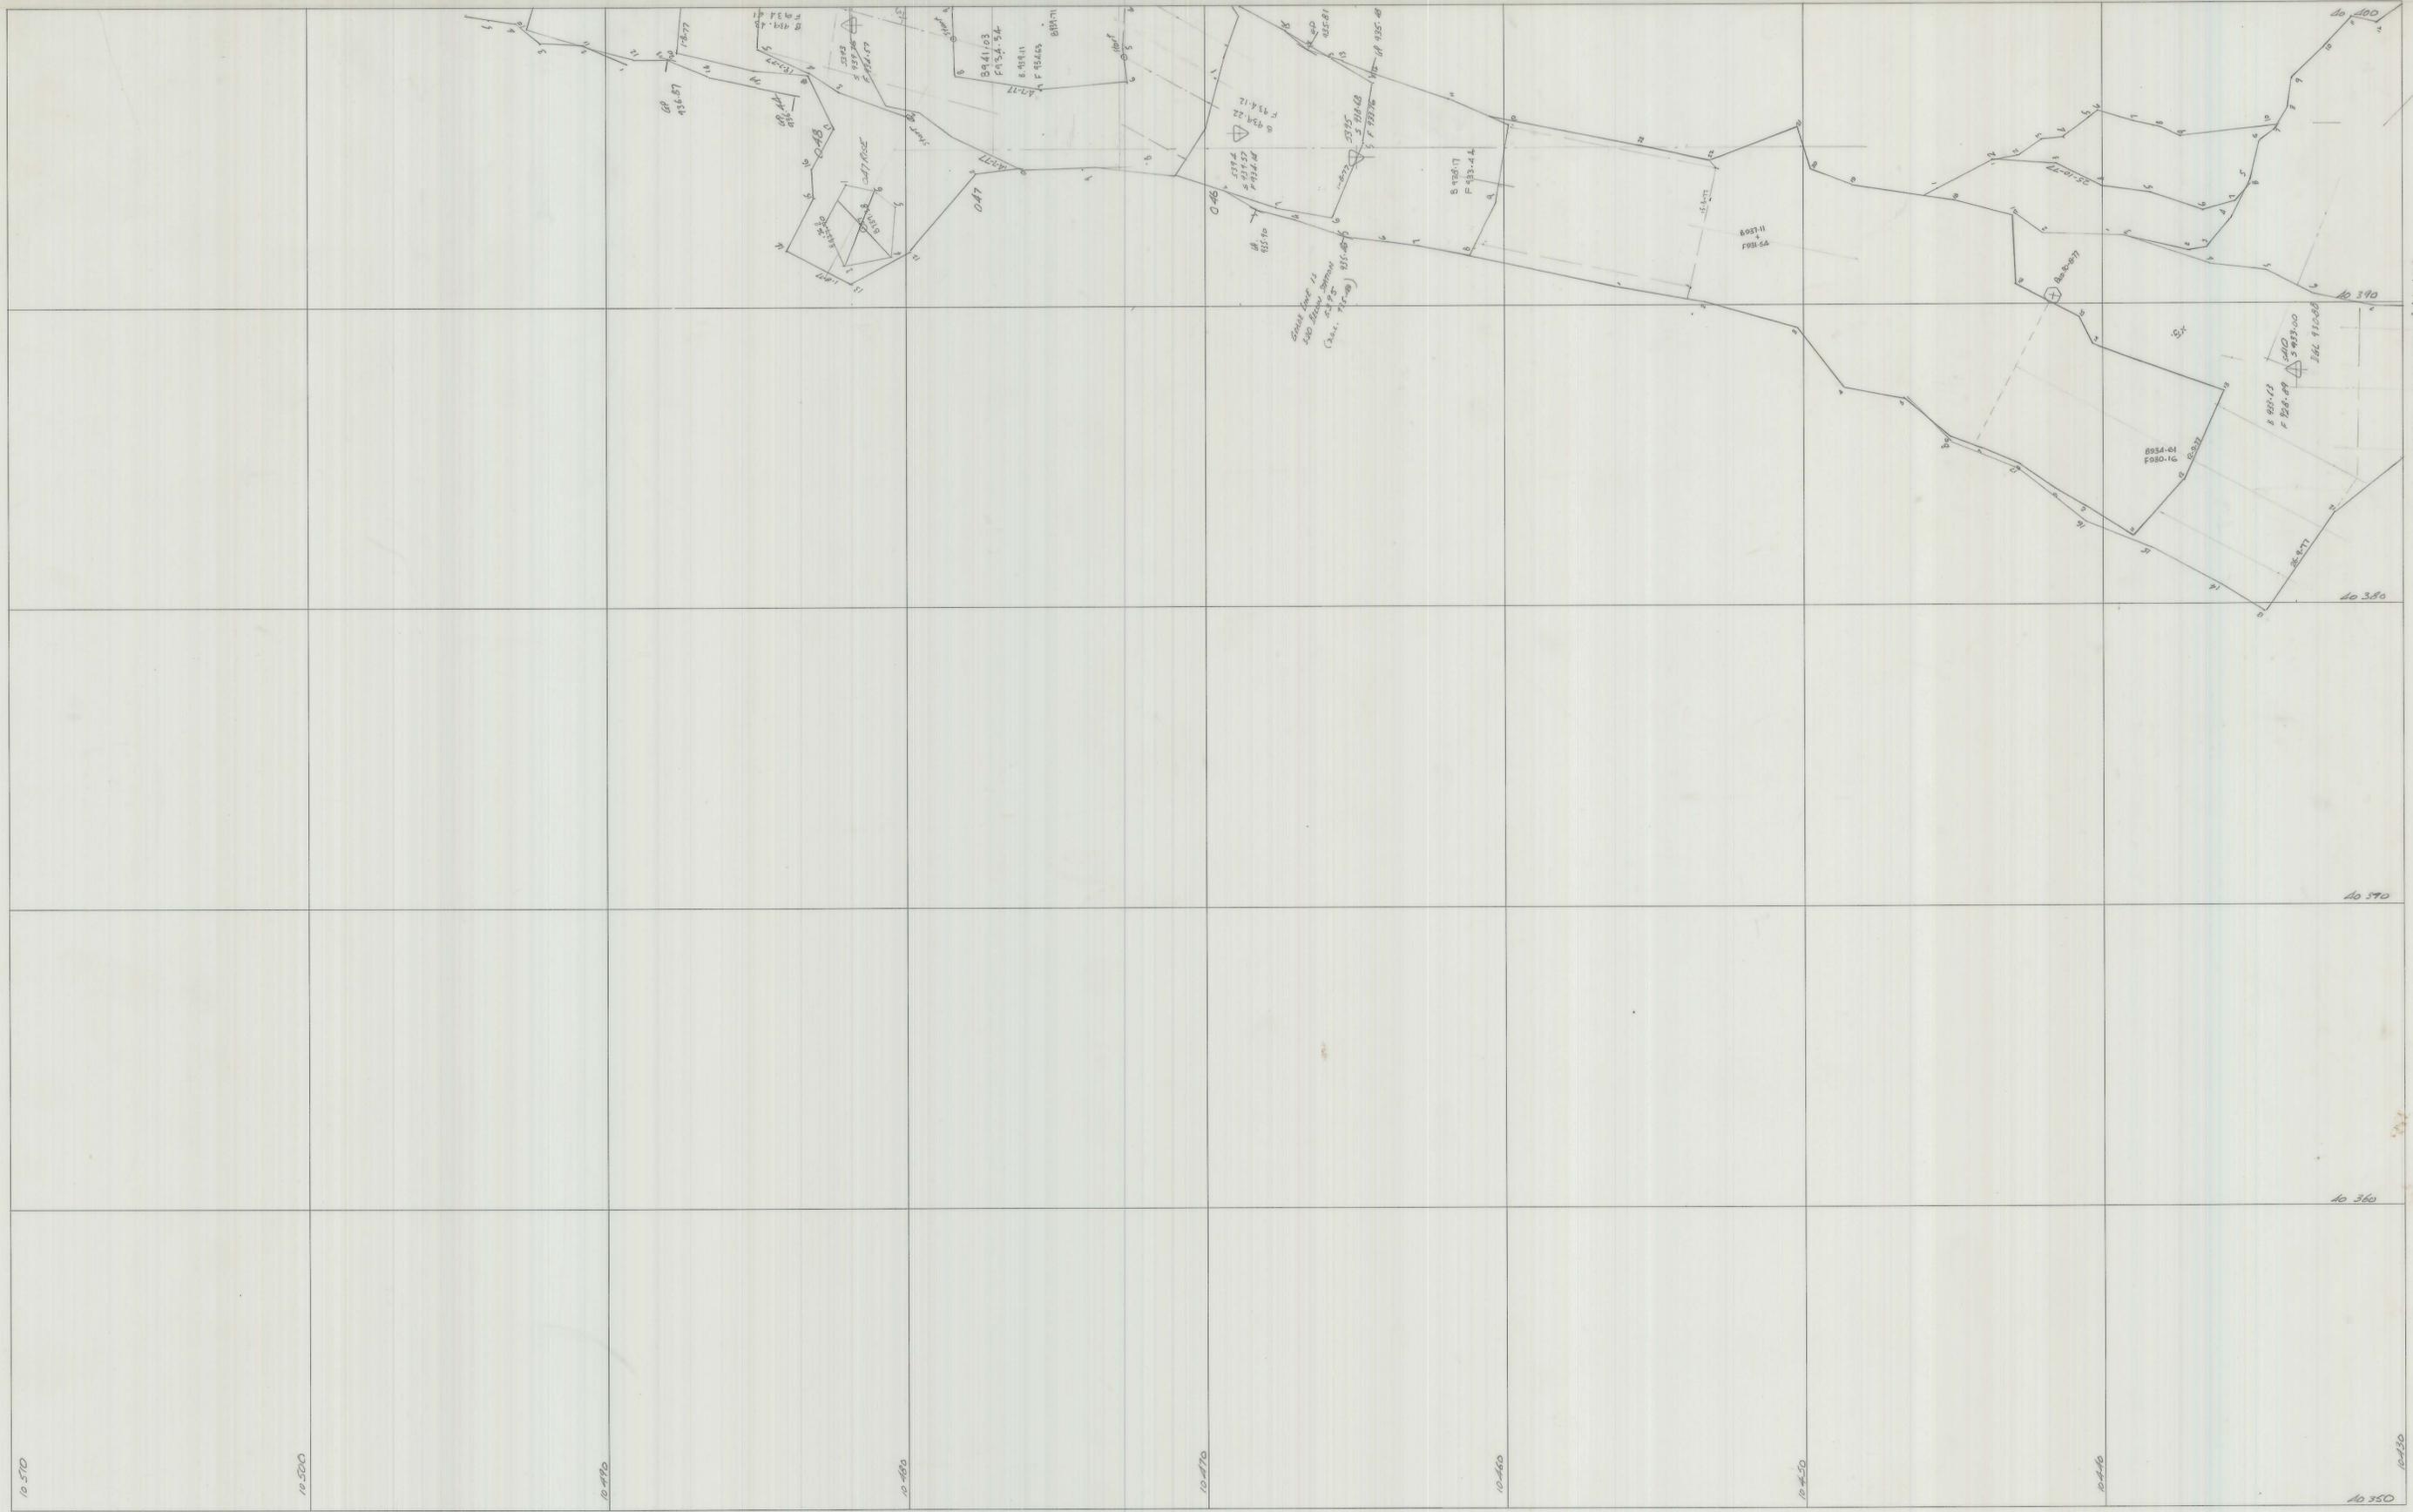

10 570
10 560
10 550
10 540
10 530
10 520
10 510
10 500
10 490
10 480
10 470
10 460
10 450
10 440
10 430

SCALE 1	LOCATION	
north	PLAN NUMBER	04 BH 11 - 1.214.56