


5 cm

0374-4187

04 BH 11.157 710

DECLINE

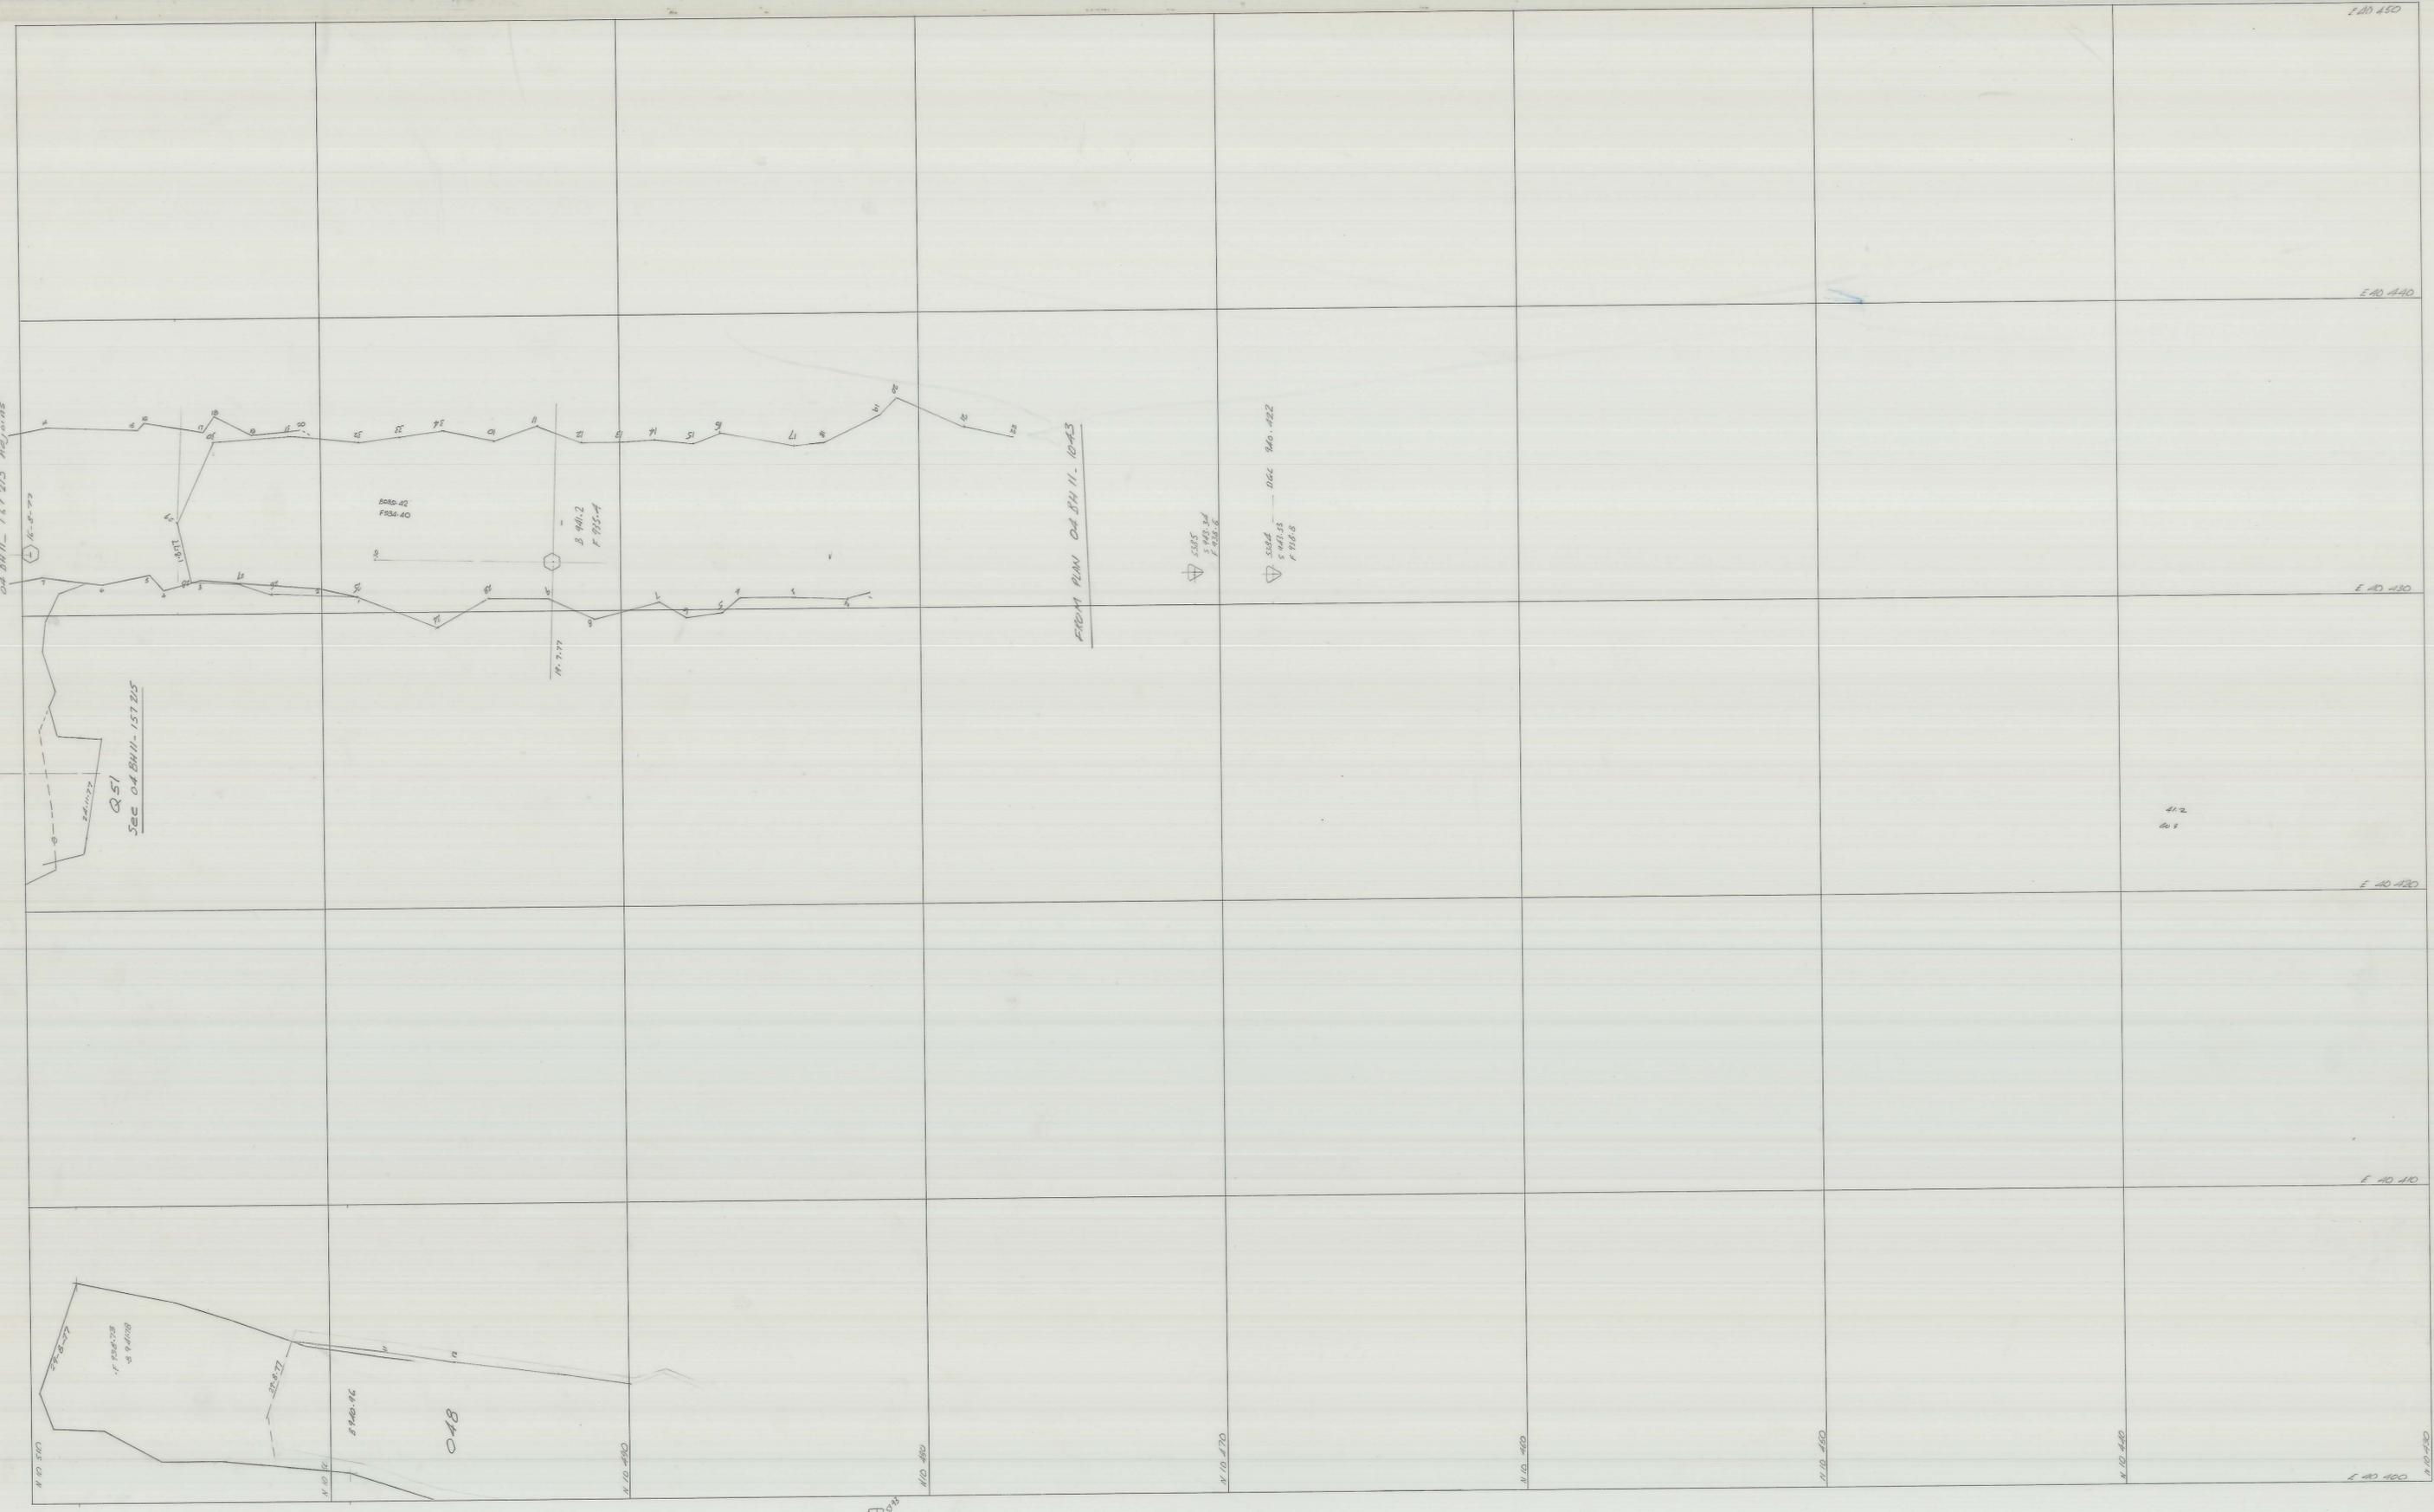

	SCALE 1	north	LOCATION	 KING ISLAND SCHEELITE A DIVISION OF WARMAN INTERNATIONAL GRASSY KING ISLAND PLAN NUMBER
			SUBJECT	