


5 cm

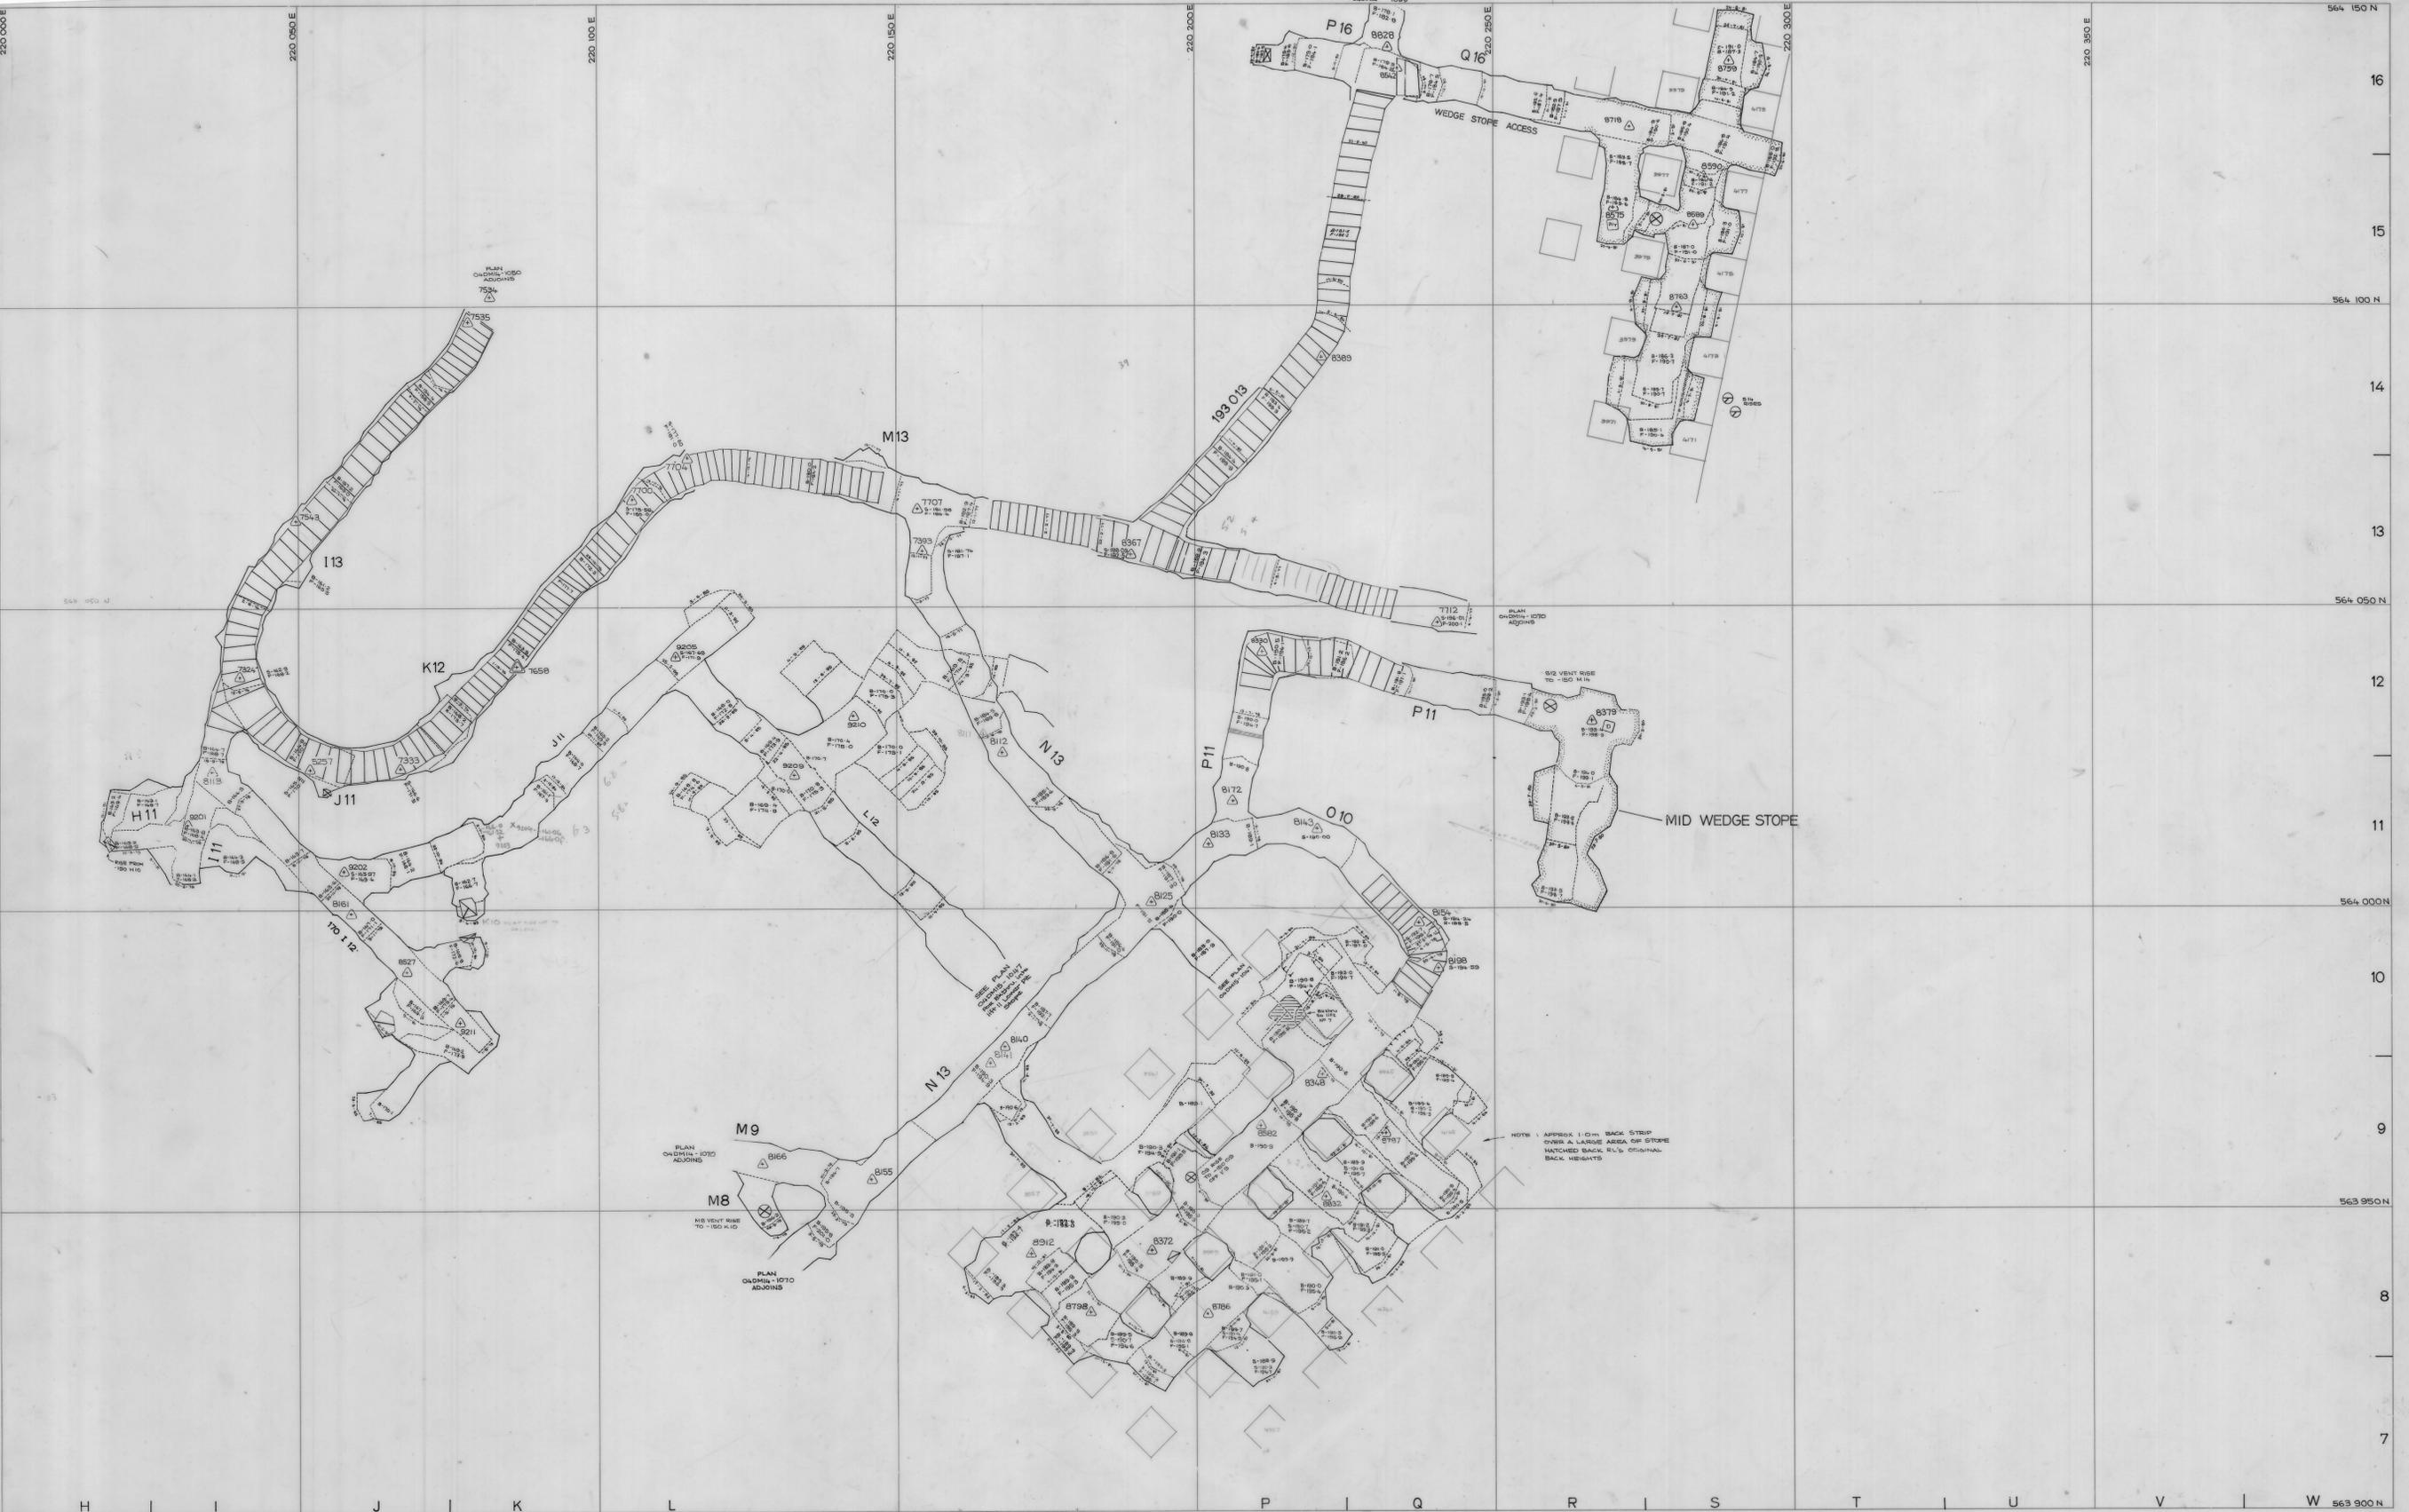

SCALE 1:500	LOCATION	DOLPHIN MINE	
	SUBJECT	-175m ZONE	
north		F-162m to B-187m	PLAN NUMBER 04DM14 - 1060

1:500