


04 SHH-1.A7.203

R-10

0374\_4196

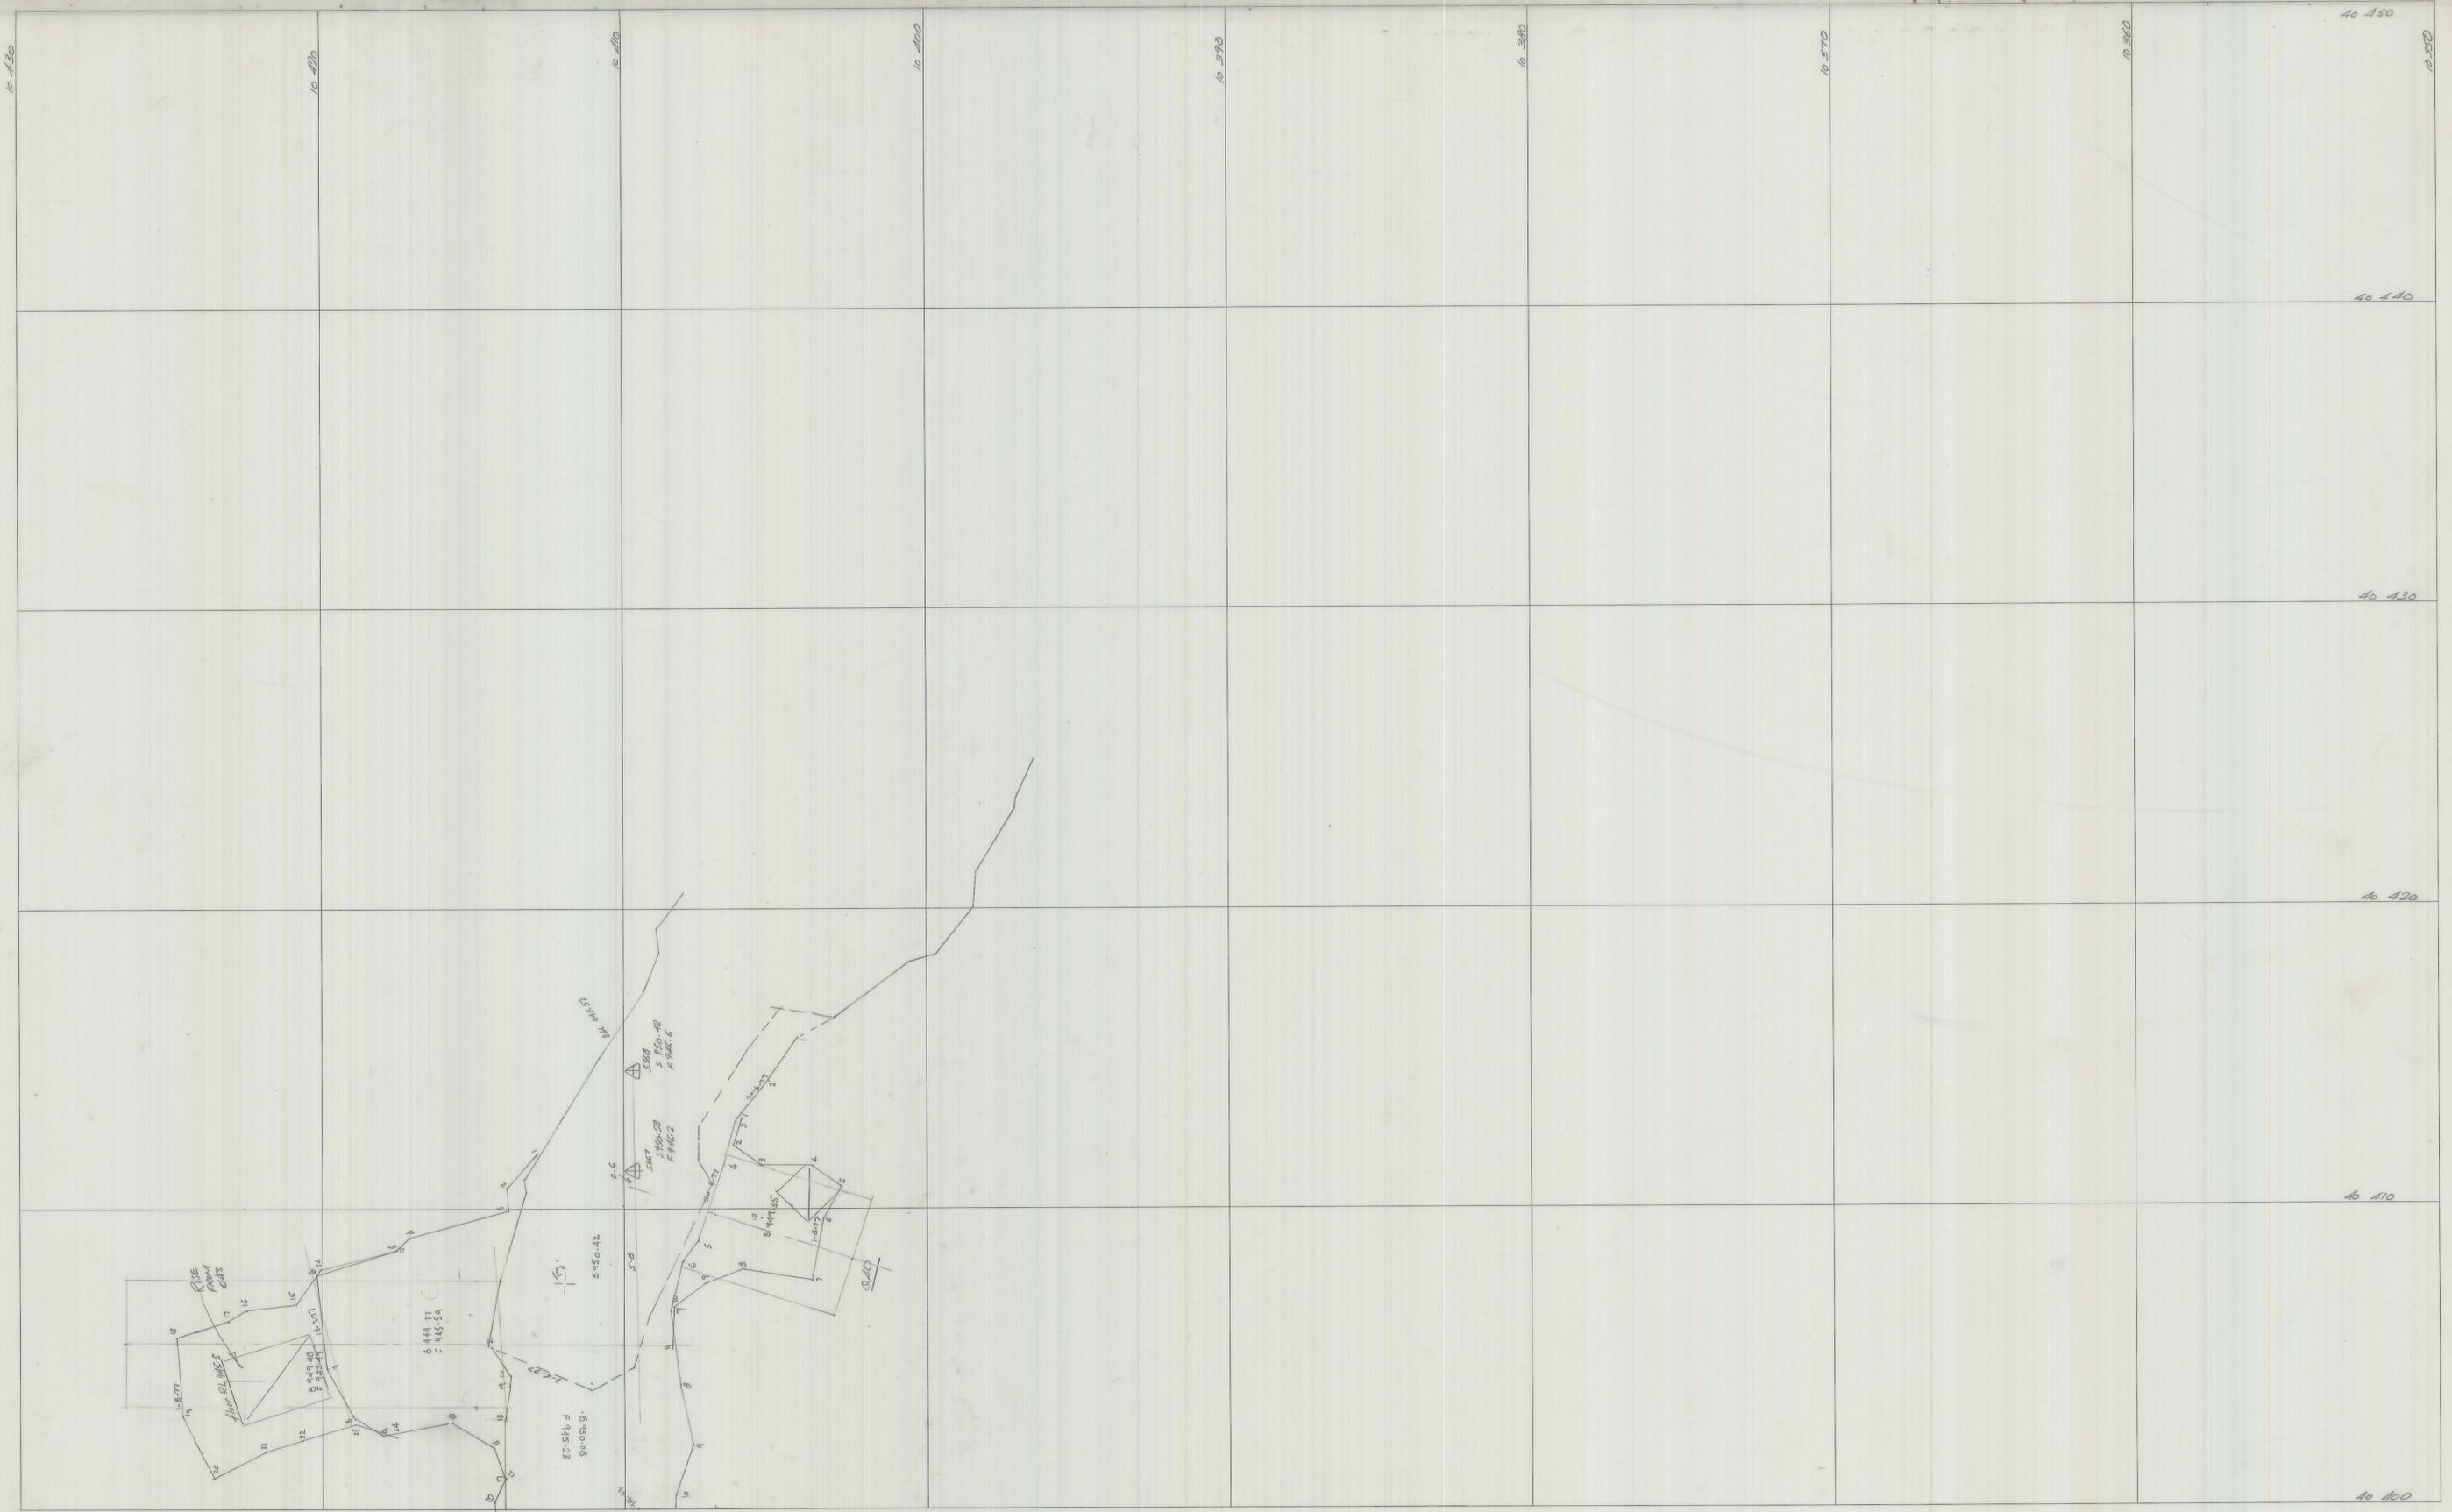

SCALE 1

LOCATION

SUBJECT

north



GRASSY KING ISLAND

PLAN NUMBER