


5 cm

04BH11-1027

0374\_4201

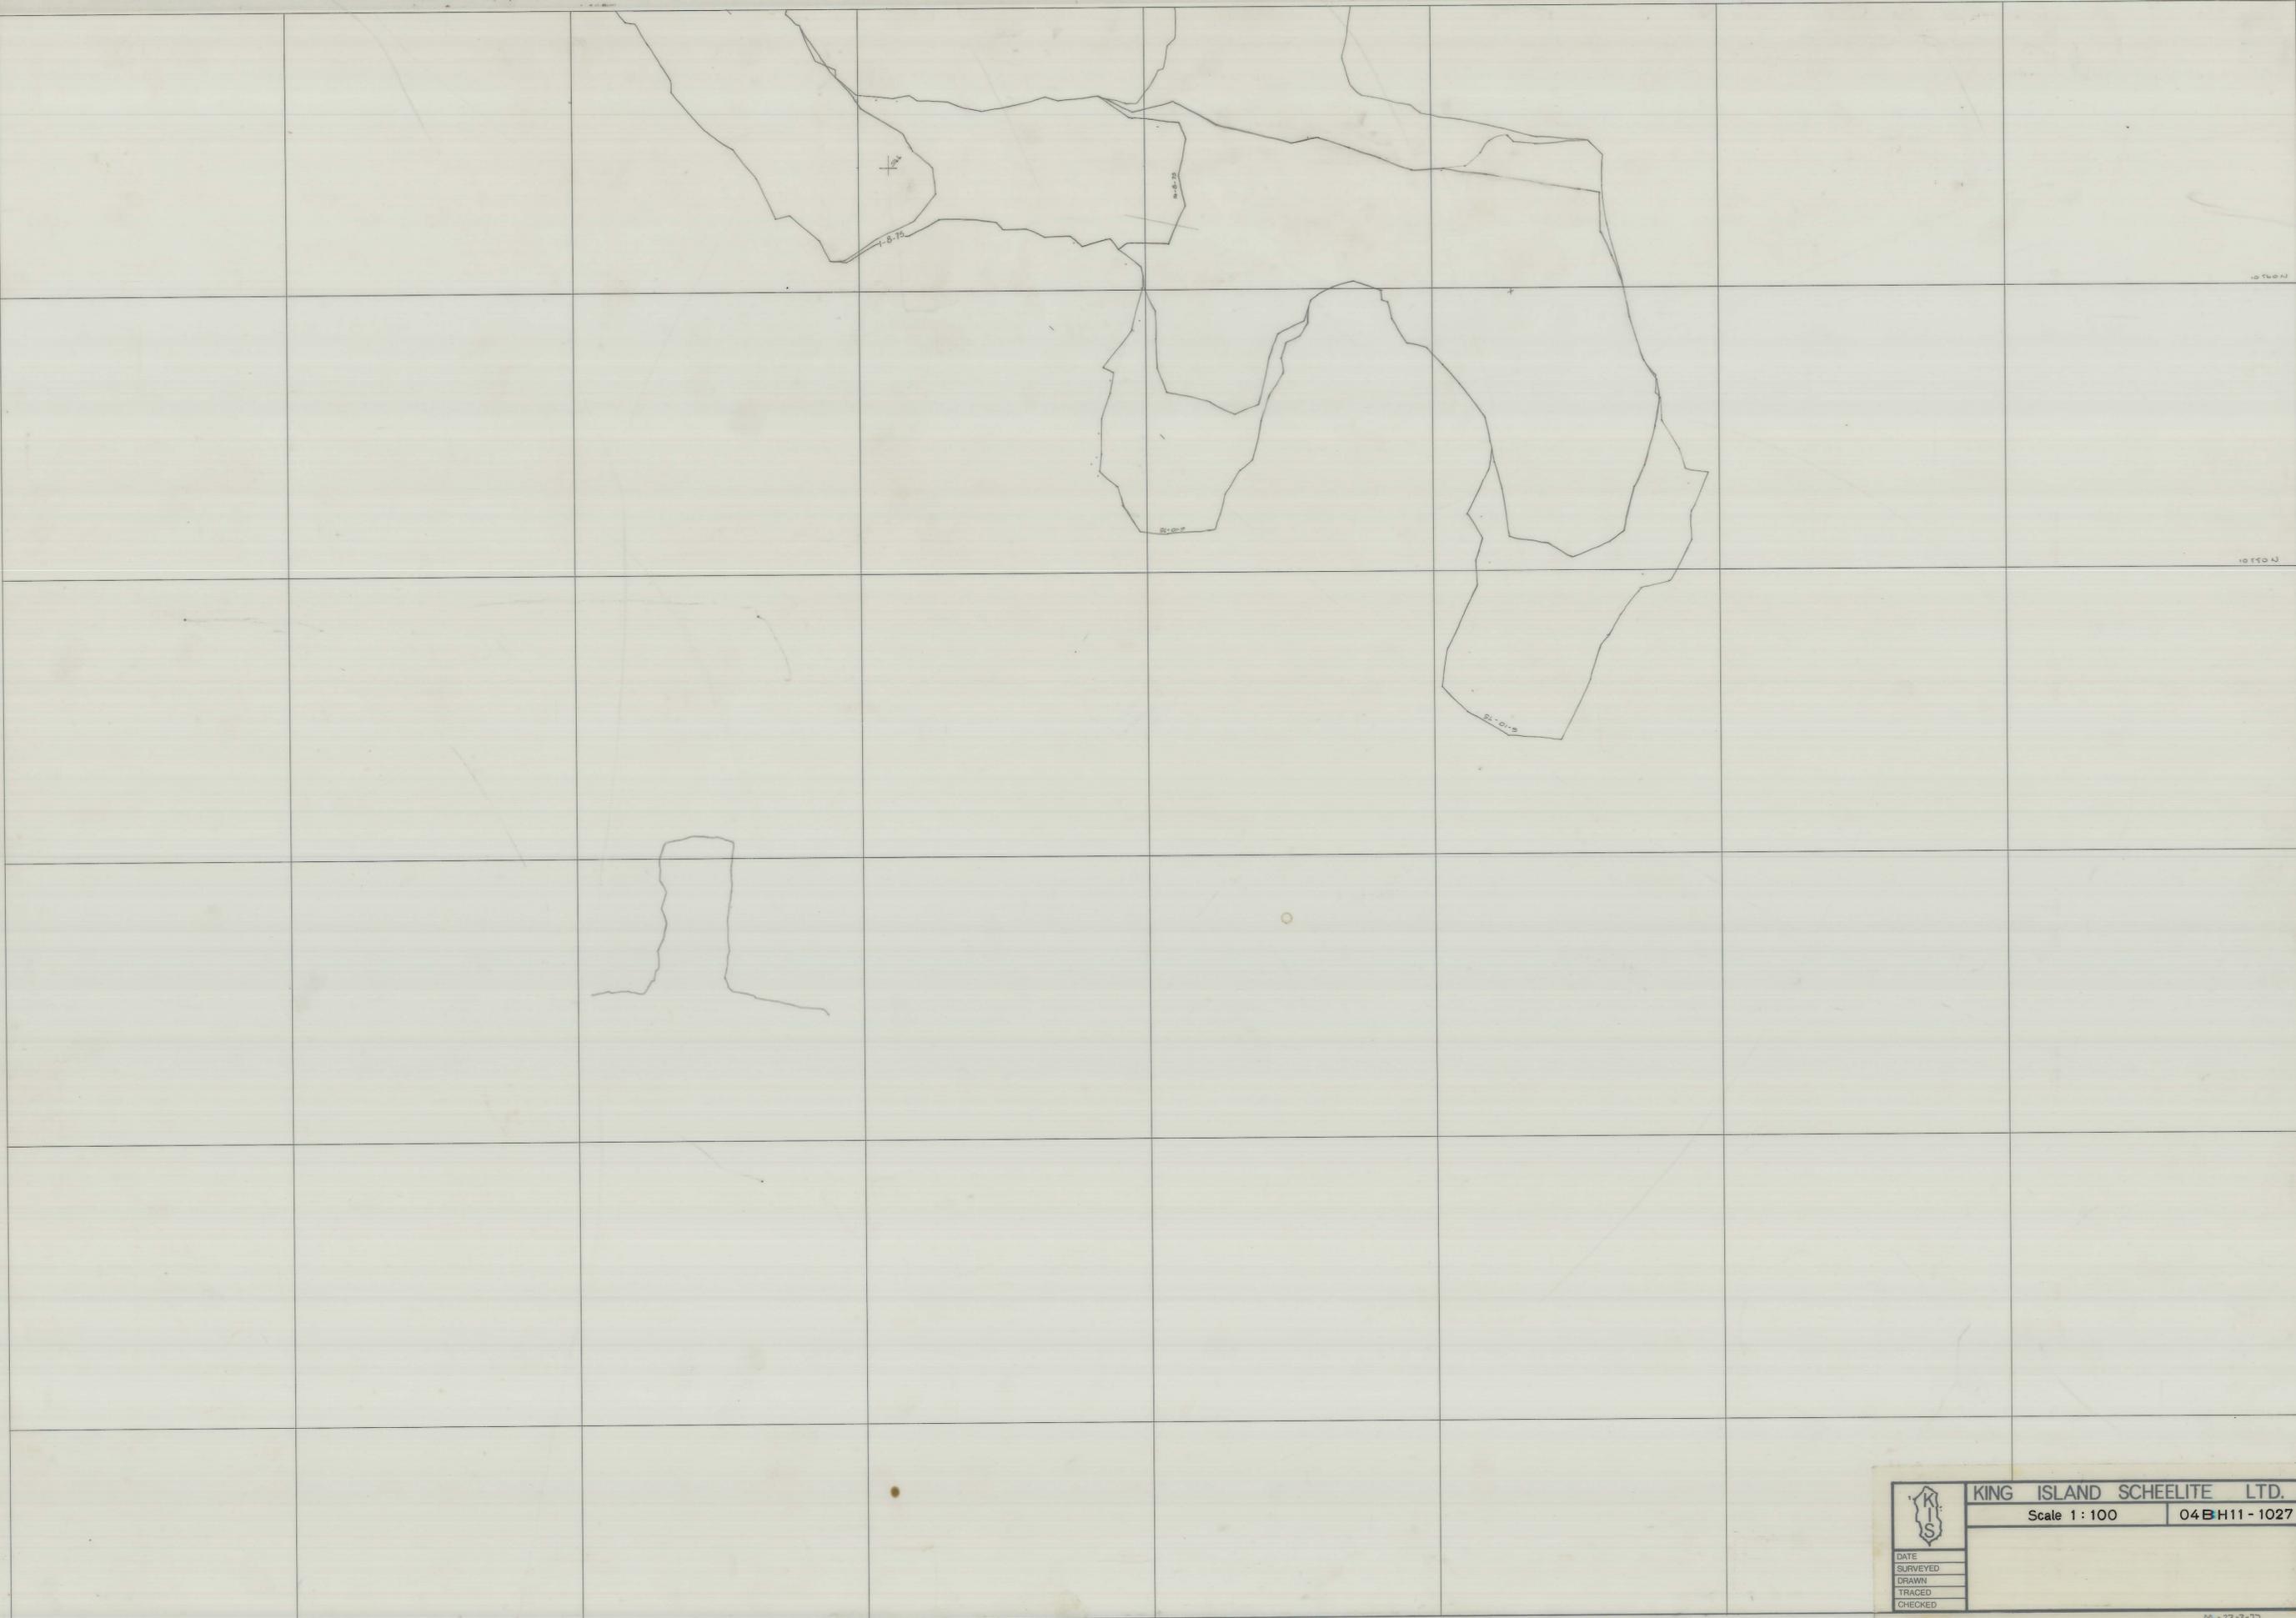

	KING ISLAND SCHEELITE LTD.	
	Scale 1:100	04BH11-1027
DATE		
SURVEYED		
DRAWN		
TRACED		
CHECKED		