


04BH11-1028

0374_4202

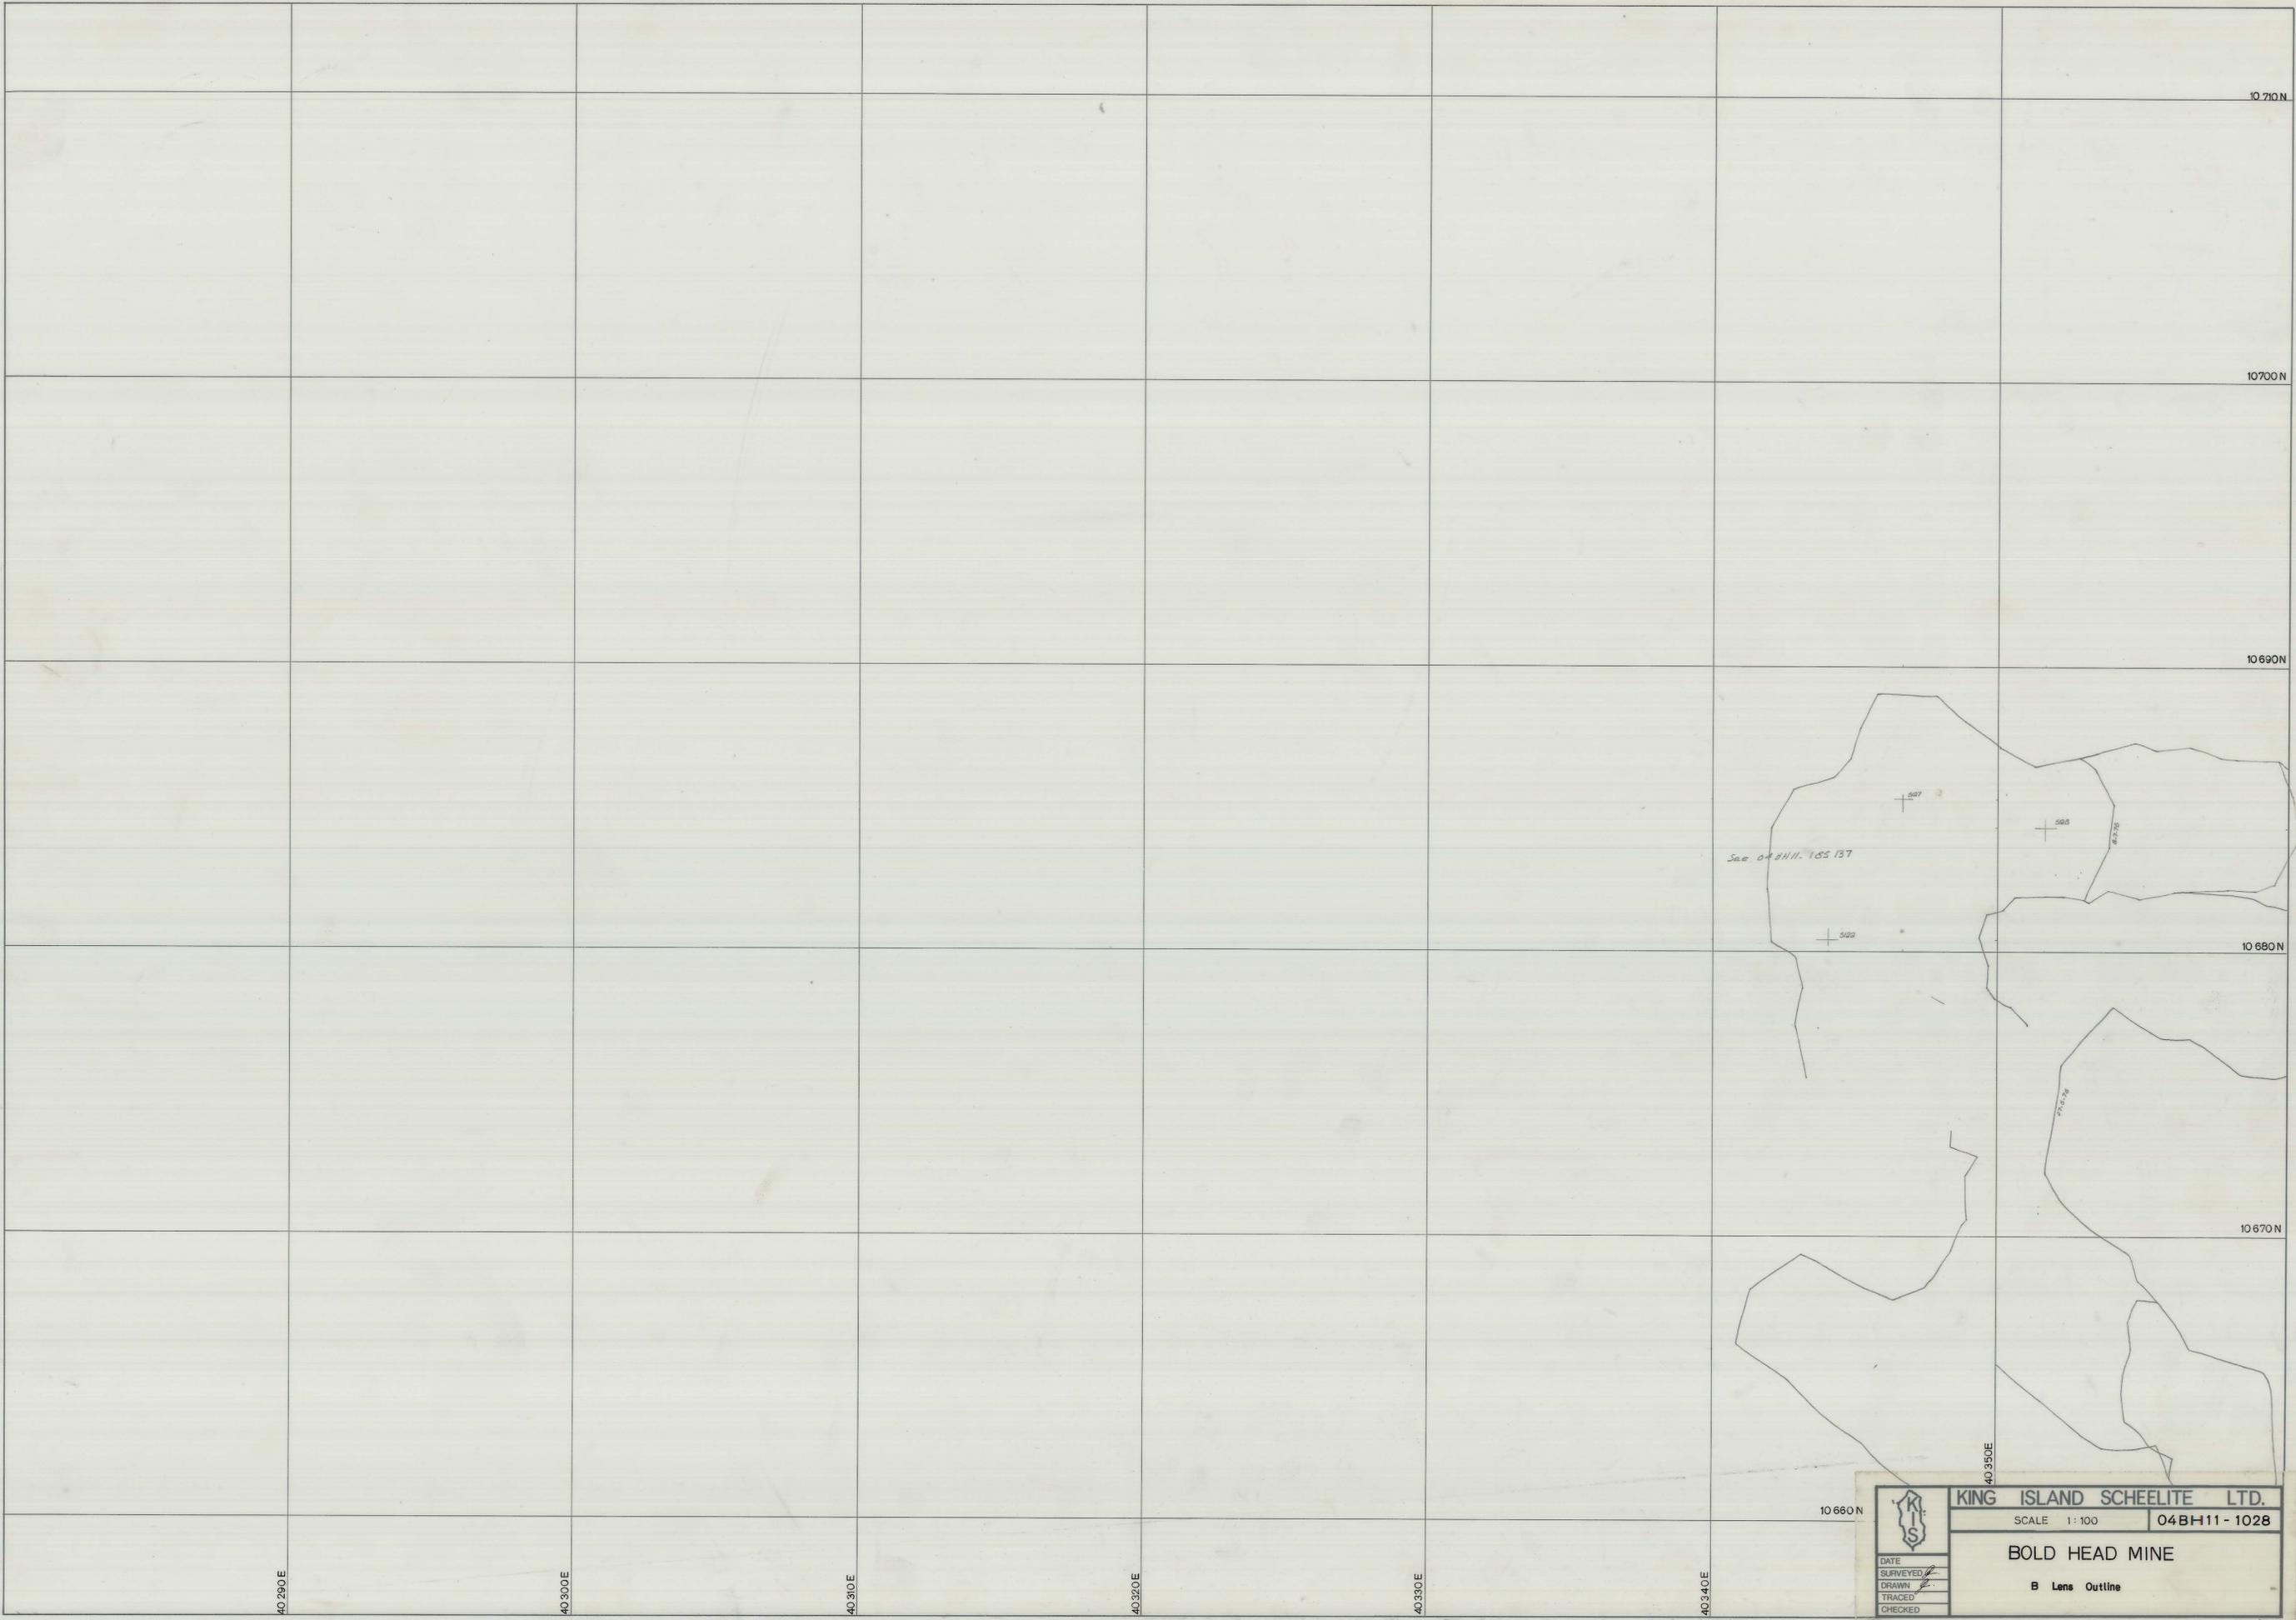

	KING ISLAND SCHEELITE LTD.	
	SCALE 1:100	04BH11-1028
	BOLD HEAD MINE	
	B Lens Outline	