
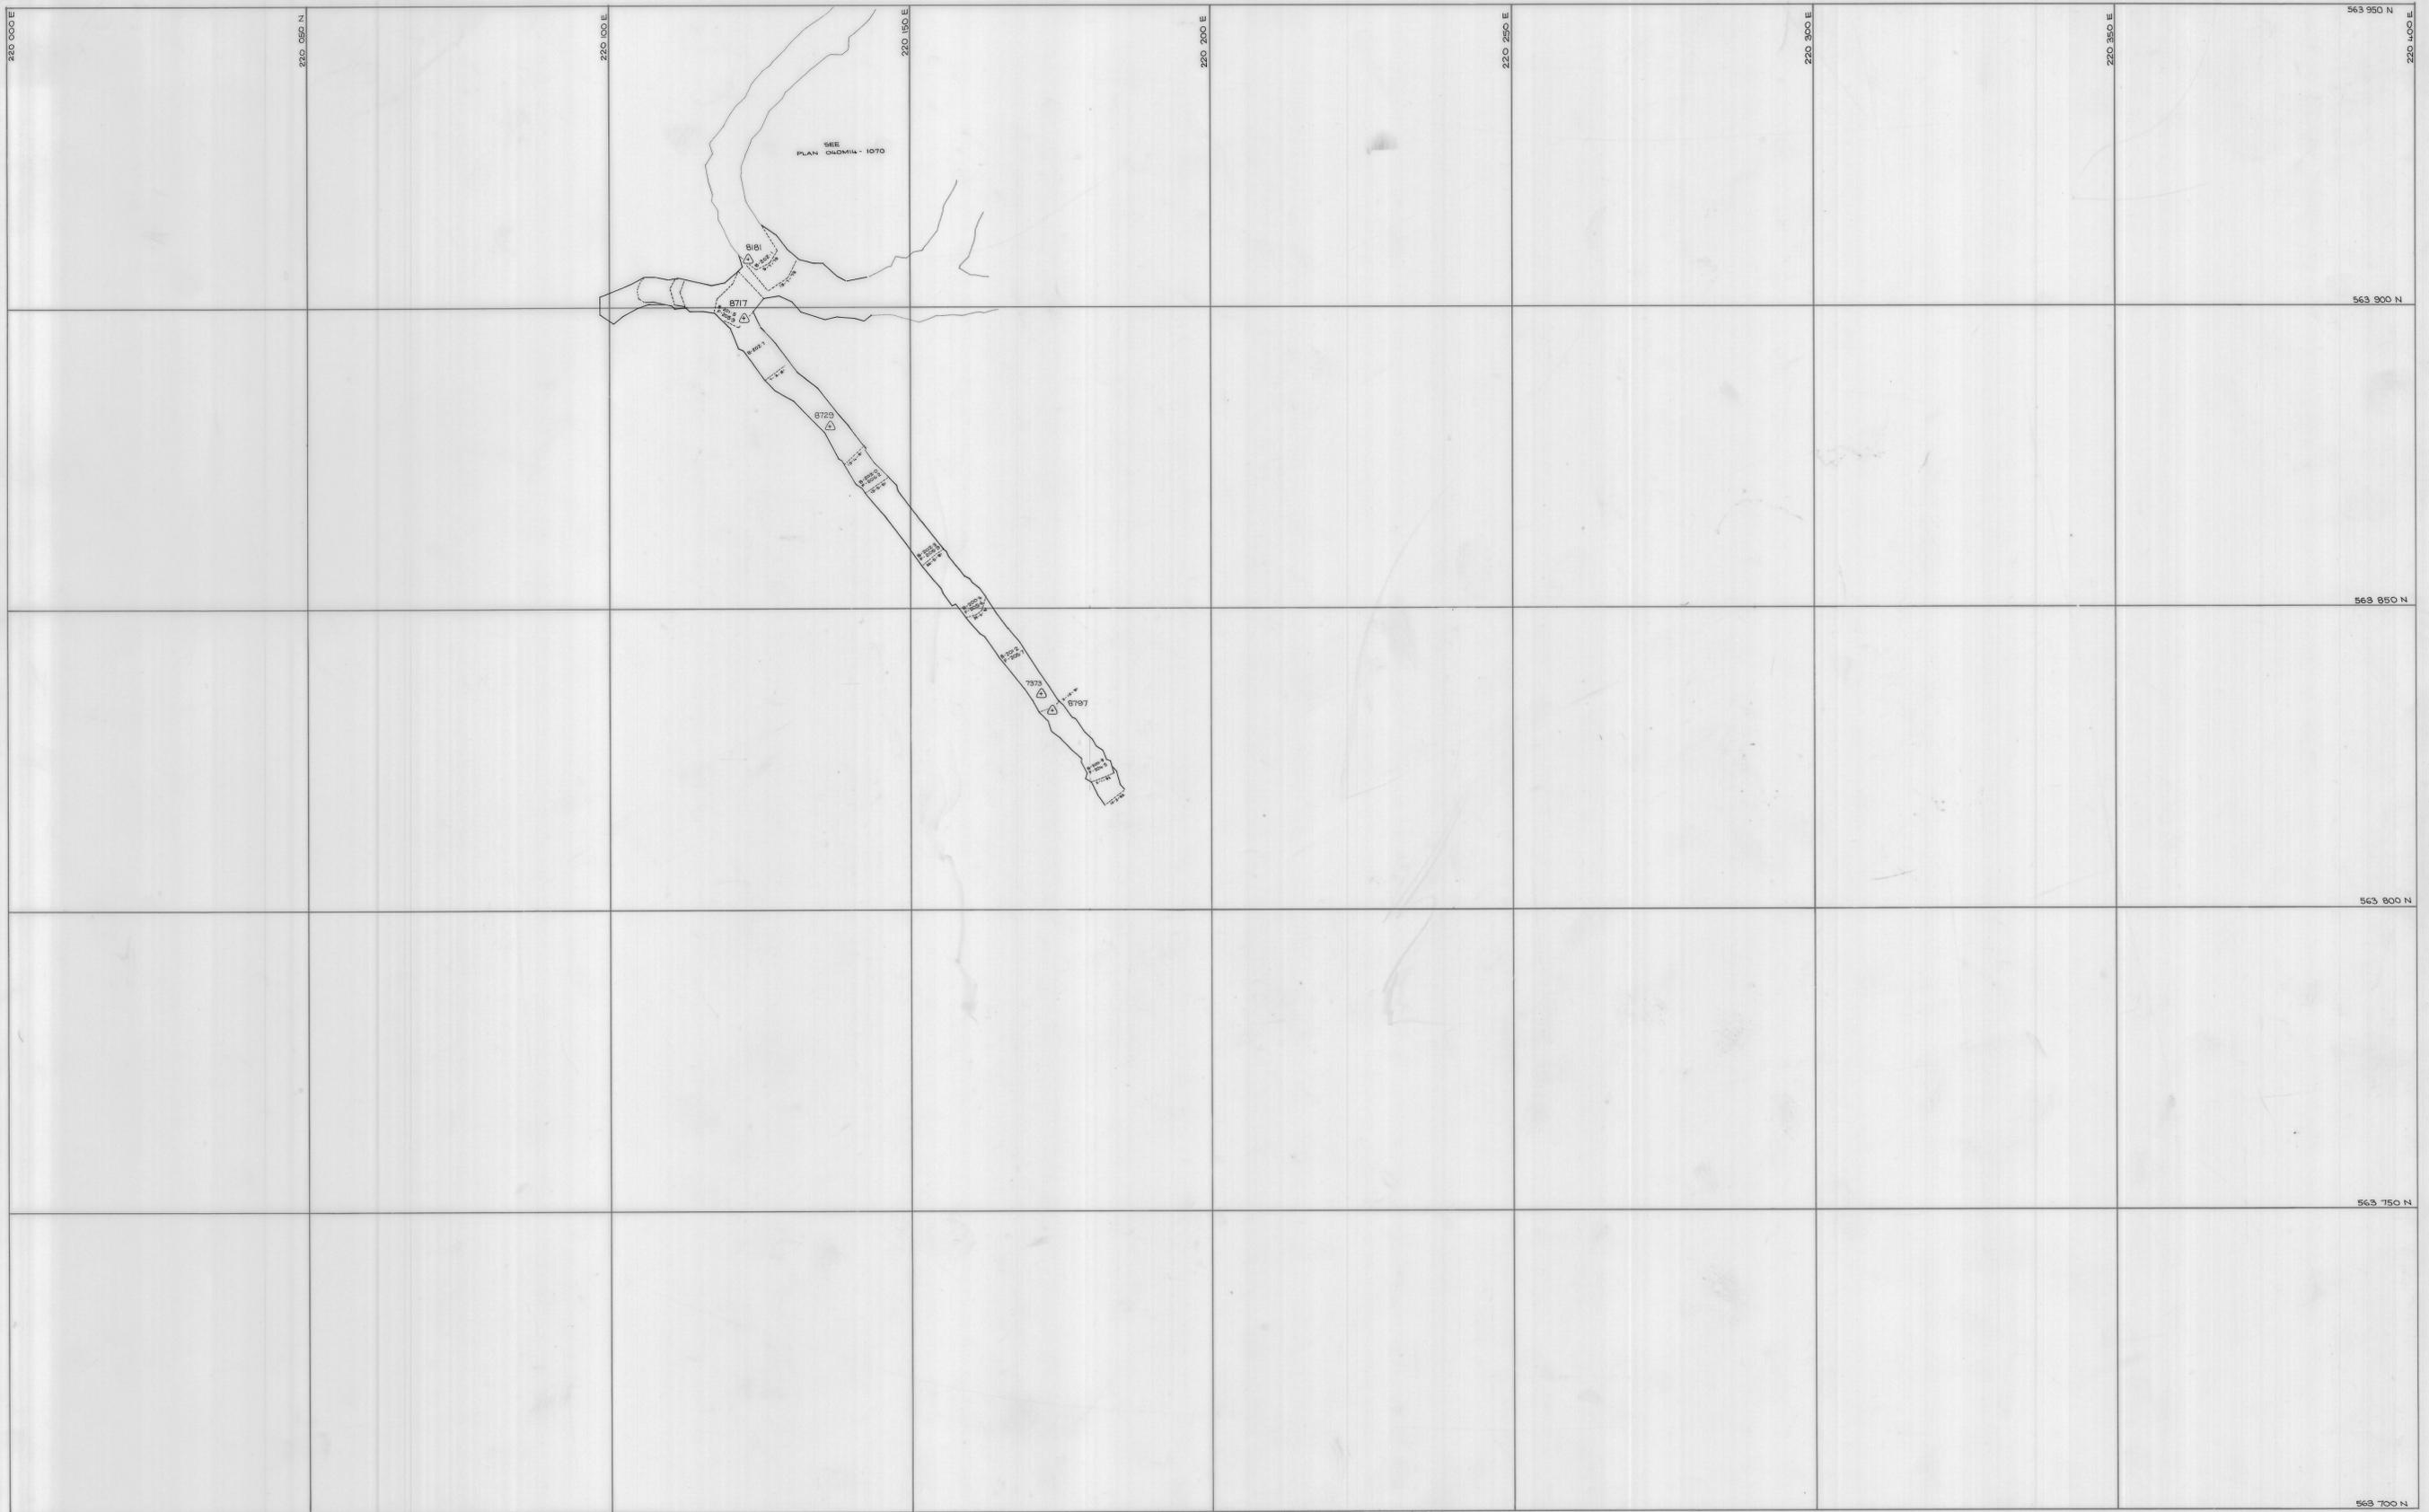


0374-421

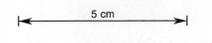

	SCALE 1:500	<p>north</p>	LOCATION DOLPHIN MINE SUBJECT -205 L 6 DIAMOND DRILL DRIVE	KING ISLAND SCHEELITE A DIVISION OF WARMAN INTERNATIONAL GRASSY KING ISLAND PLAN NUMBER O4DM14 - 1071
--	-------------	--------------	--	---