


5 cm

04BH11-(04)  
0374\_4212

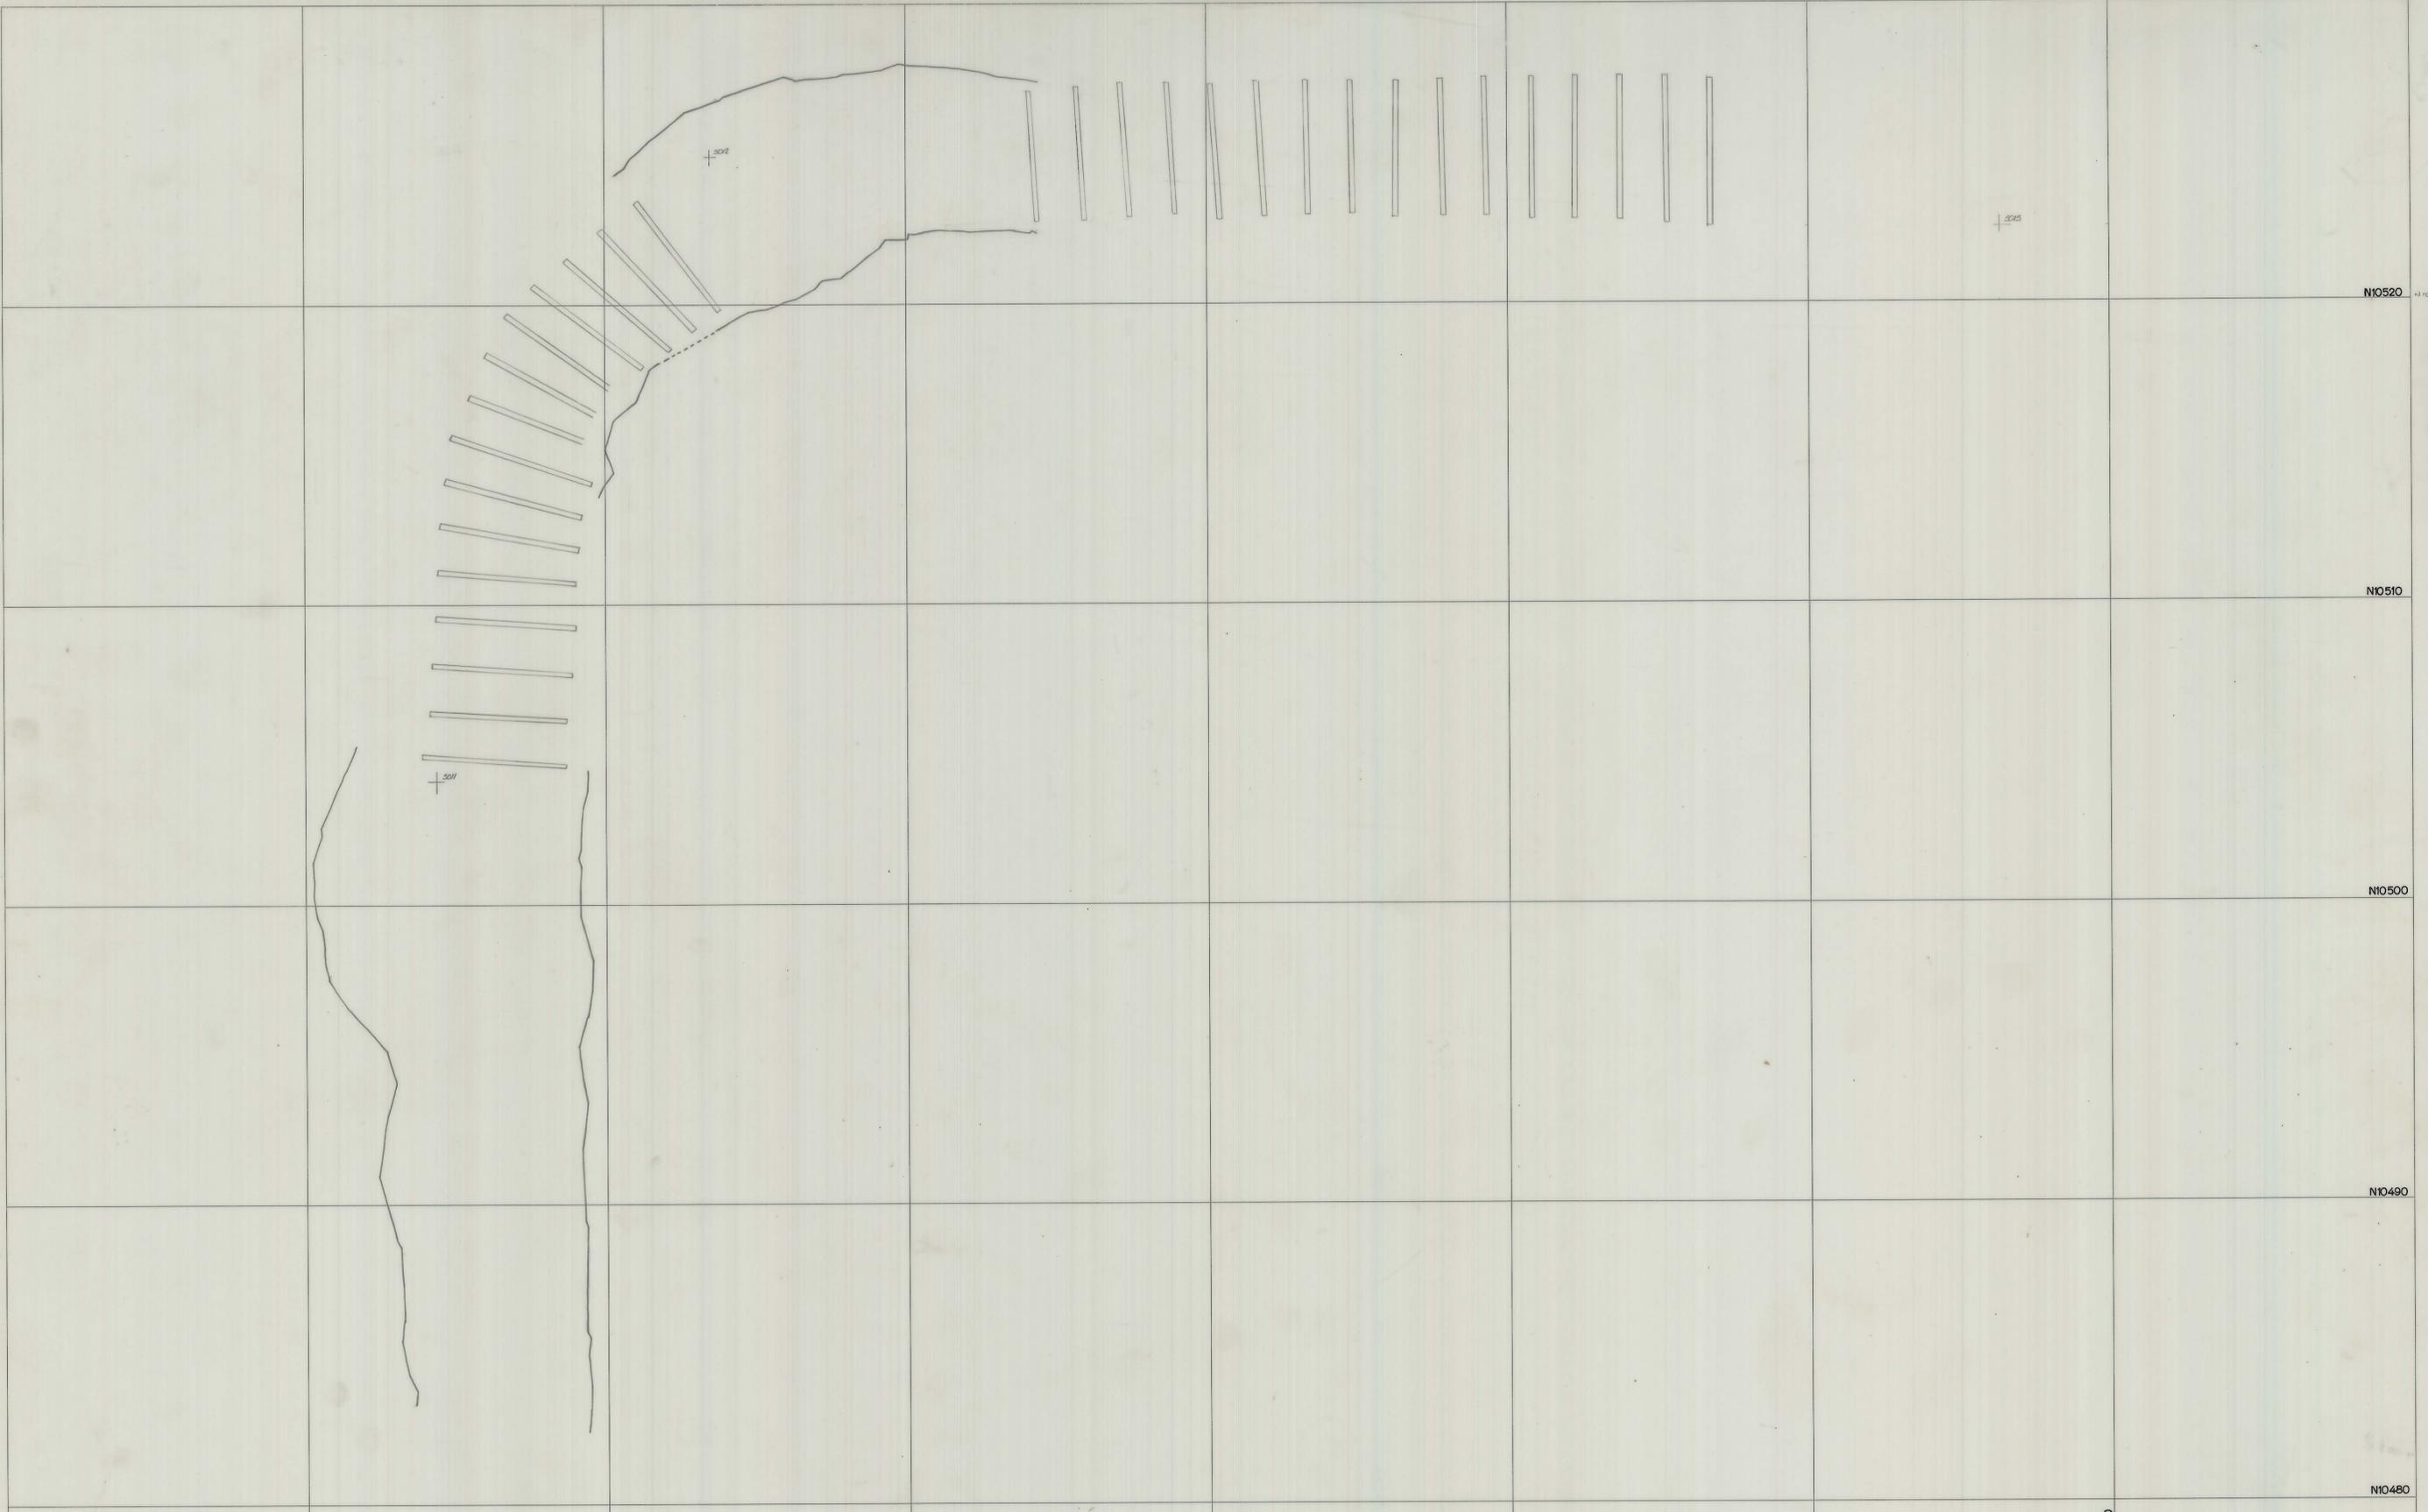

	KING ISLAND SCHEELITE LTD.	
	SCALE 1:100	No 1-
	<b>MAIN DECLINE.</b>	
	<small>DATE _____          SURVEYED _____          DRAWN _____          TRACED _____          CHECKED _____</small>	