


5 cm

0374_4219

OL BH 11 - 1050

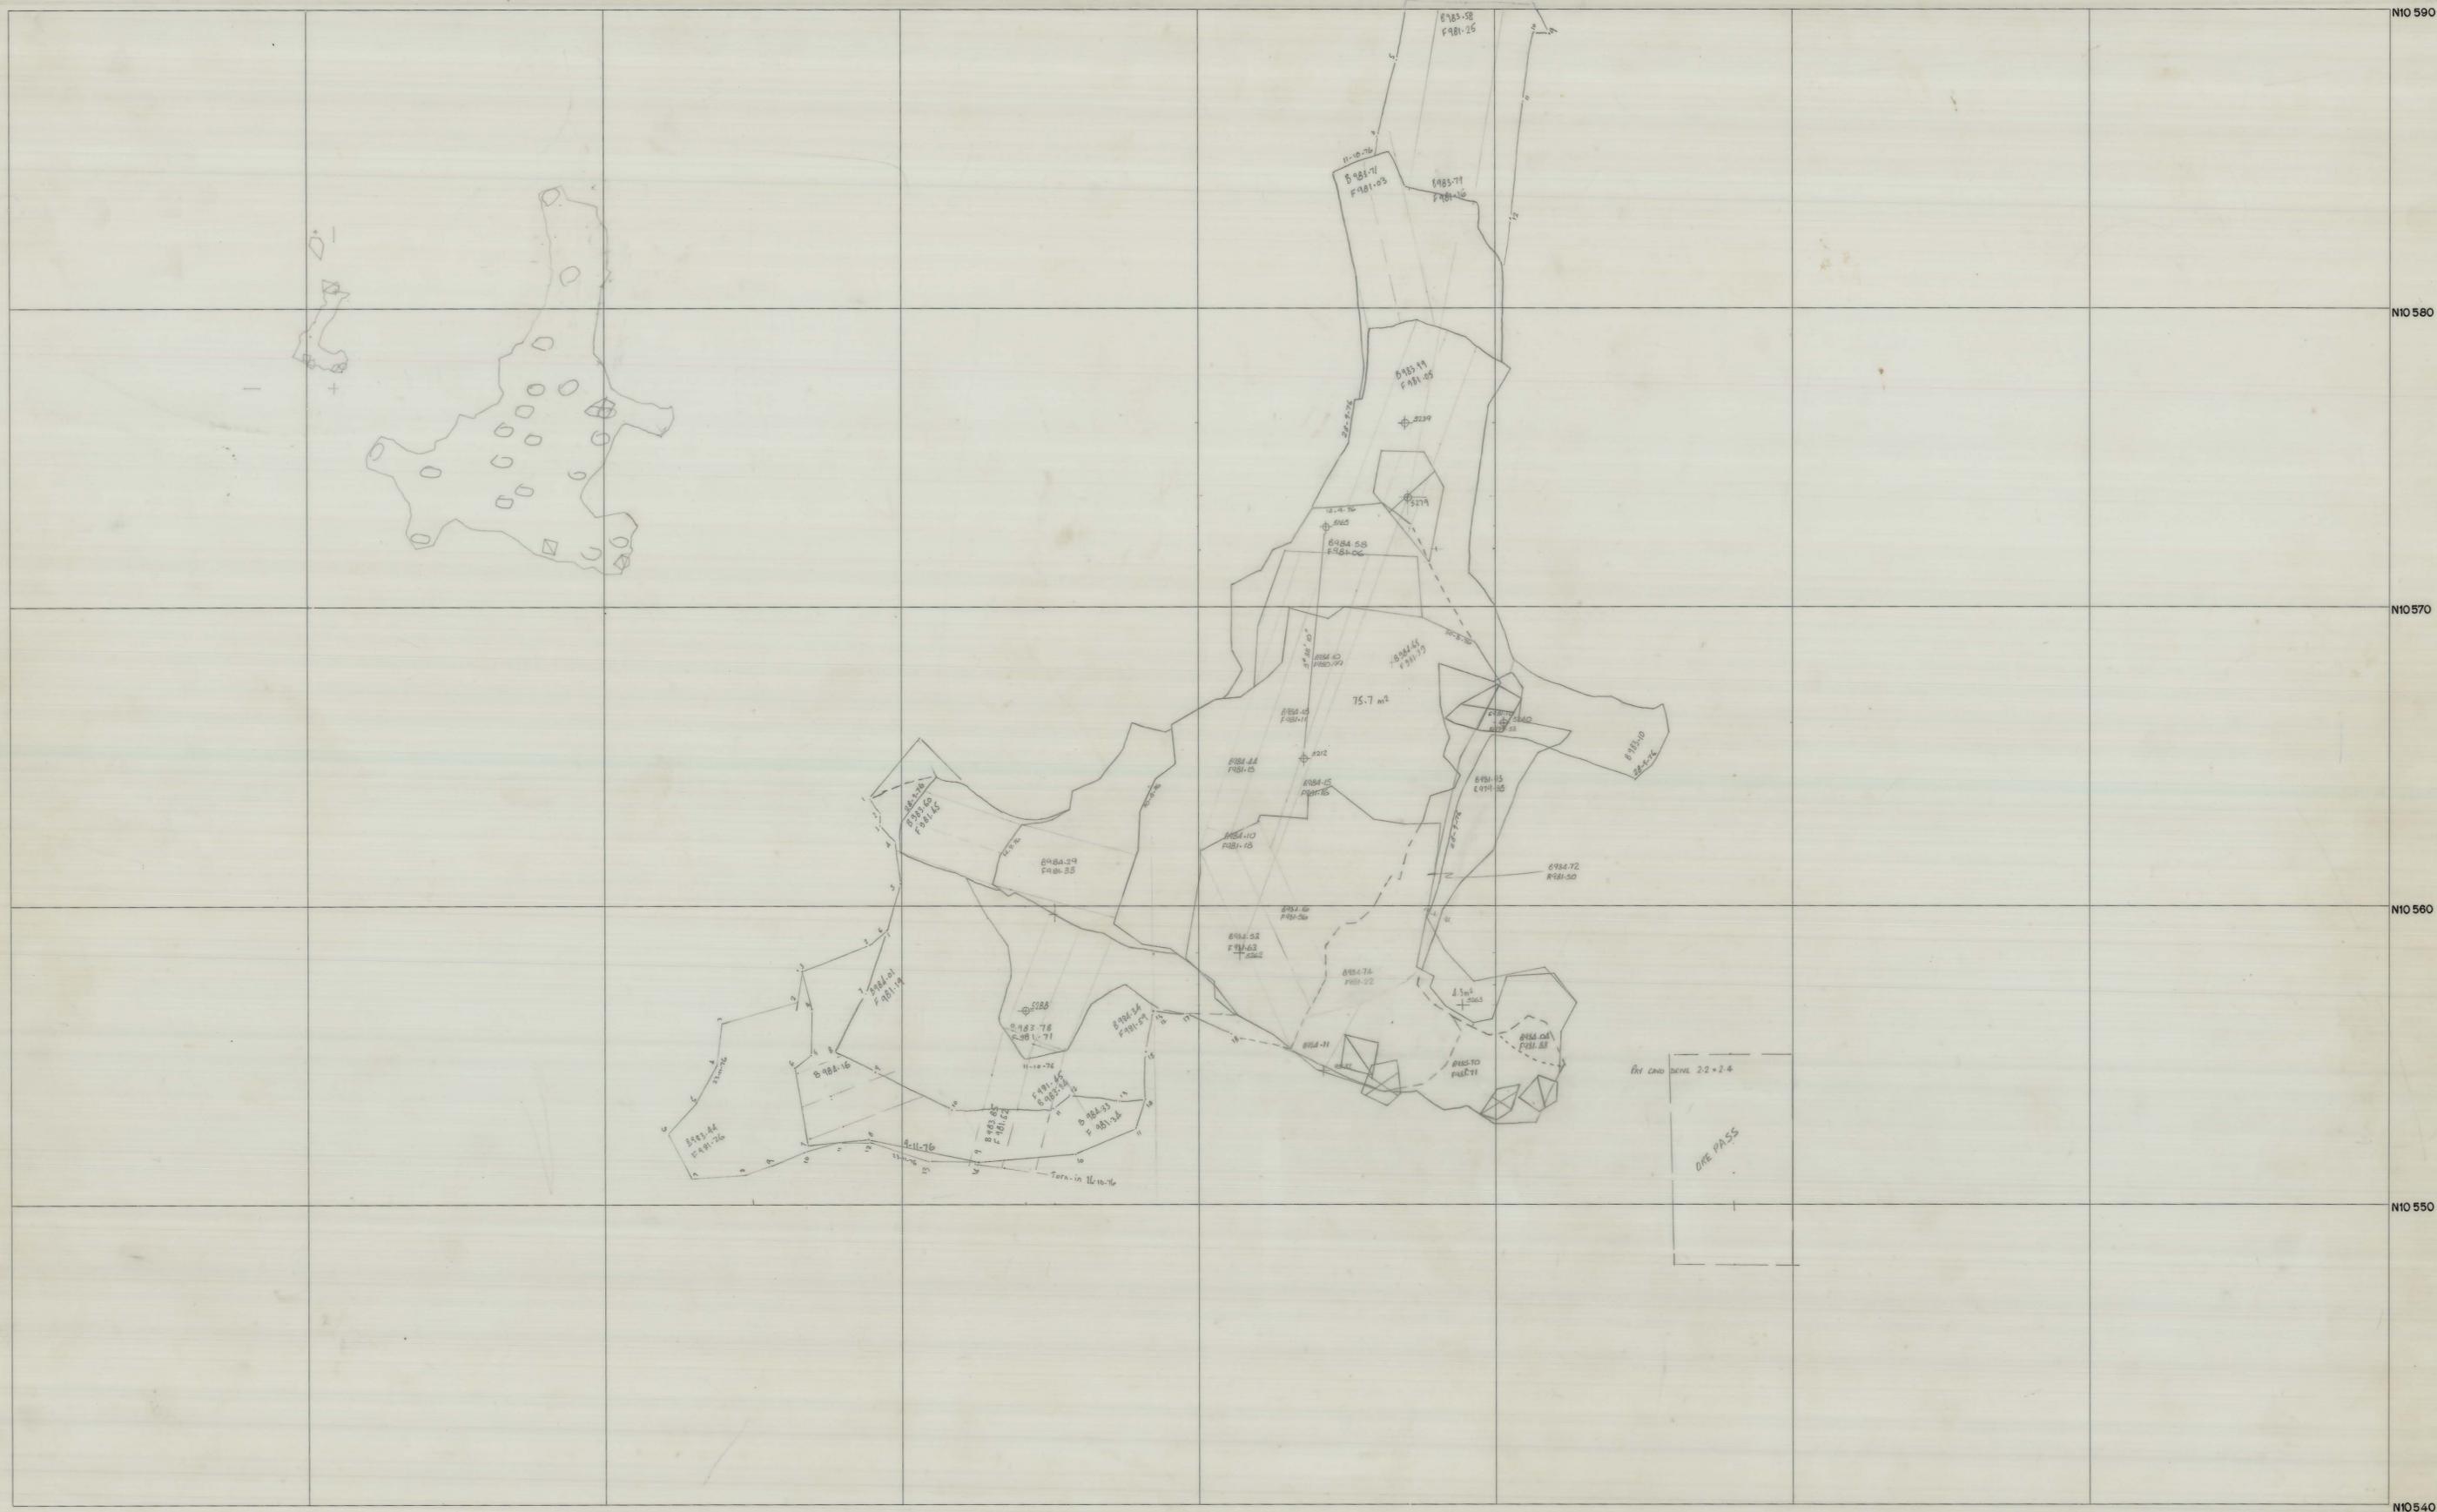

E10 350 E10 360 E10 370 E10 380 E10 390 E10 400 E10 410 E10 420 E10 430

N10 540 N10 550 N10 560 N10 570 N10 580 N10 590

SCALE 1:100

LOCATION N 54 STOPE



KIS KING ISLAND SCHEELITE
 A DIVISION OF WARMAN INTERNATIONAL
 GRASSY KING ISLAND
 PLAN NUMBER