


04-BH-11-1-65-091
 H50
 5th 1/4
 0374_4224

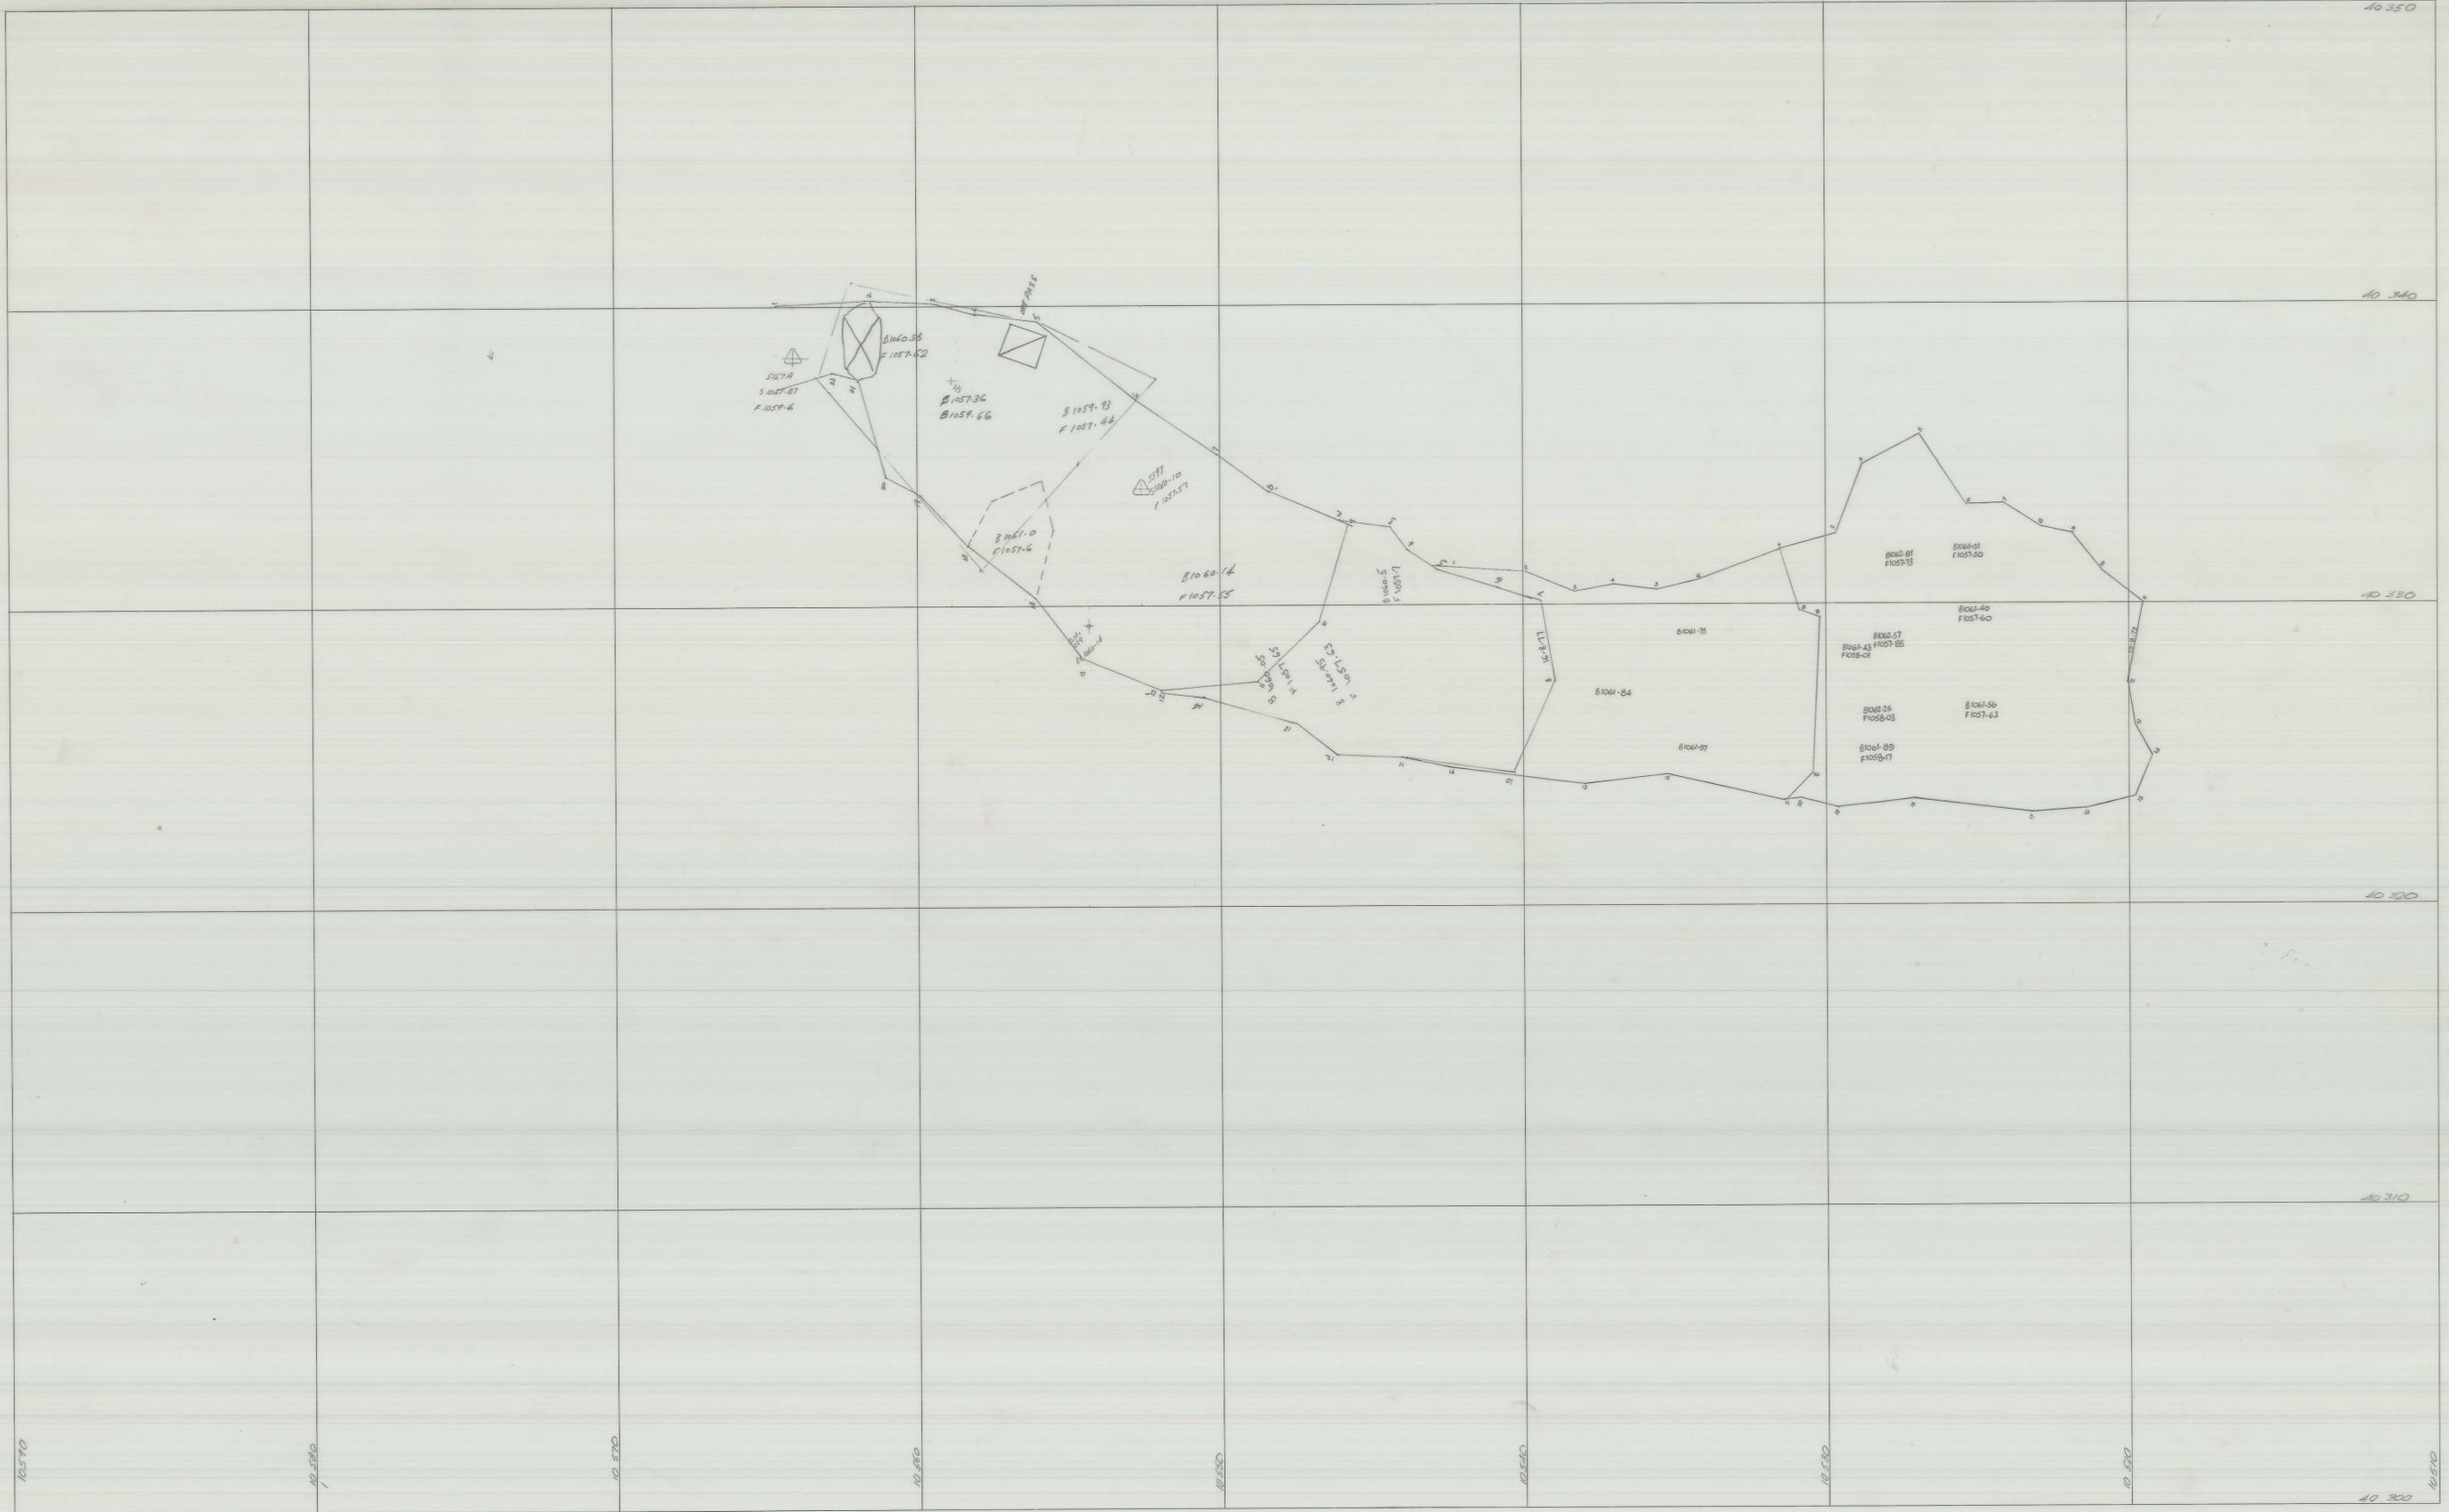

	SCALE 1	north	LOCATION	 KING ISLAND SCHEELITE A DIVISION OF WARMAN INTERNATIONAL GRASSY KING ISLAND PLAN NUMBER
			SUBJECT	