


5 cm

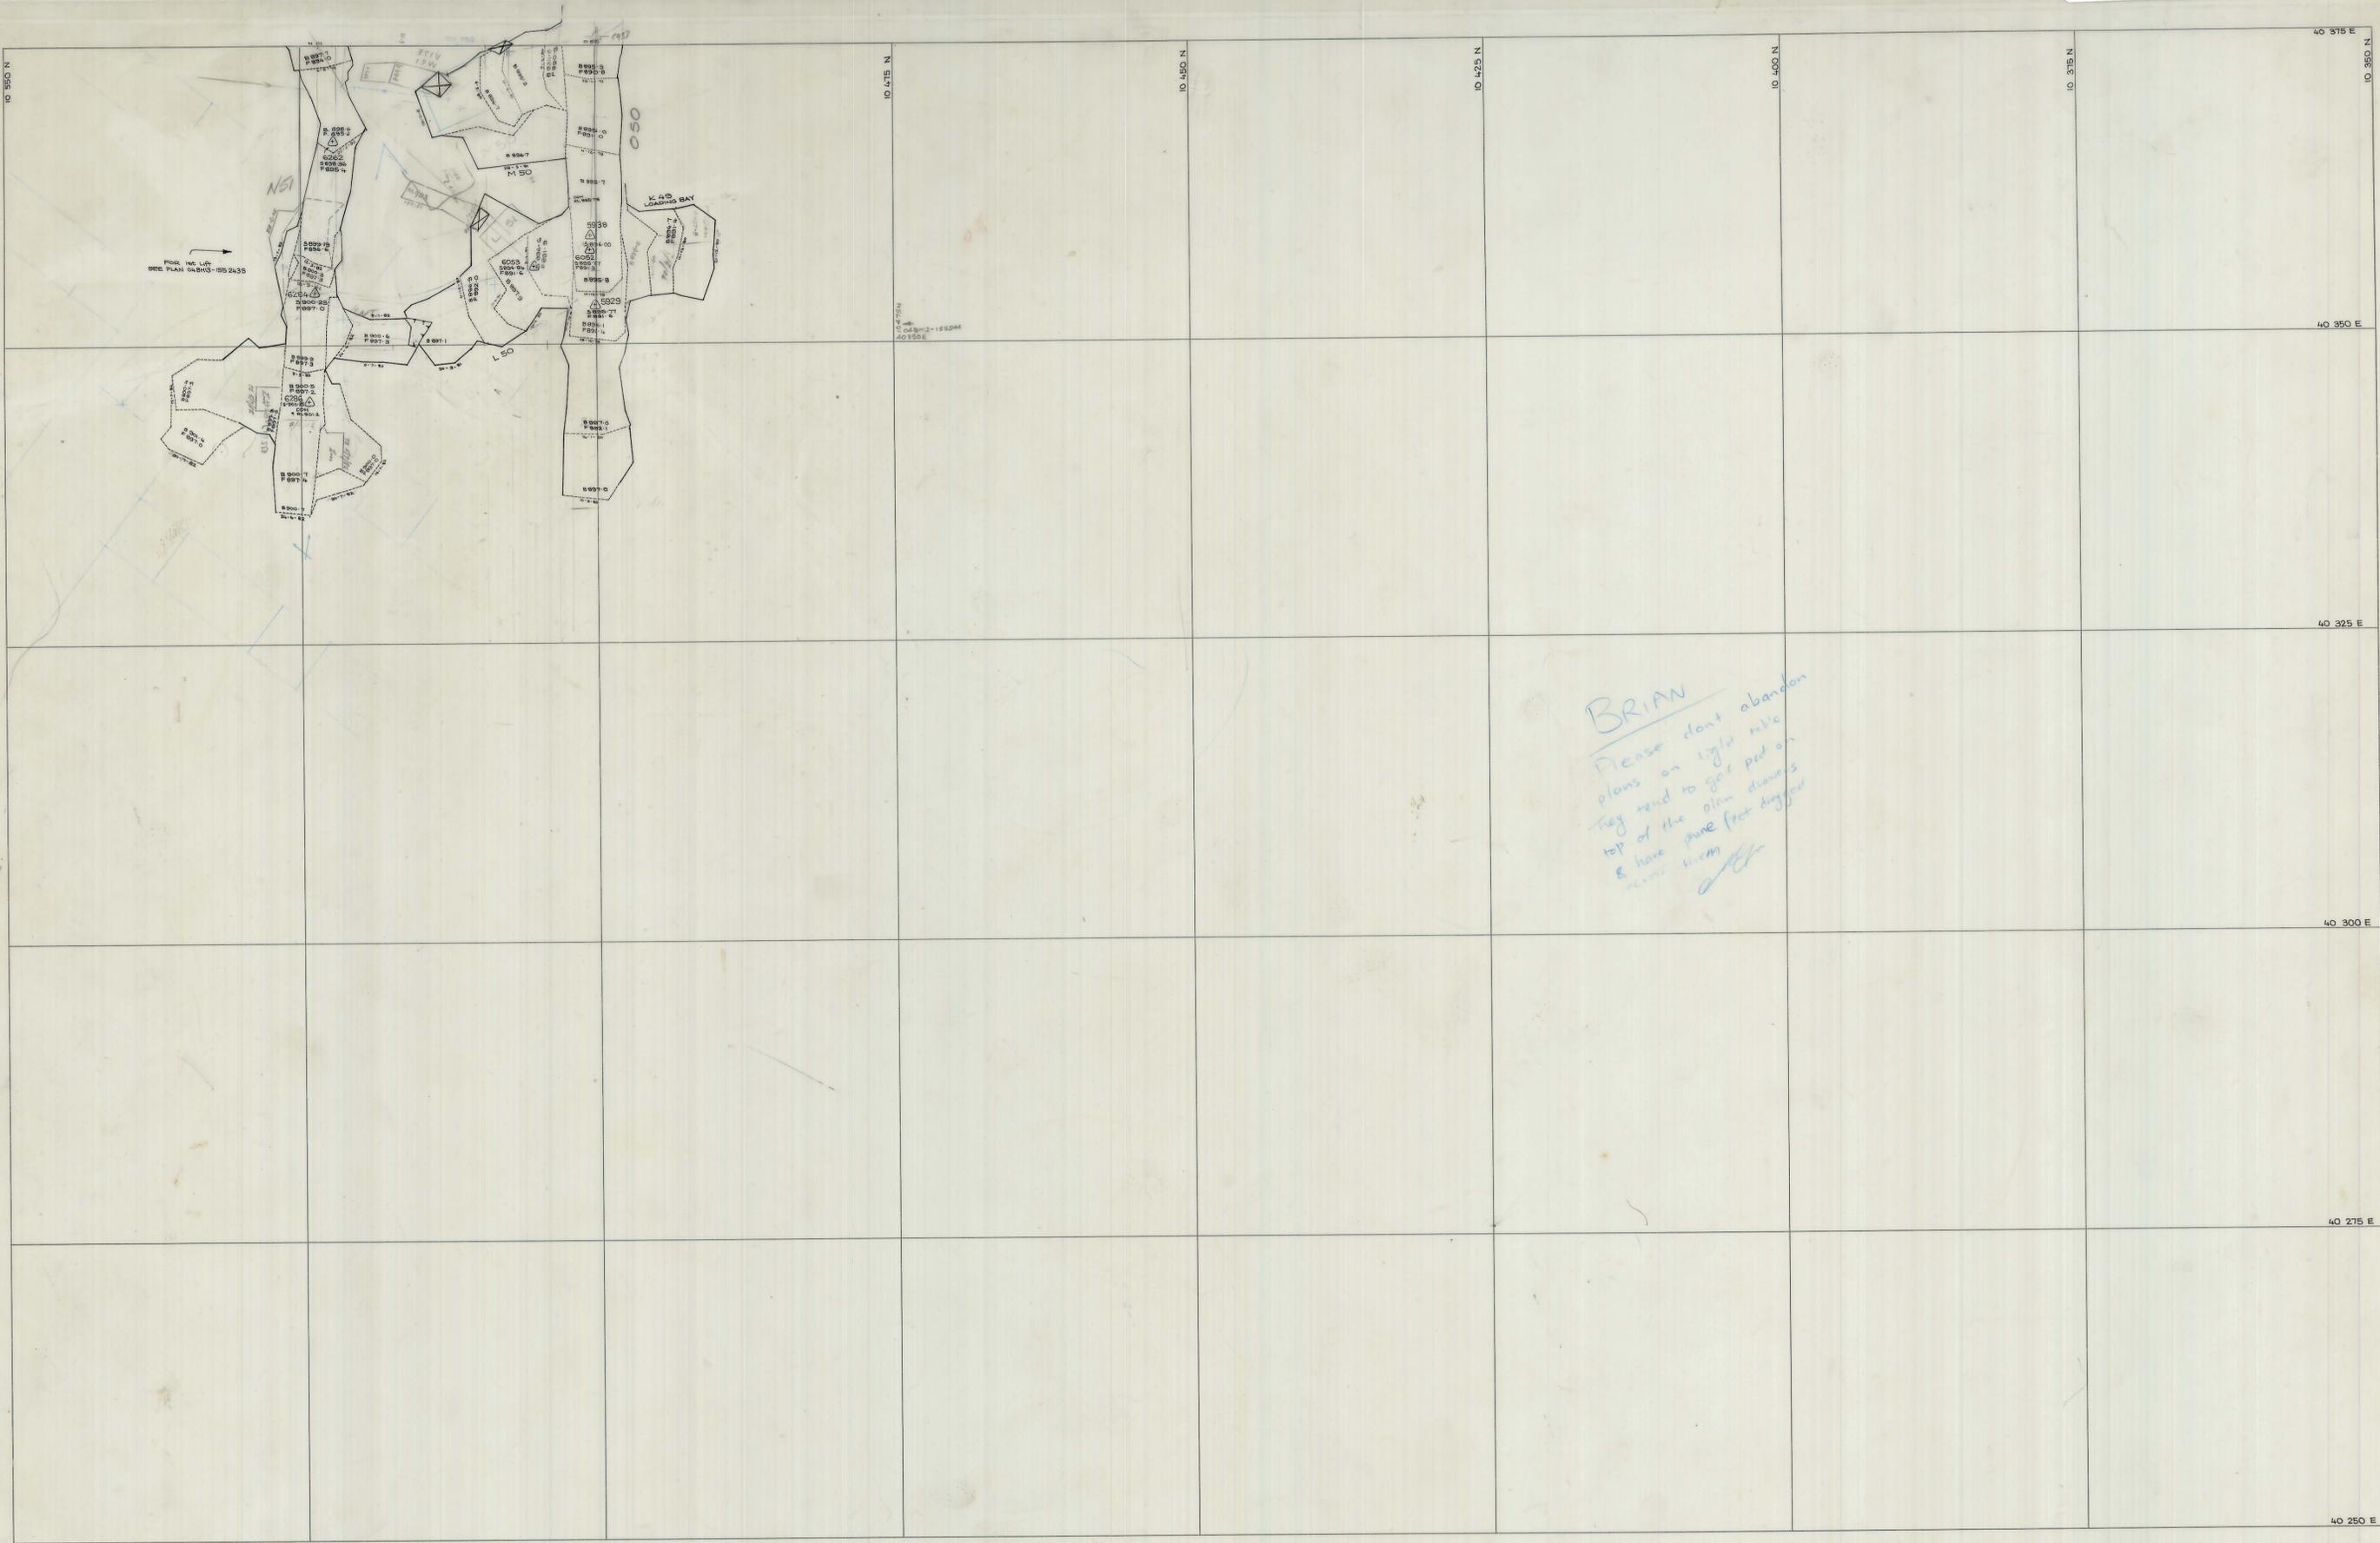

BRIAN
 Please don't abandon
 plans on 1st/2nd mile
 try send to get part on
 top of the plan drawings
 & have them free digger
 Brian

SCALE 1:250

LOCATION

BOLD HEAD MINE

SUBJECT

LOWER C2 ACCESS

north

KIS KING ISLAND SCHEELITE
 A DIVISION OF WARMAN INTERNATIONAL

GRASSY KING ISLAND

PLAN NUMBER

04BH12 - 155 244

05-006
30/1/81