


5 cm

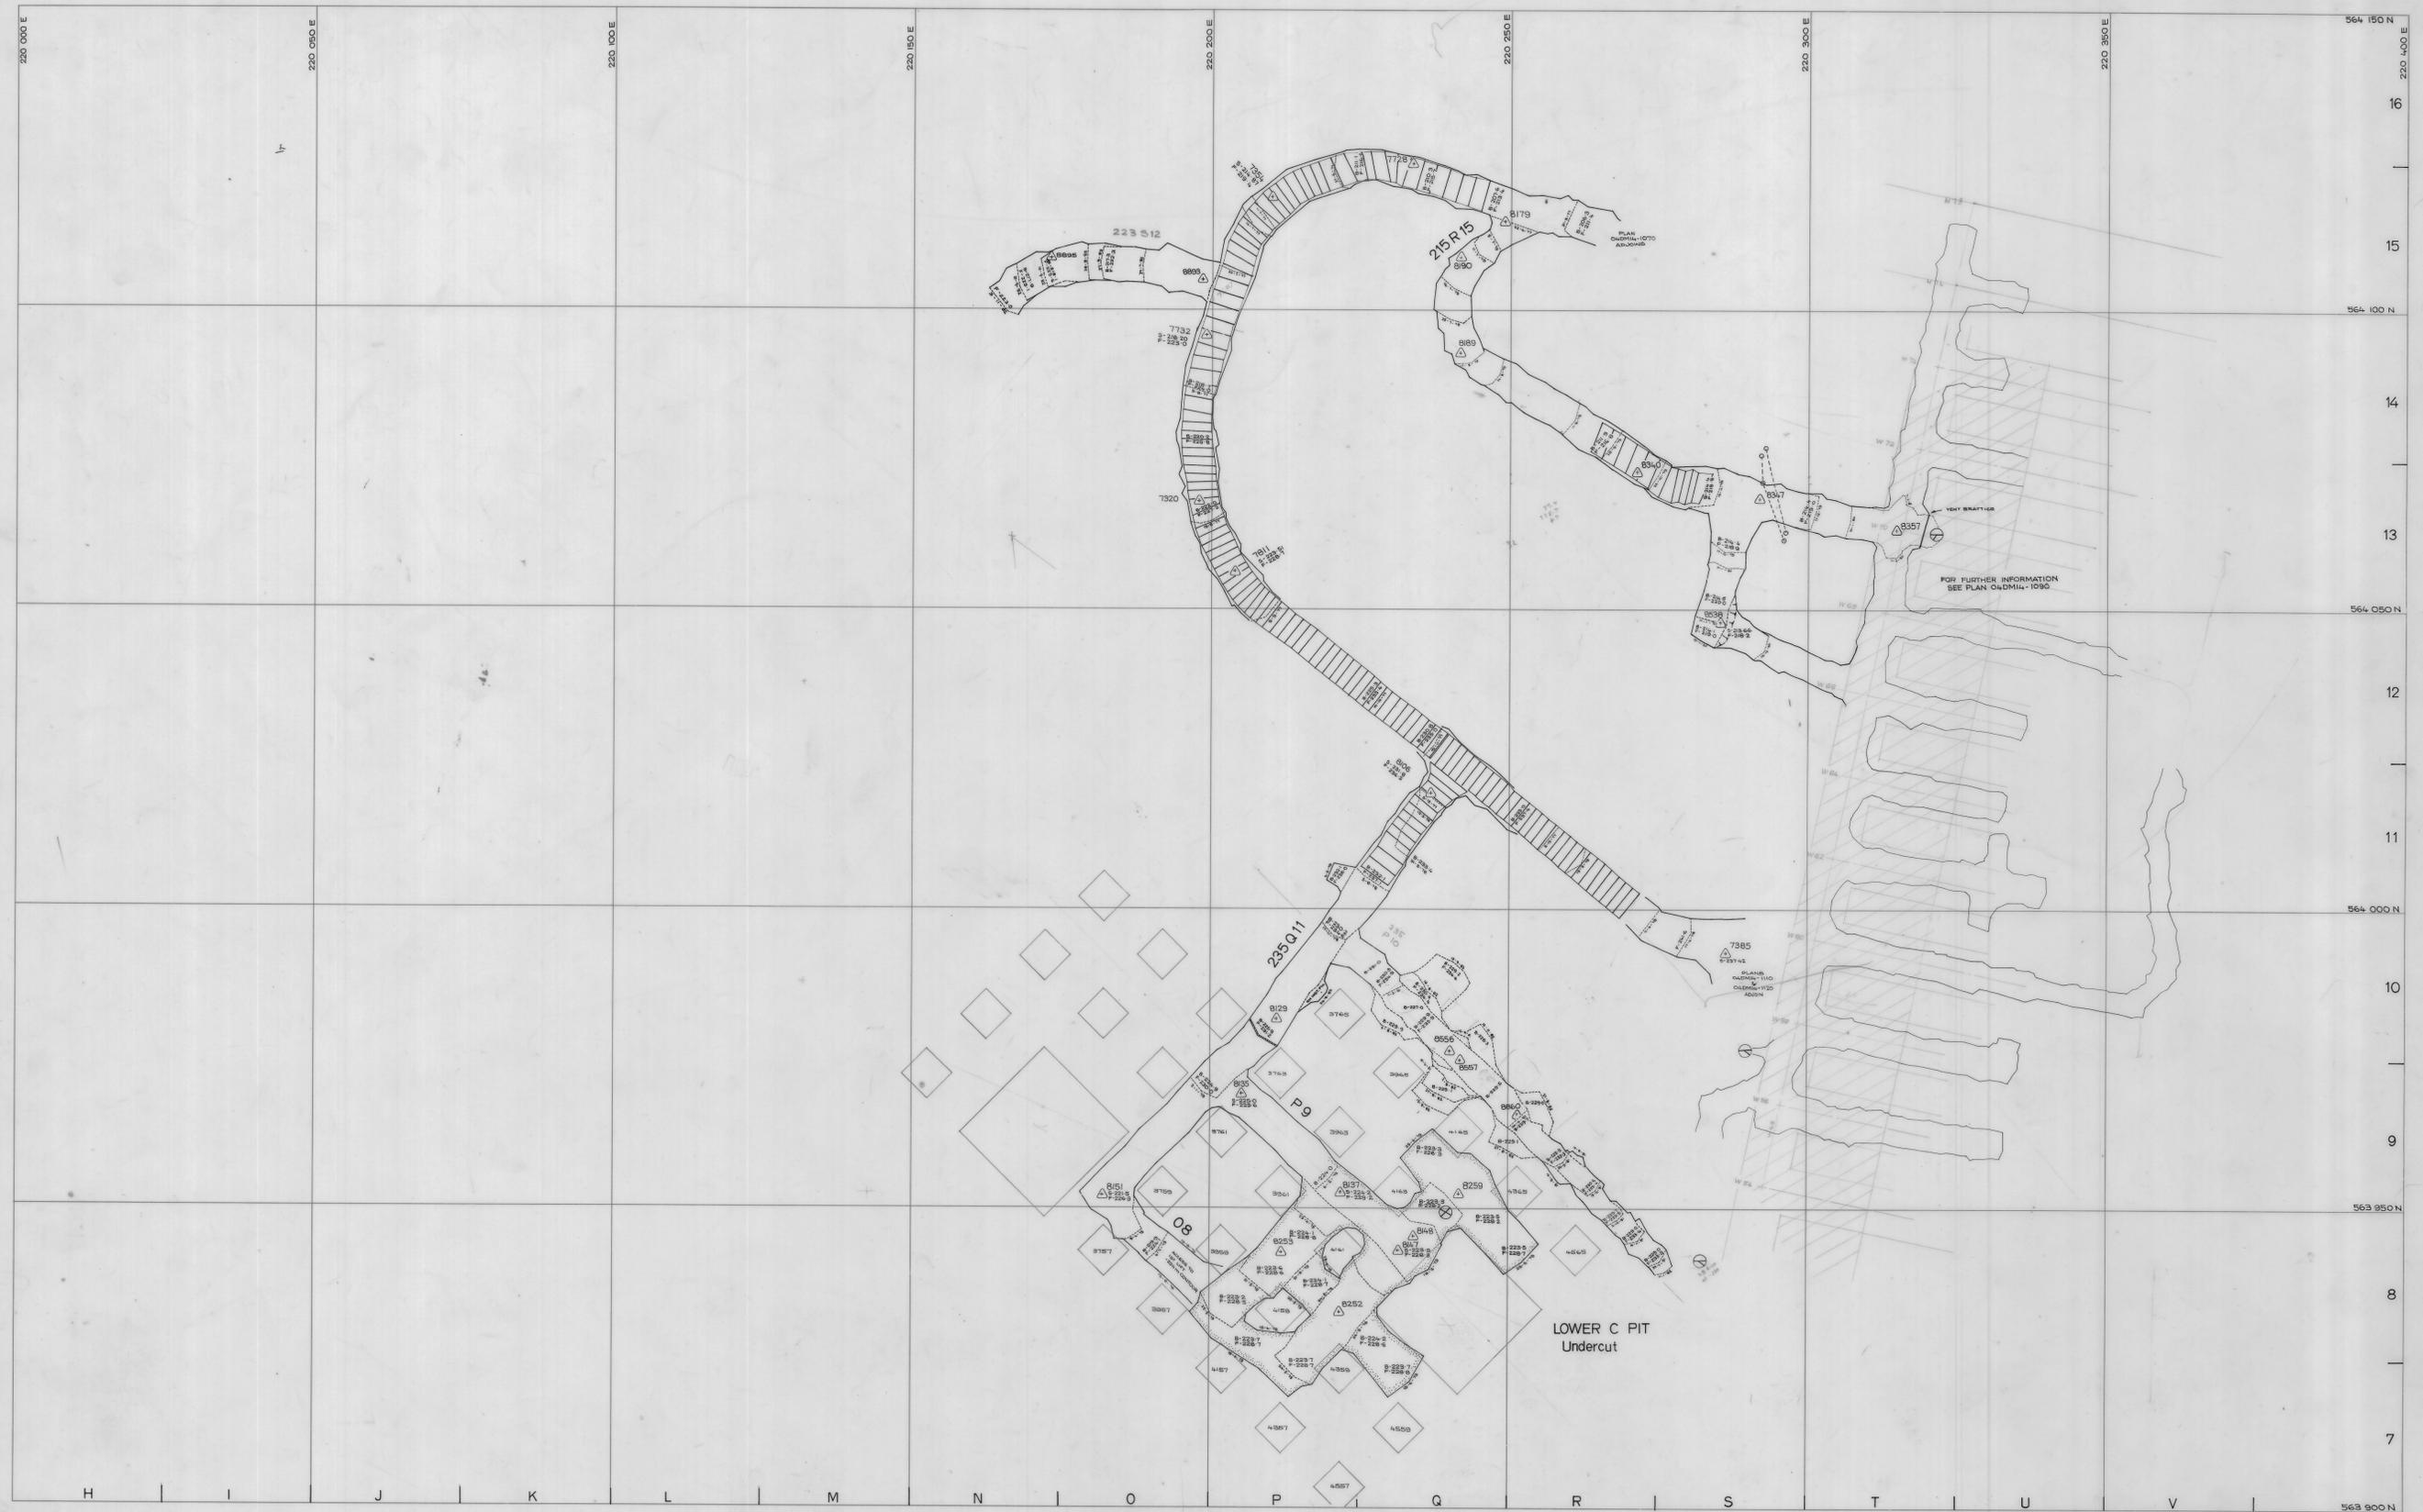

SCALE 1:500		LOCATION DOLPHIN MINE	 <small>A DIVISION OF BARRICK INTERNATIONAL</small> <small>GRASSY KING ISLAND</small>
north		SUBJECT - 225 m ZONE F-213m to B-237m	
			PLAN NUMBER 04DM14 - 1100