


5 cm

0374\_4242

04 BH 11 - 1 86 112

P10  
FIRST LIFT

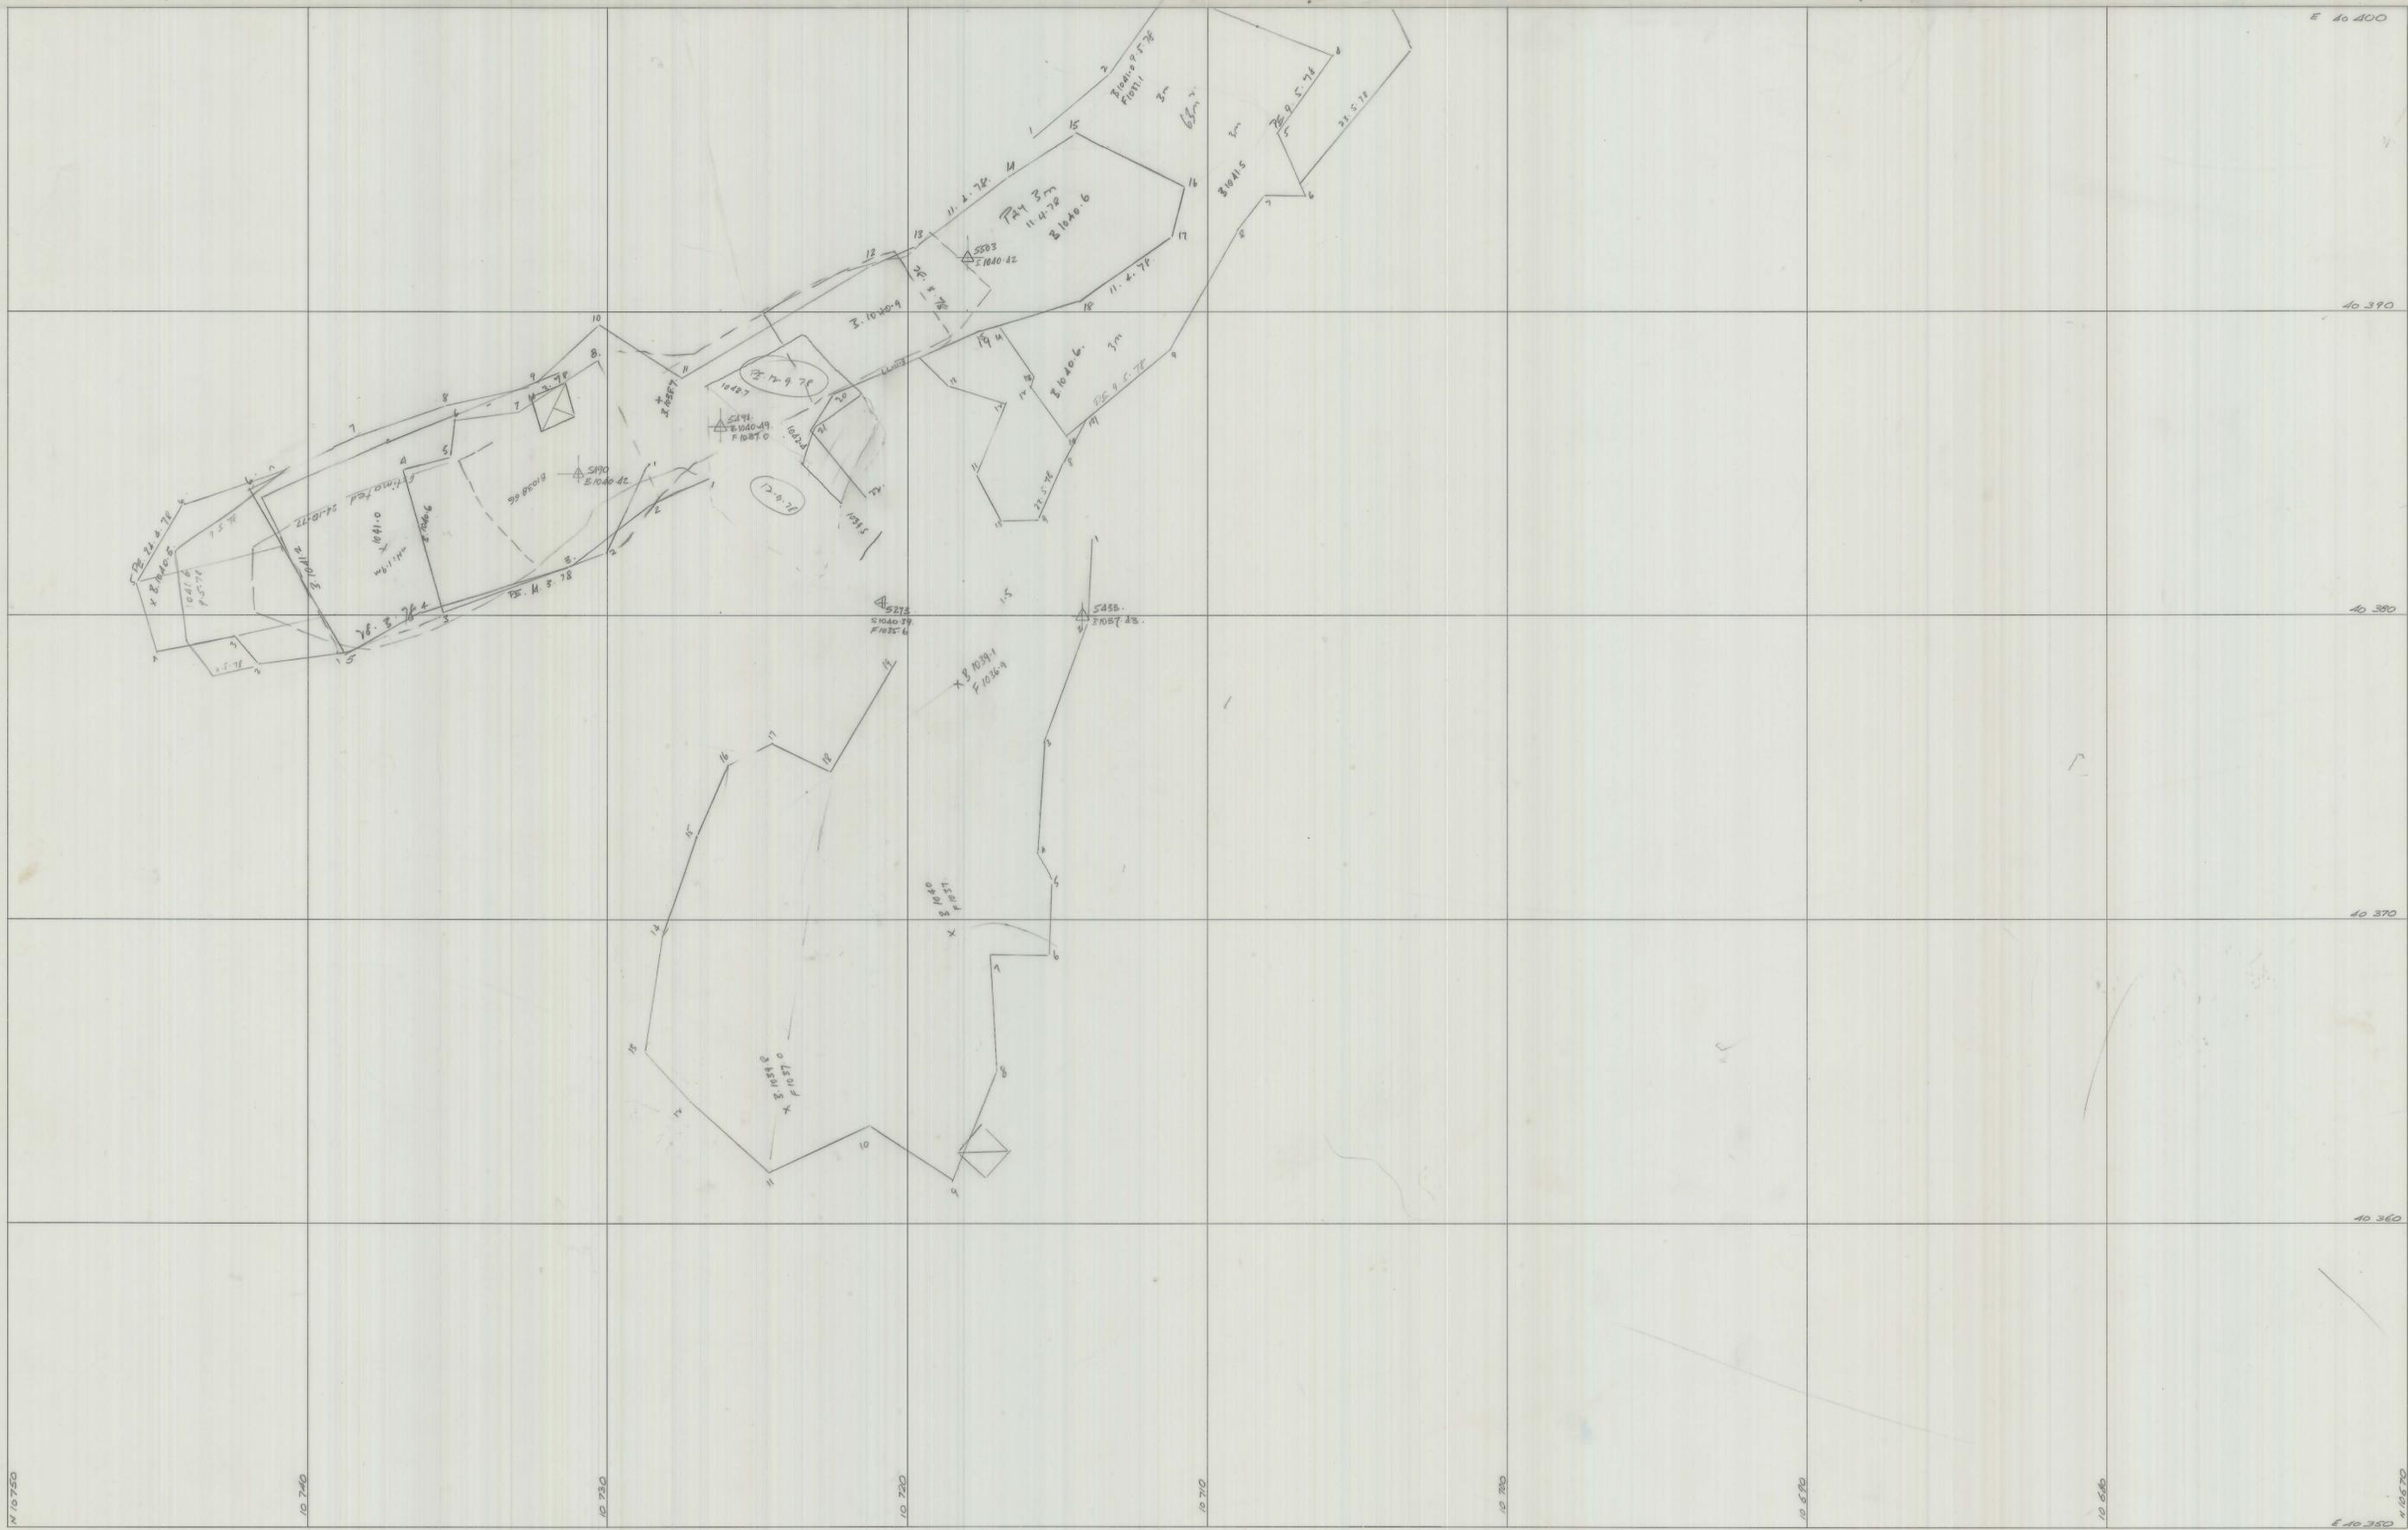

N 10 750  
10 740  
10 730  
10 720  
10 710  
10 700  
10 690  
10 680  
E 40 350  
E 40 360  
E 40 370  
E 40 380  
E 40 390  
E 40 400

	SCALE 1	LOCATION	
		SUBJECT	
		north	GRASSY KING ISLAND
			PLAN NUMBER