


5 cm

0374_4244

04 BH 11-157 114

D70 Slope

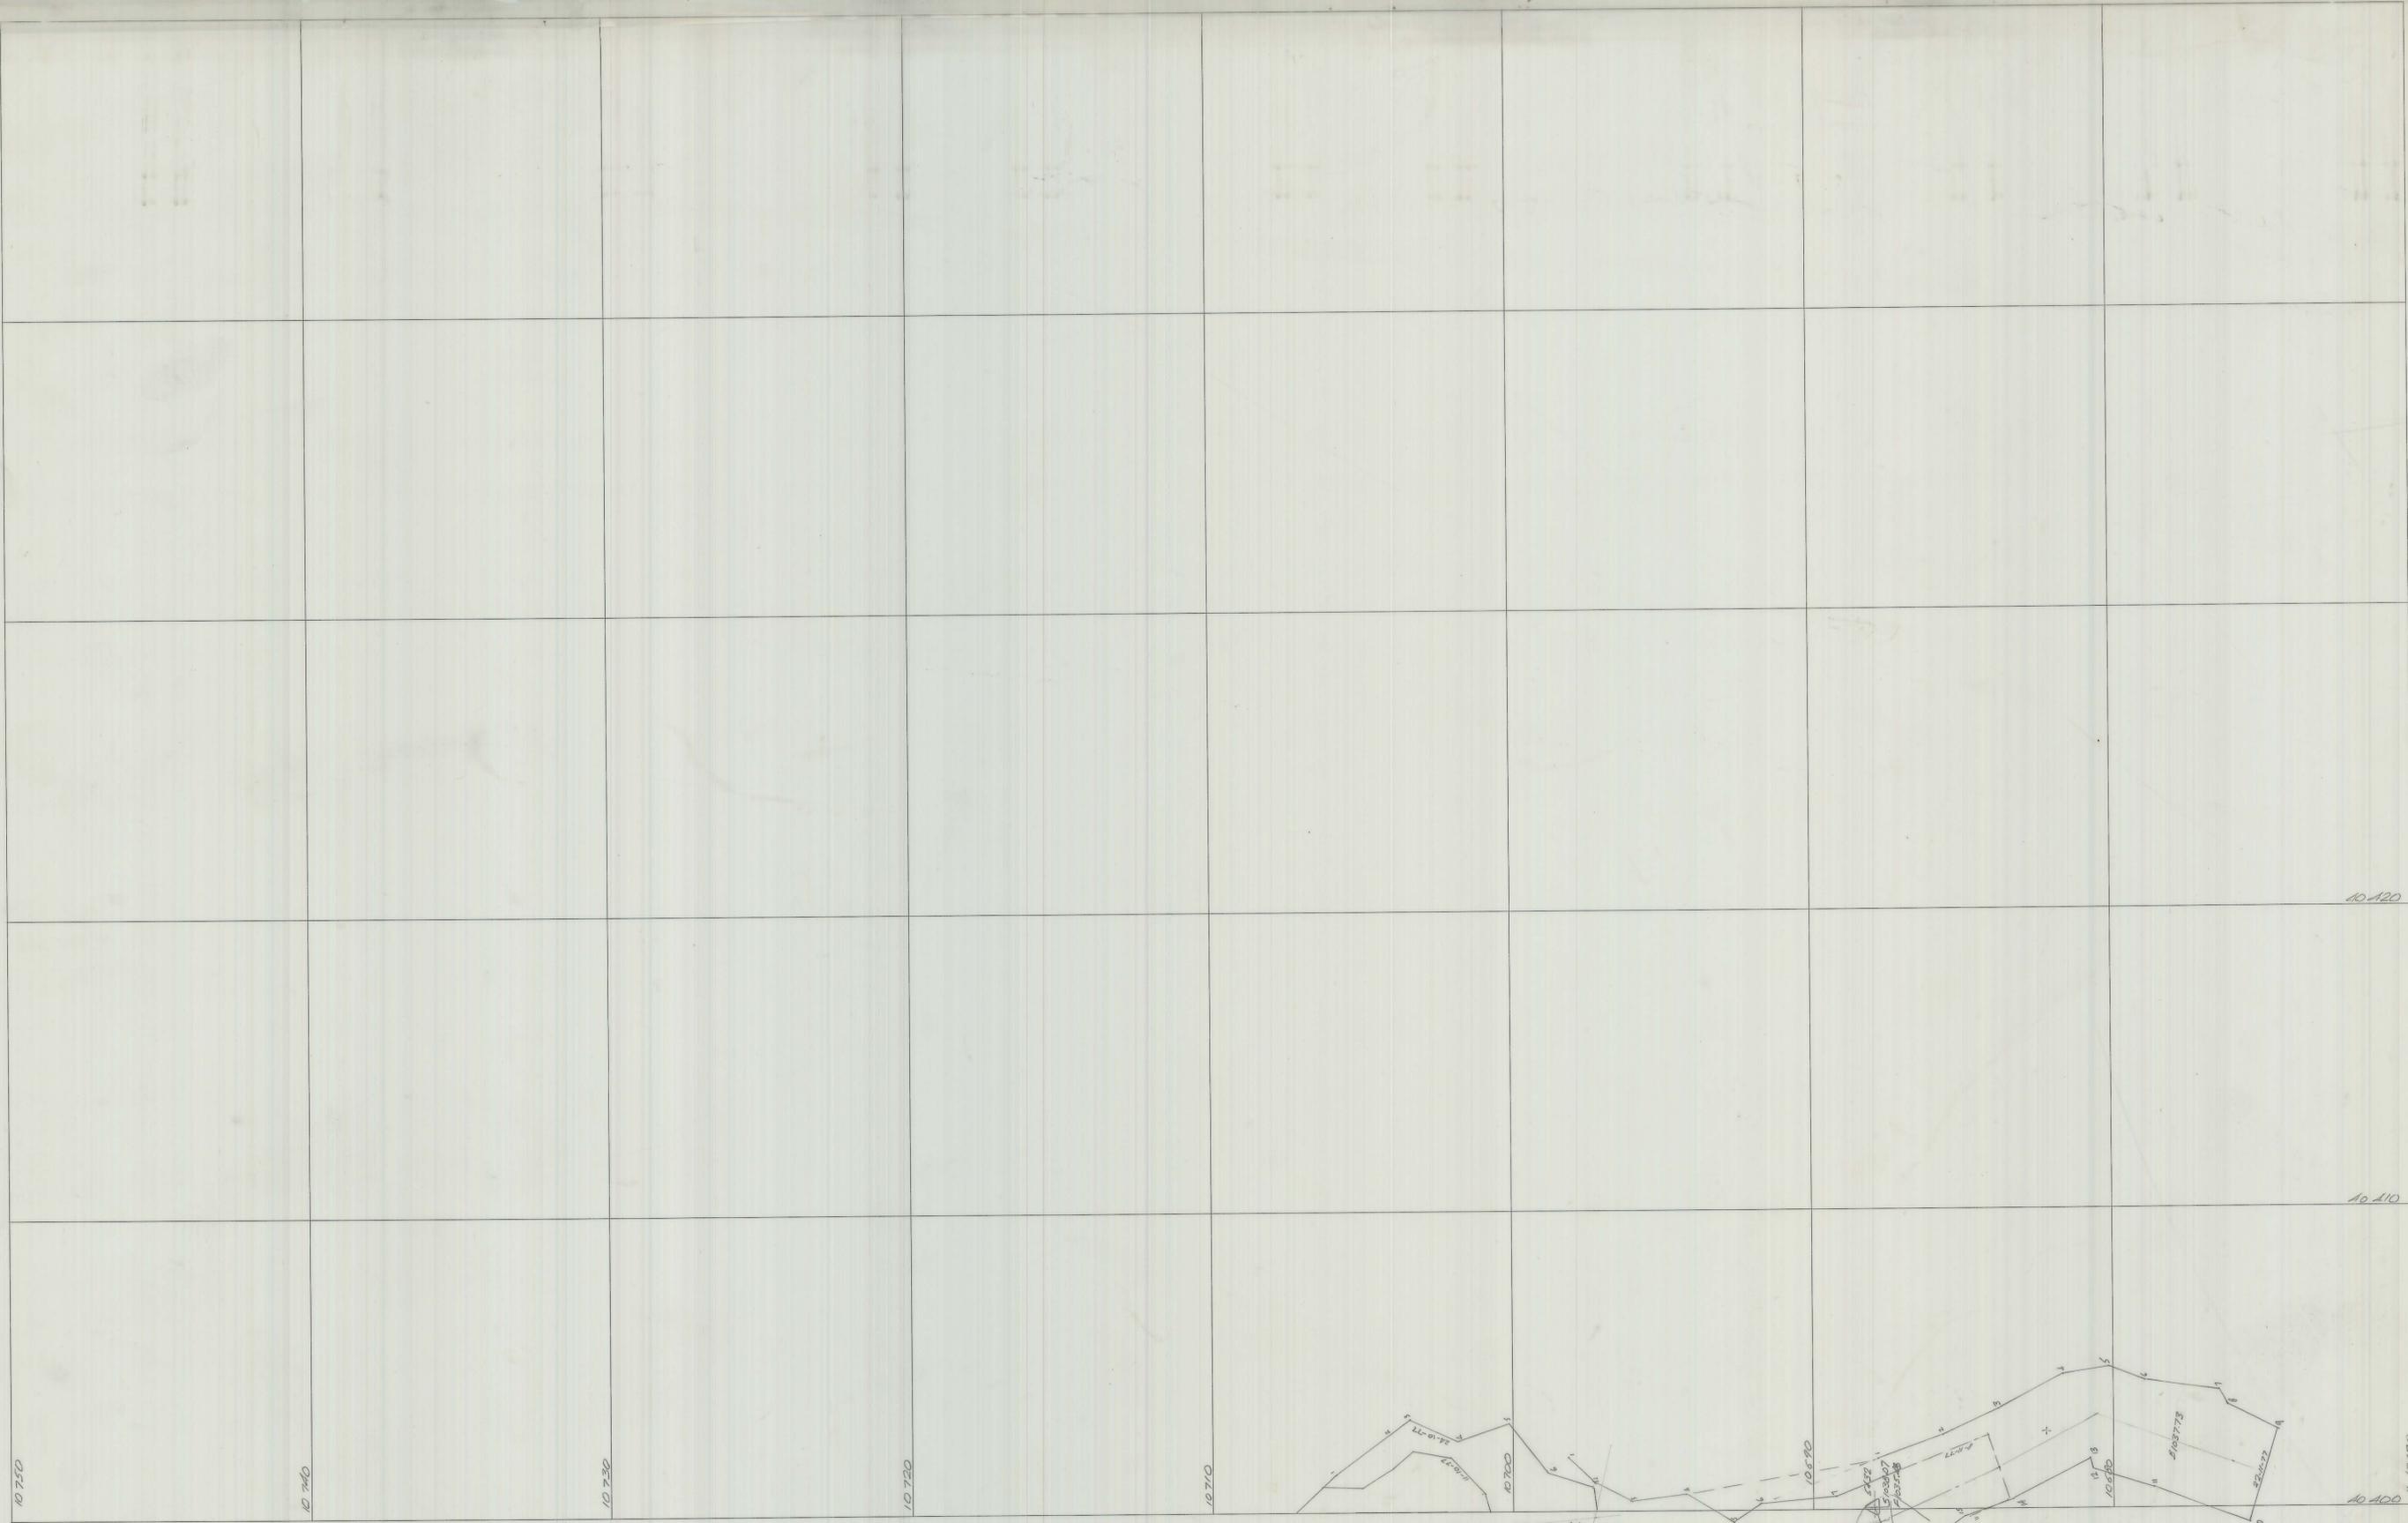

10 750

10 740

10 730

10 720

10 710

Sheet 04 BH 11-156 114 Adjoins

10 690

10 680

10 670

10 660

SCALE 1

LOCATION

SUBJECT

north

KIS KING ISLAND SCHEELITE
A DIVISION OF WARHAM INTERNATIONAL

GRASSY KING ISLAND

PLAN NUMBER