


27 JUN 1981

04BH12-155/05

0374\_4248

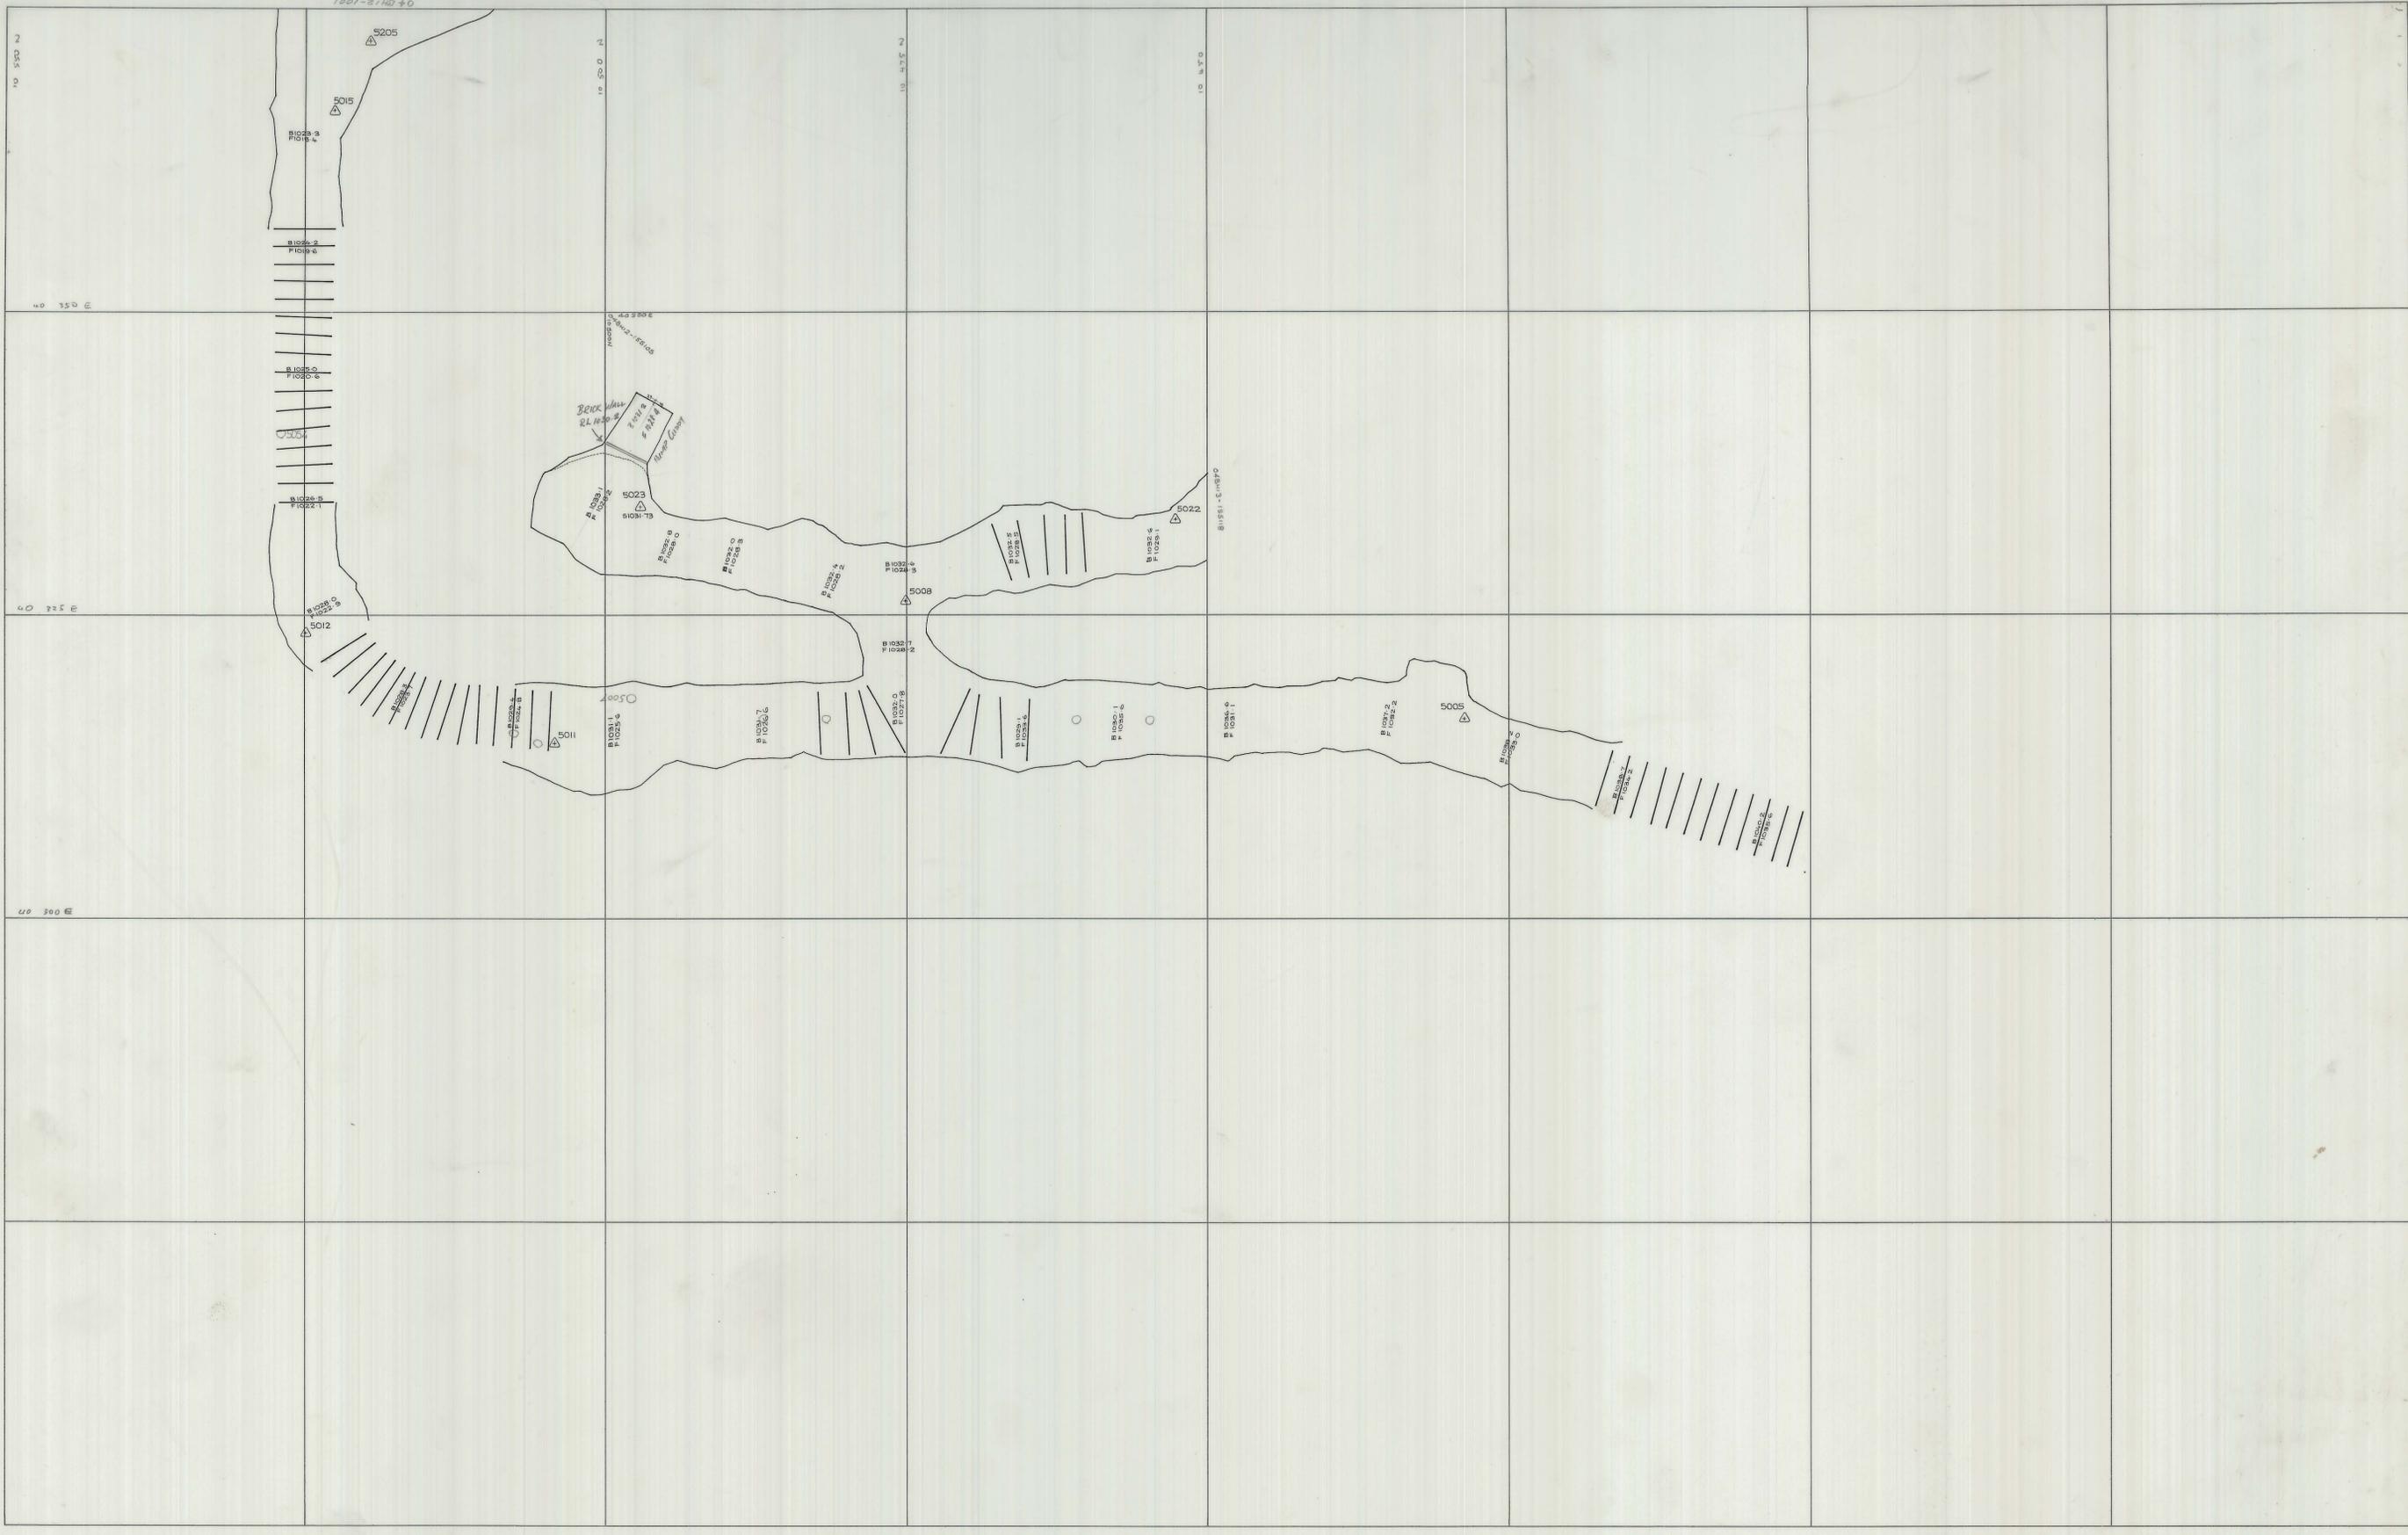

	SCALE 1: 250.	LOCATION BOLD HEAD MINE SUBJECT MAIN DECLINE (ACCESS TO A LEVEL) north	 KING ISLAND SCHEELITE A DIVISION OF WARMAN INTERNATIONAL GRASSY KING ISLAND PLAN NUMBER 04BH12-155/05
--	---------------	---	---