


5 cm

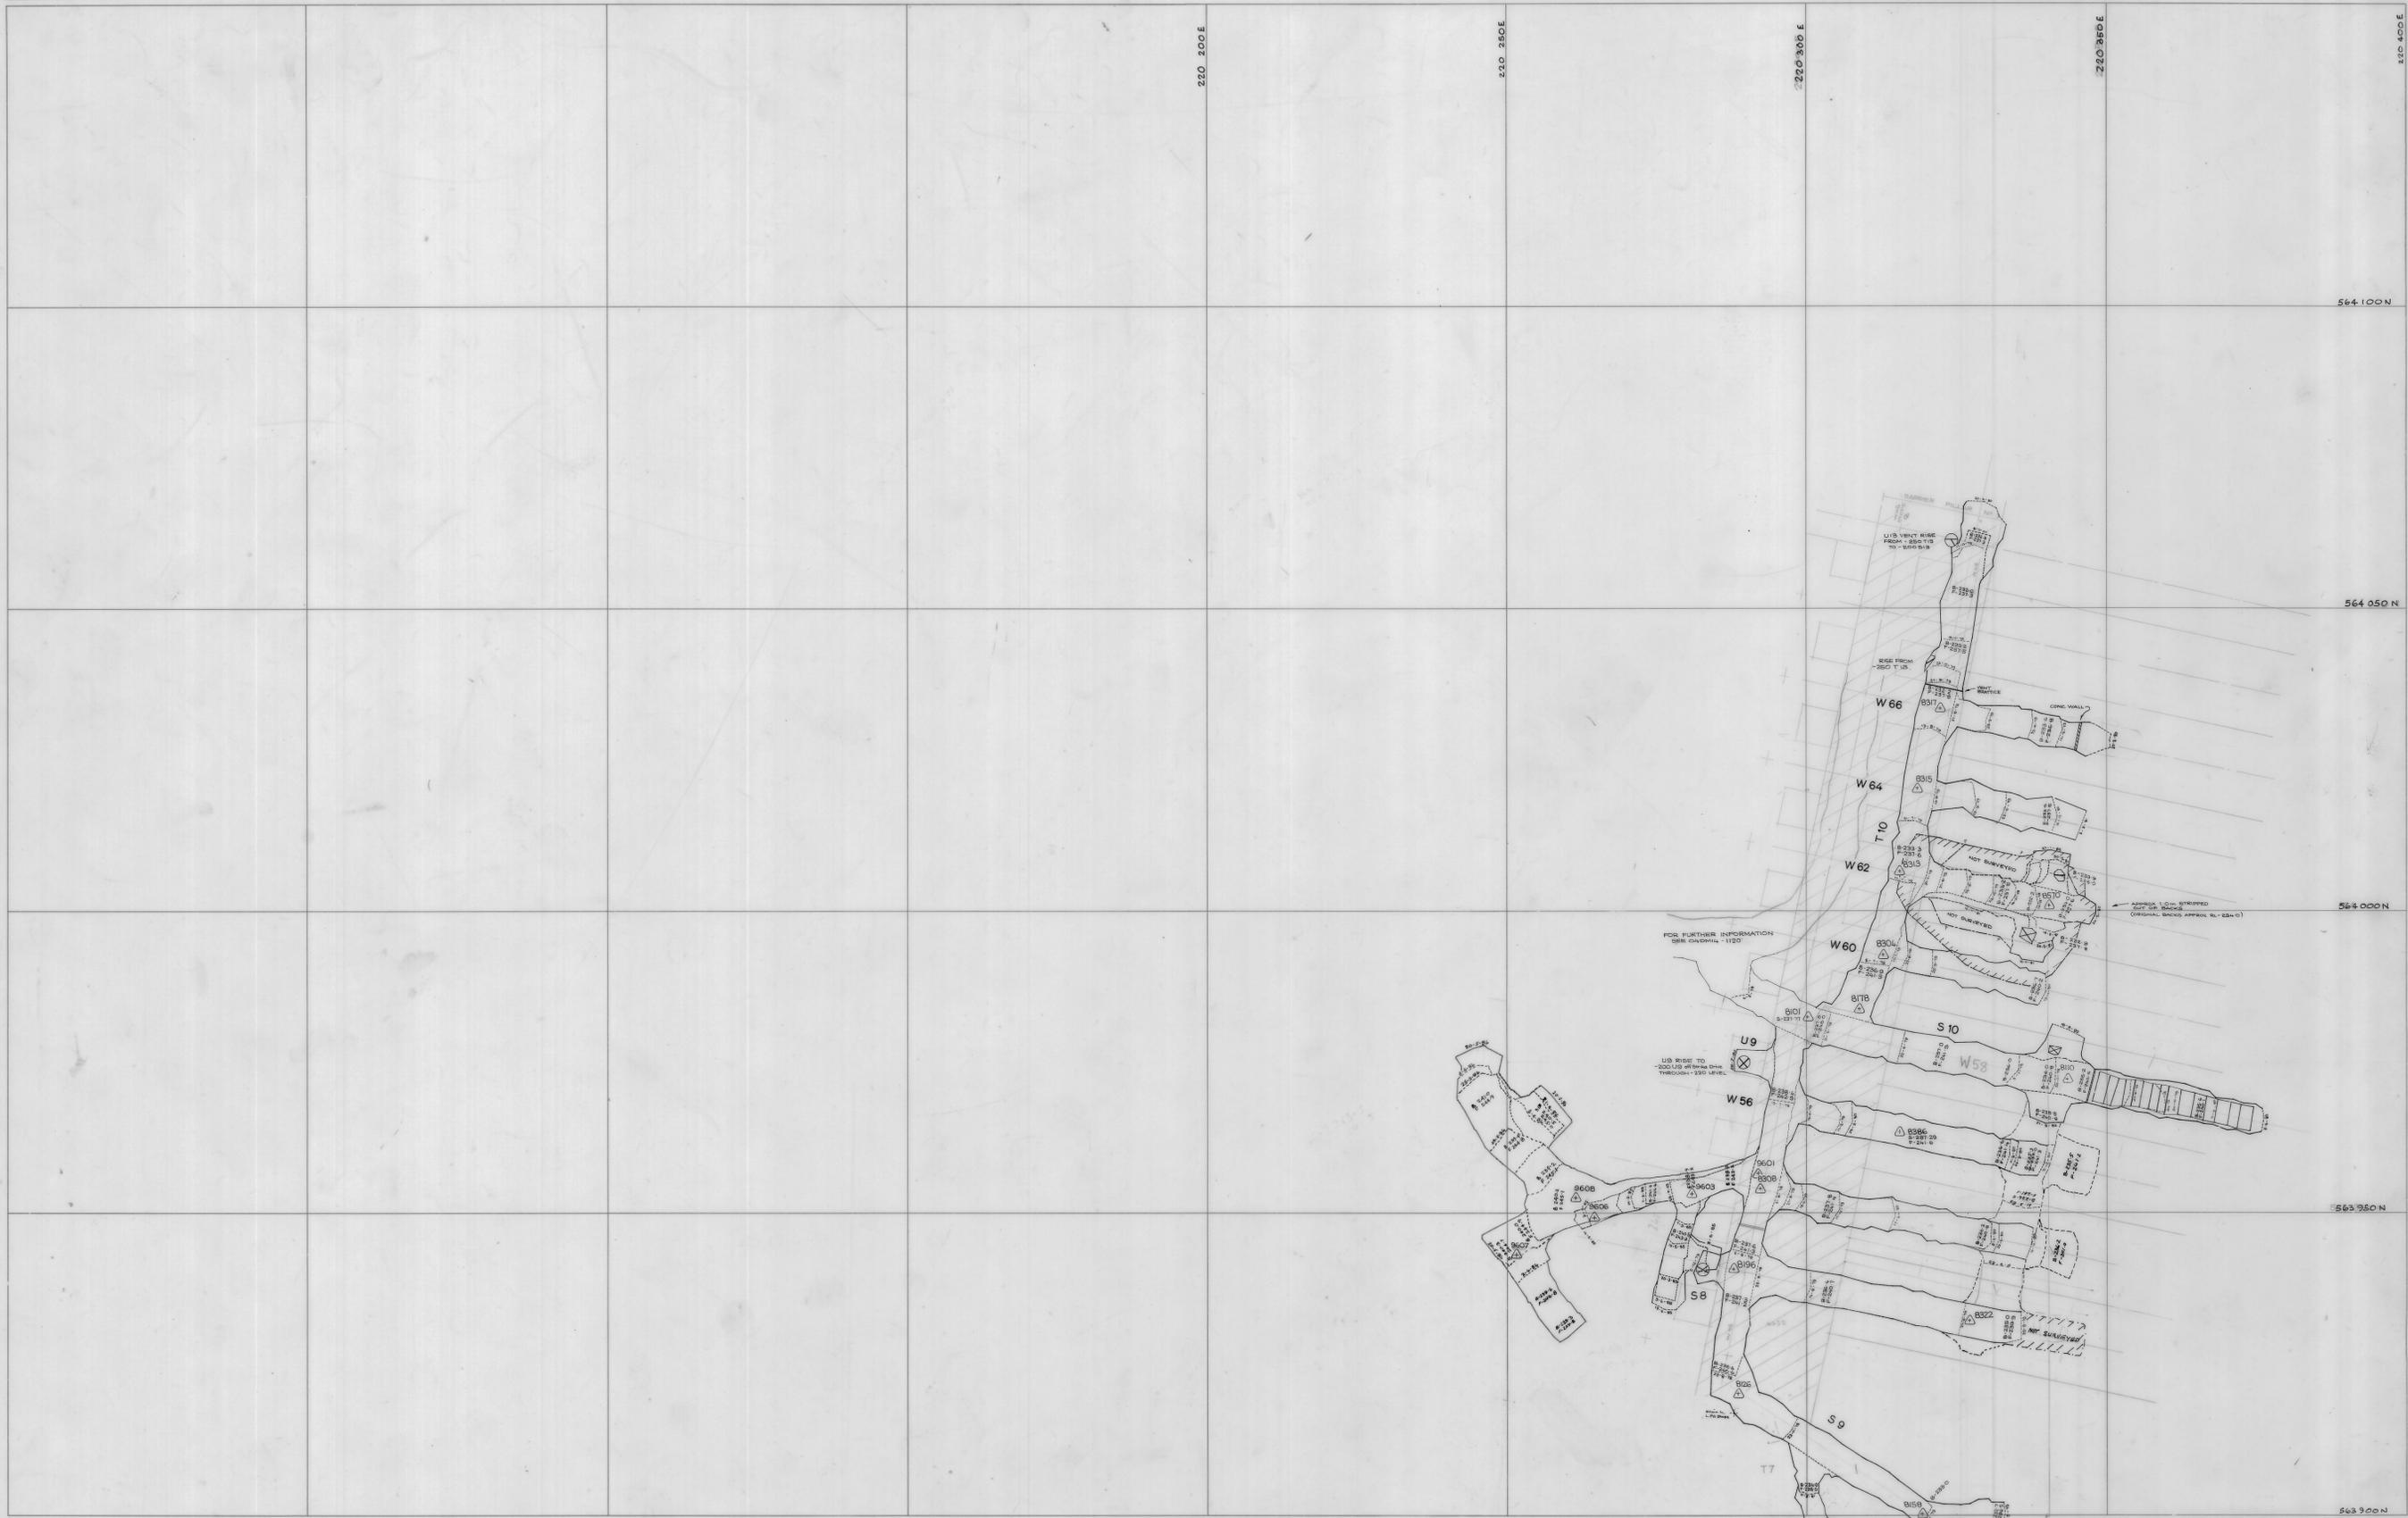

	<p>SCALE 1:500</p>	<p>LOCATION DOLPHIN MINE</p> <p>SUBJECT LOWER WEDGE ACCESS -240m LEVEL</p> <p>north</p>	<p>KIS KING ISLAND SCHEELITE A DIVISION OF WARMAN INTERNATIONAL</p> <p>GRASSY KING ISLAND</p> <p>PLAN NUMBER 04DM14 - 1110</p>
--	--------------------	---	---