


5 cm

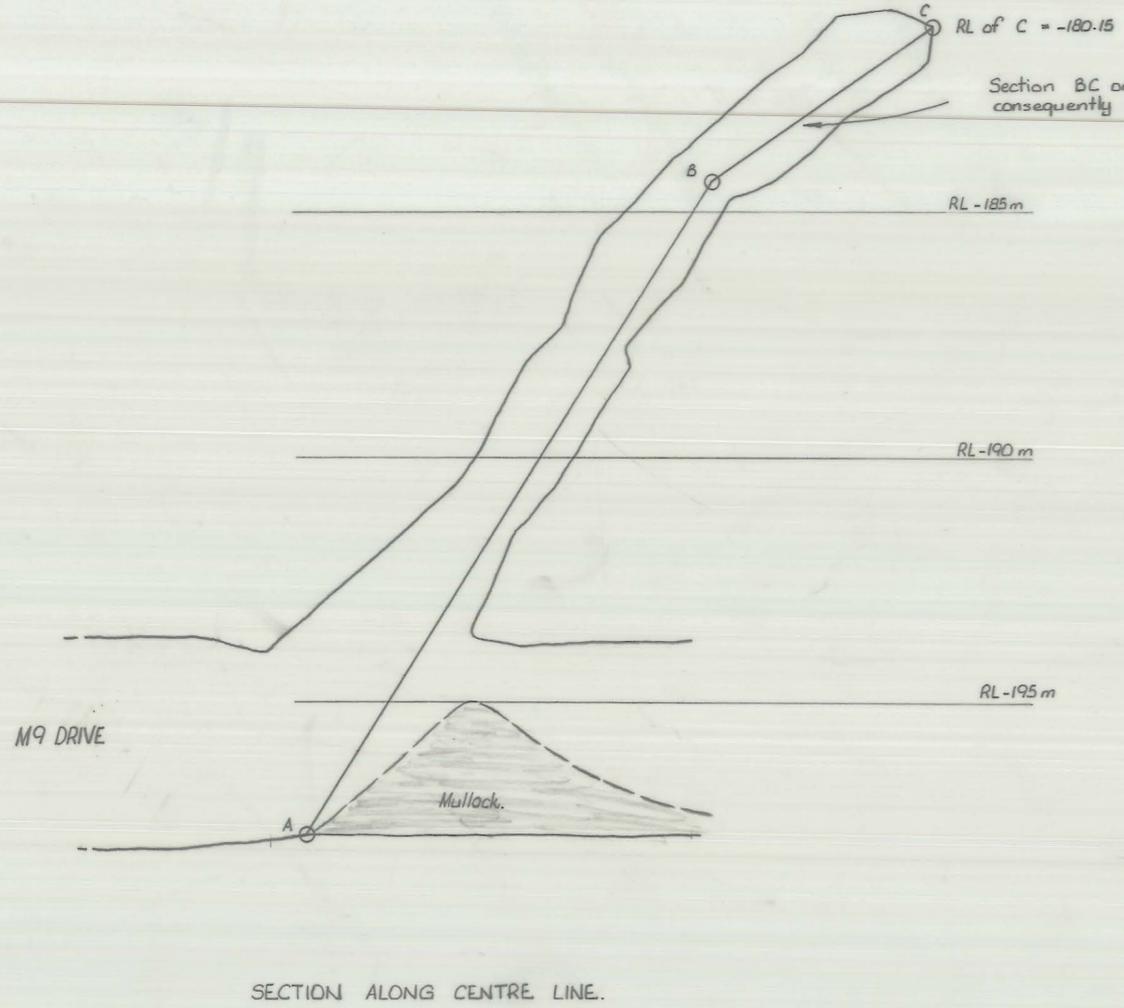

SCALE 1 : 100

LOCATION

-200 J9 RISE

SUBJECT

Plan & Long Section of Geological Exploration Rise in Pit Dag.

north

KIS KING ISLAND SCHEELITE
A DIVISION OF HARMAN INTERNATIONAL

GRASSY KING ISLAND

PLAN NUMBER

04 DM 29 - 2003