


5 cm

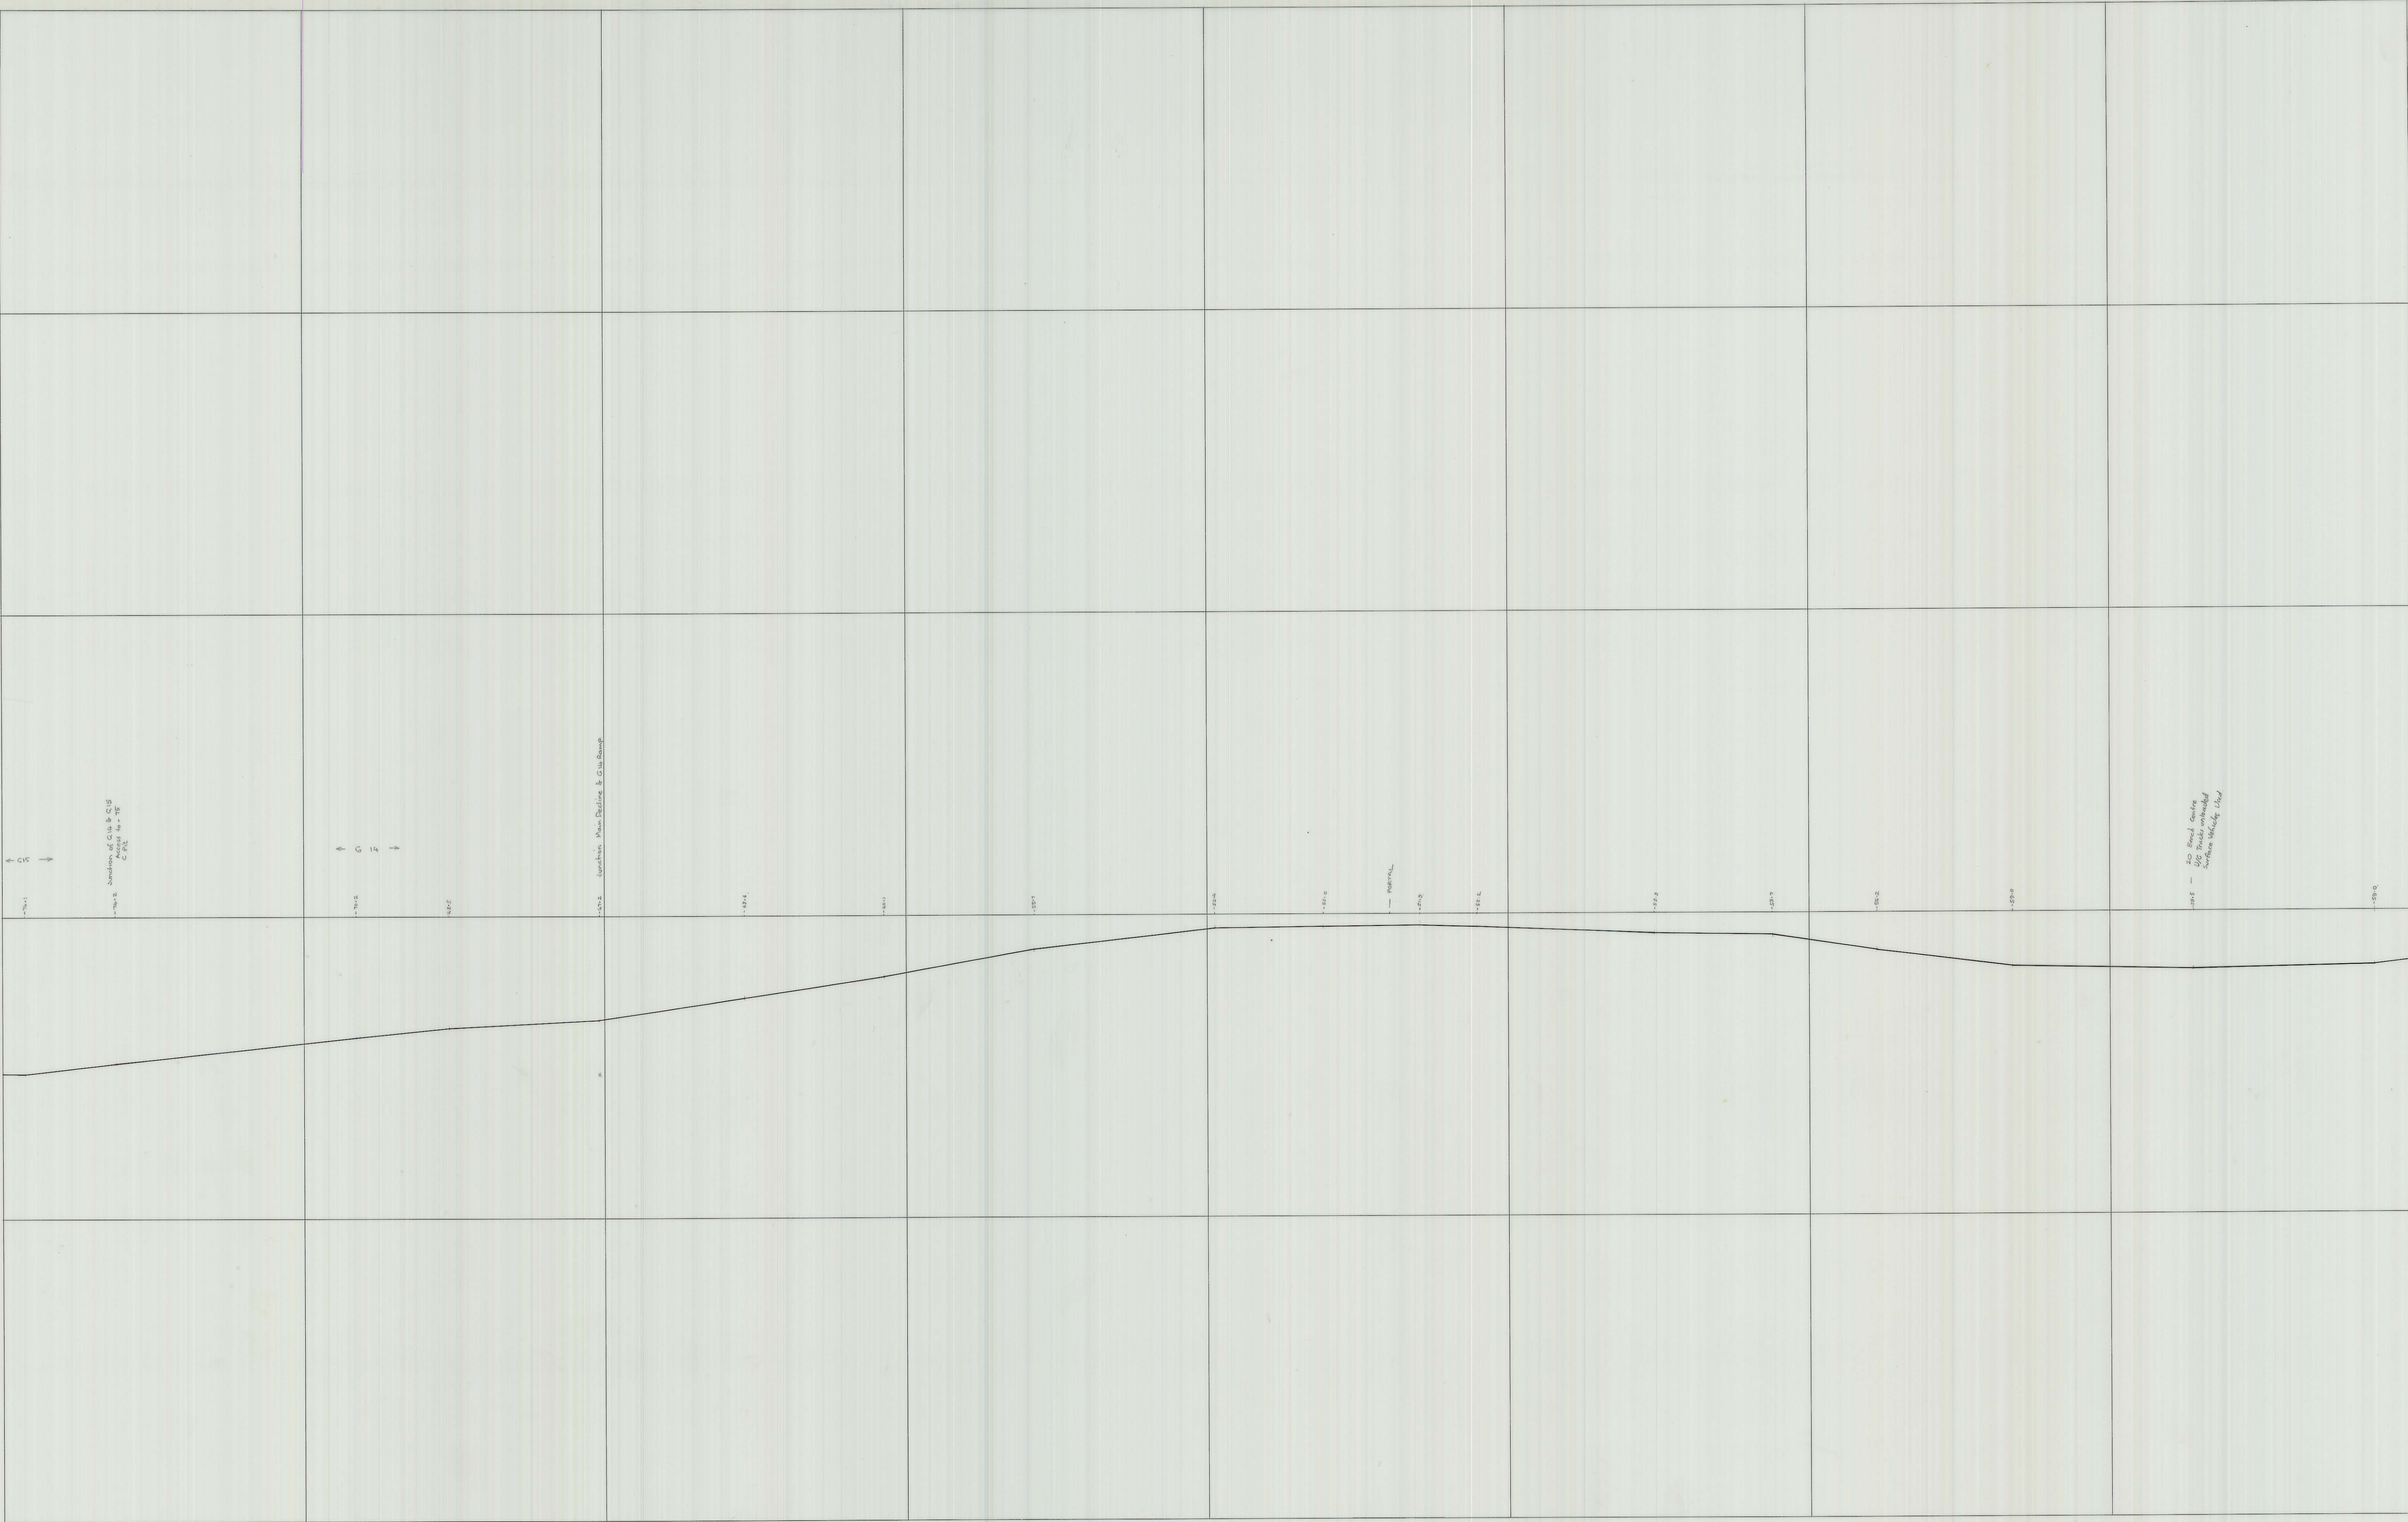

SCALE 1

north

LOCATION

SUBJECT

KIS KING ISLAND SCHEELITE
A DIVISION OF WARMAN INTERNATIONAL

GRASSY KING ISLAND

PLAN NUMBER