


27 JUN 1981

5 cm

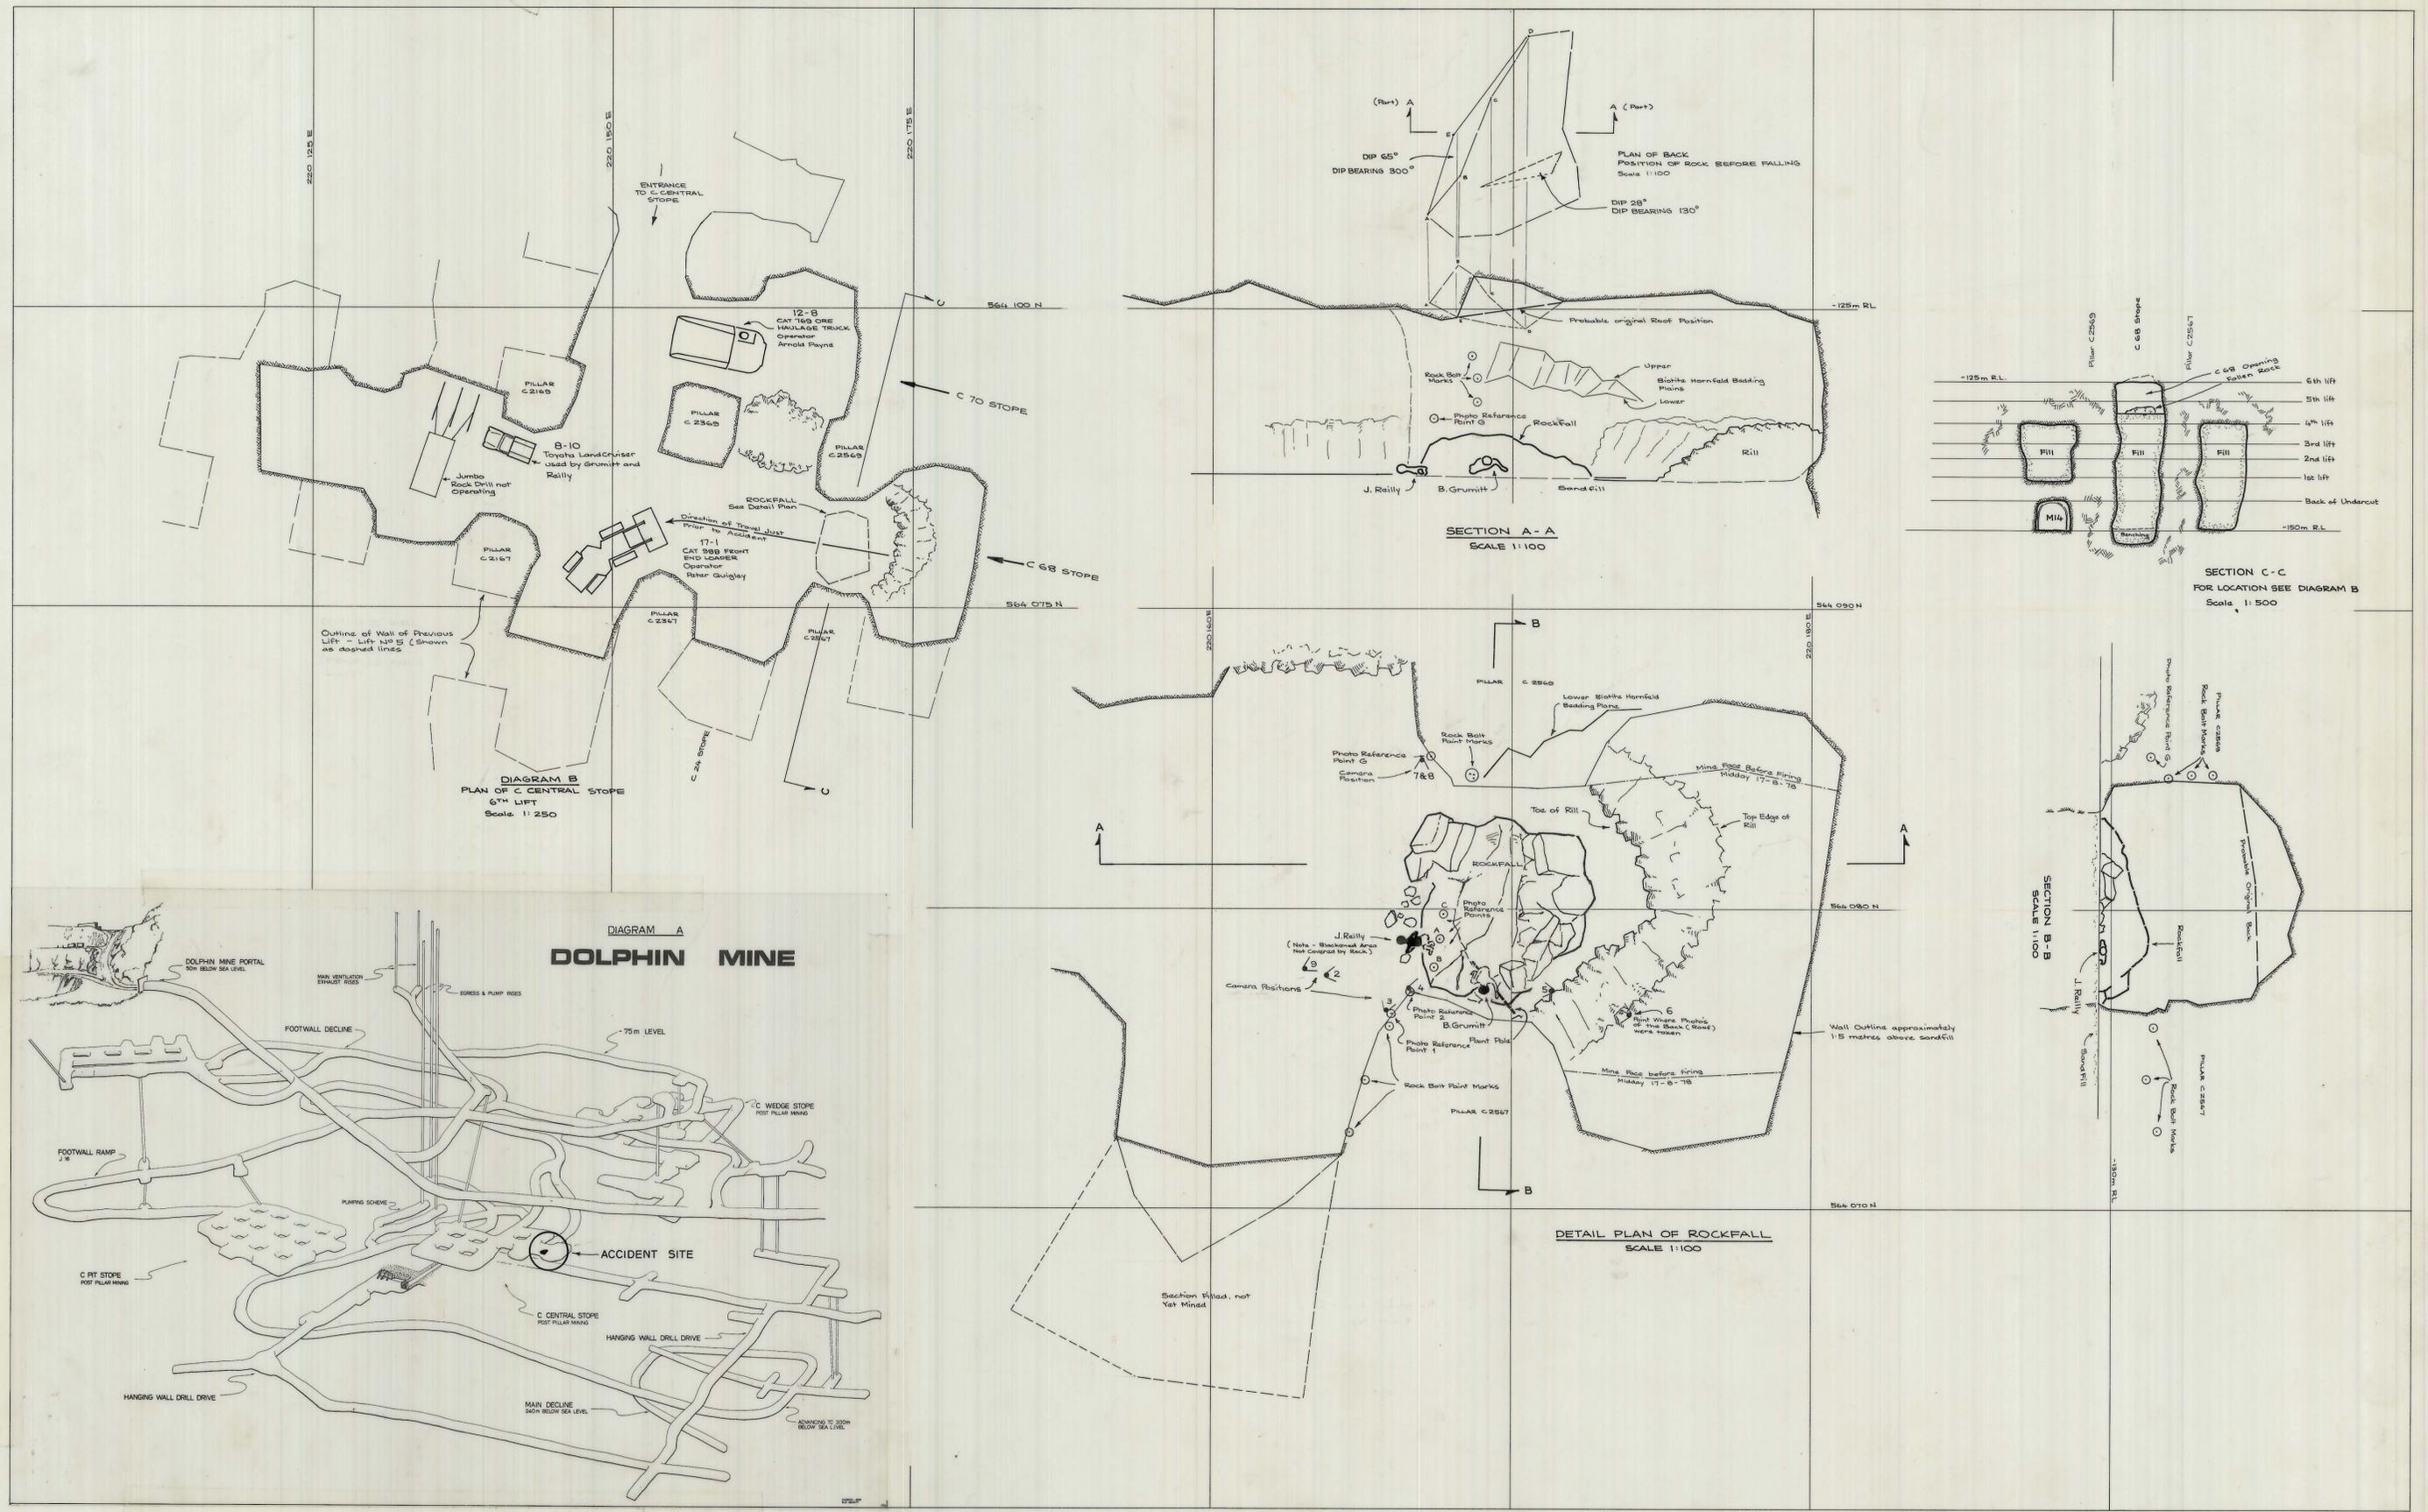

| | | | | | | |
|---------------------|----------|-------------|------------------|-------------|---------------|--|
| SENIOR SURVEYOR | SURVEYED | W. DAVIES | SCALE: SEE ABOVE | LOCATION | DOLPHIN MINE | |
| MINE SUPERINTENDENT | DATE | 18 - 8 - 78 | | | SUBJECT | FATAL ACCIDENT TO J. REILLY AND B. GRUMITT |
| | DRAWN | B. COLLIS | | PLAN NUMBER | 04DM30 - 1001 | |
| | TRACED | B. COLLIS | | | | |
| | DATE | 23 - 8 - 78 | | | | |
| | CHECKED | M. MARCHANT | | | | |

