


5 cm

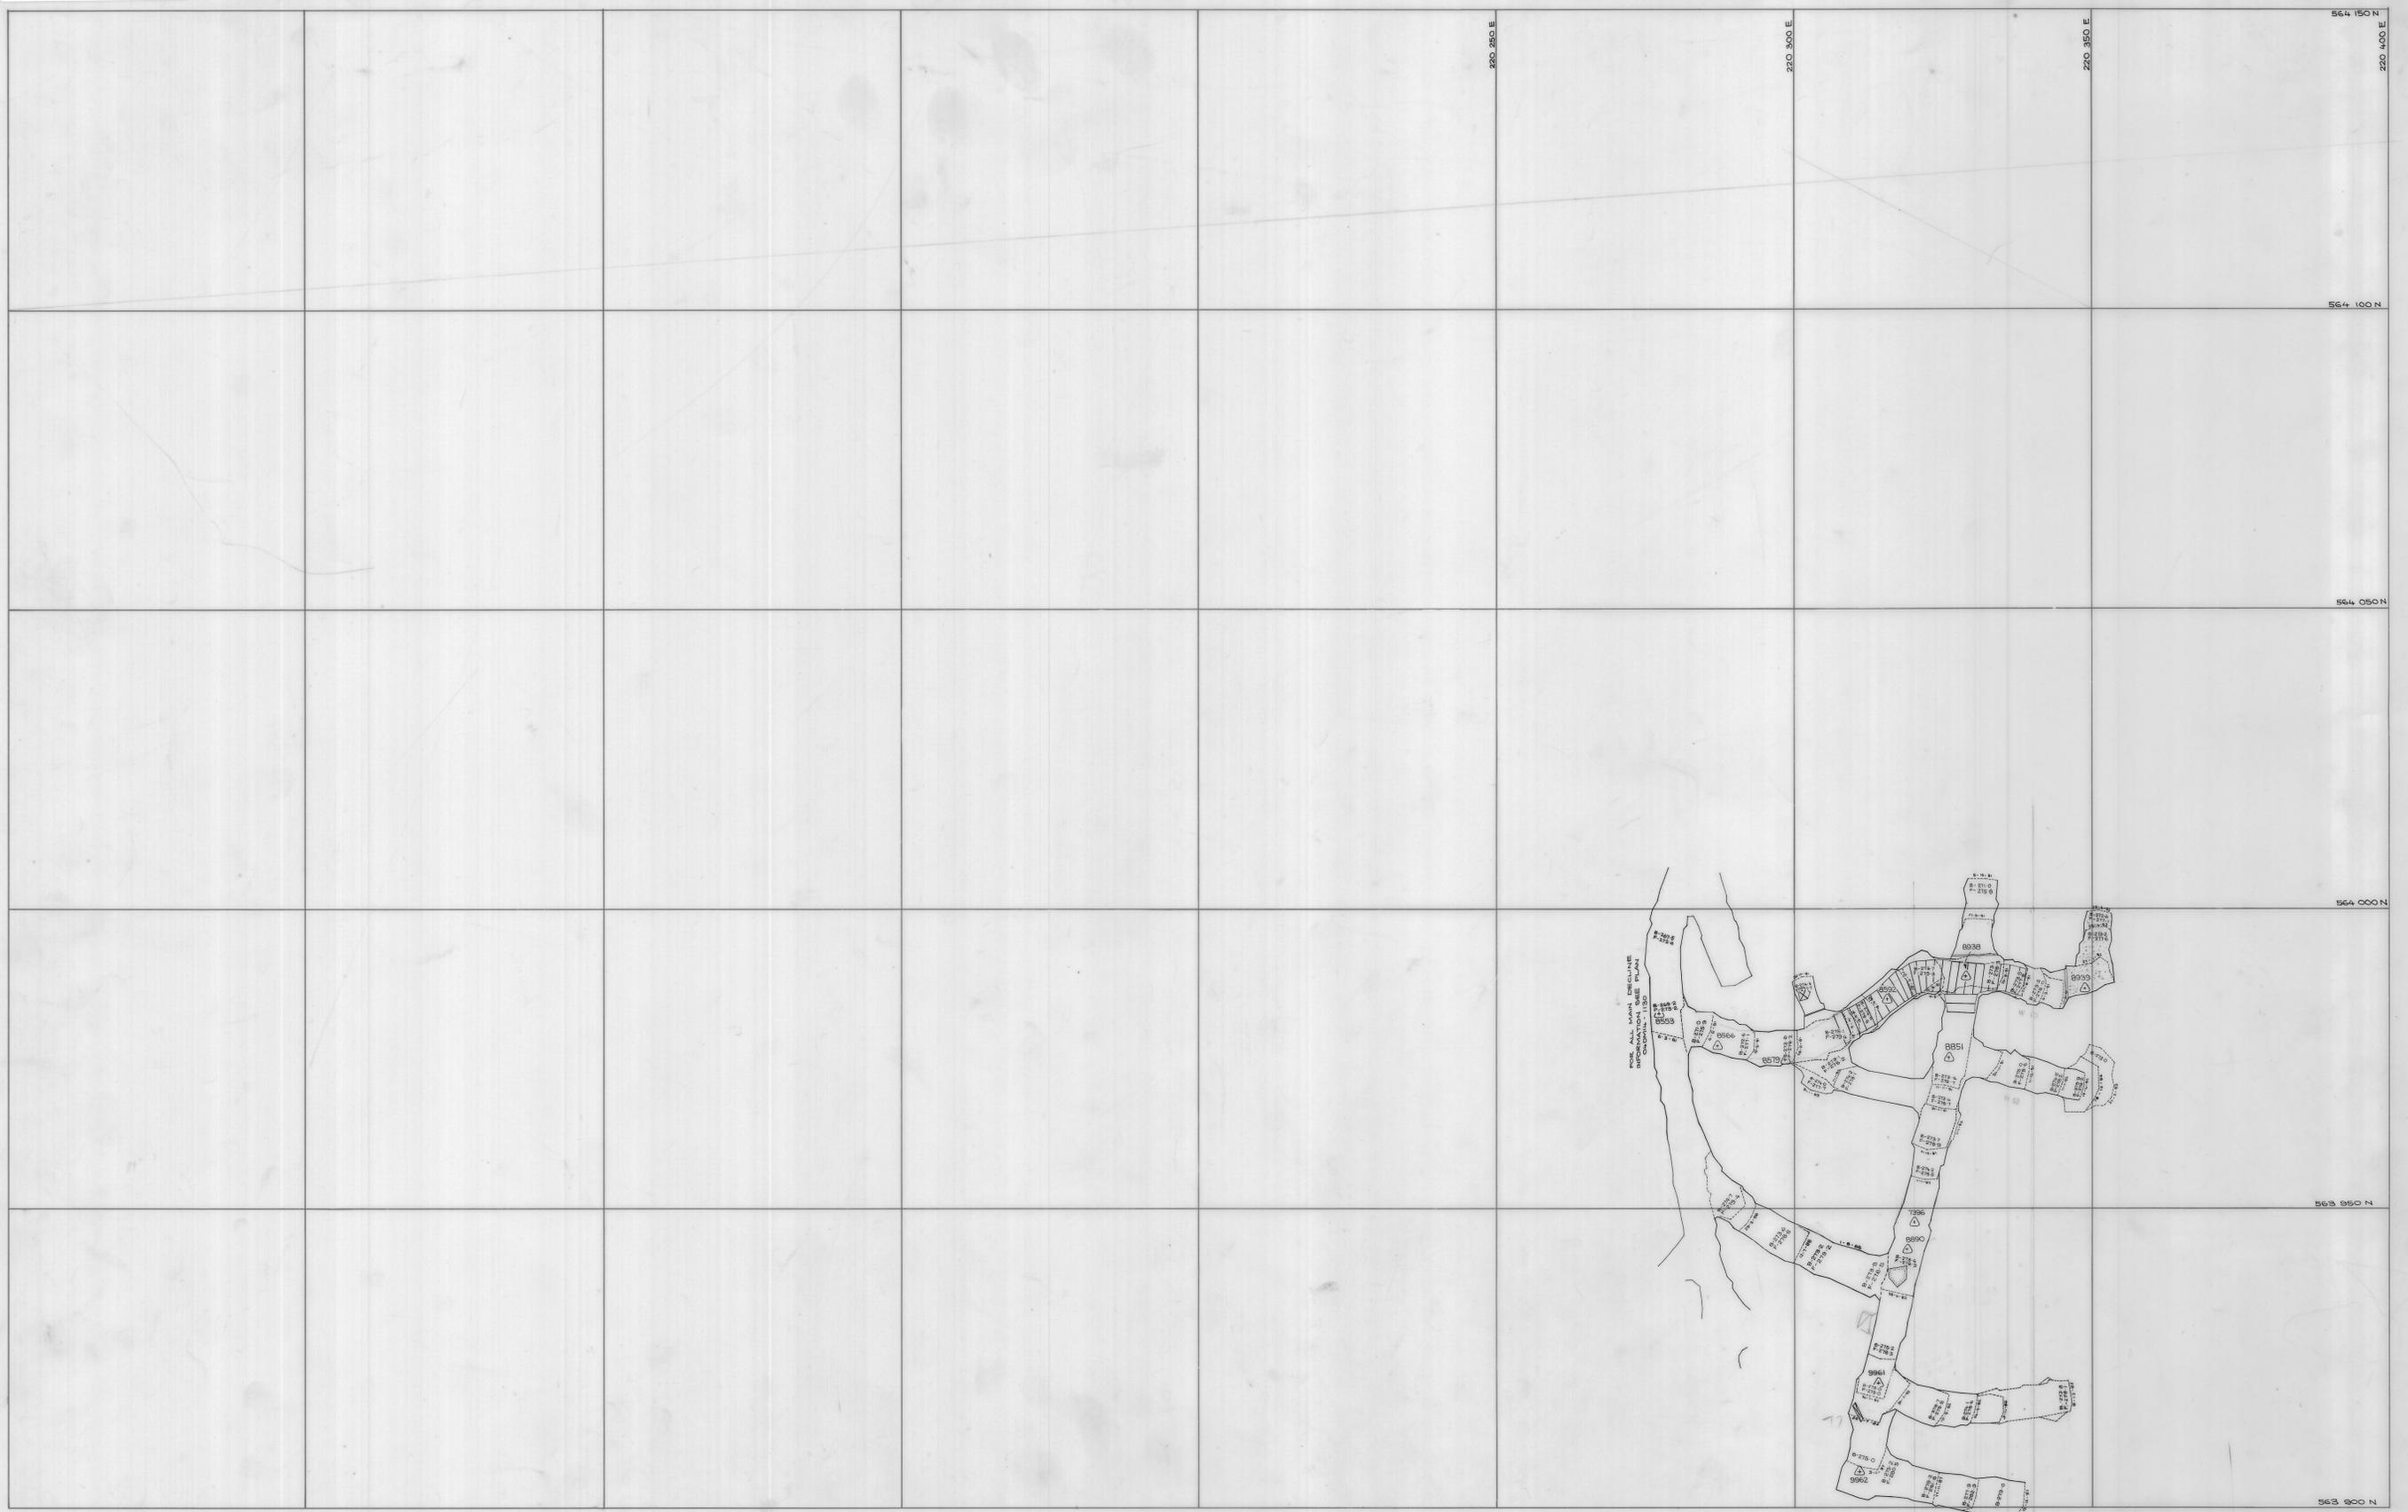

	<p>SCALE 1:500</p>		<p>LOCATION DOLPHIN MINE</p> <p>SUBJECT <b>LOWER WEDGE DEVELOPMENT -280 m LEVEL</b></p>	<p><b>KING ISLAND SCHEELITE</b> A DIVISION OF WARMAN INTERNATIONAL</p> <p>GRASSY KING ISLAND</p> <p>PLAN NUMBER <b>04DM14 - 1140</b></p>
--	--------------------	--	-----------------------------------------------------------------------------------------------------	--------------------------------------------------------------------------------------------------------------------------------------------------