


5 cm

04BHR-0006

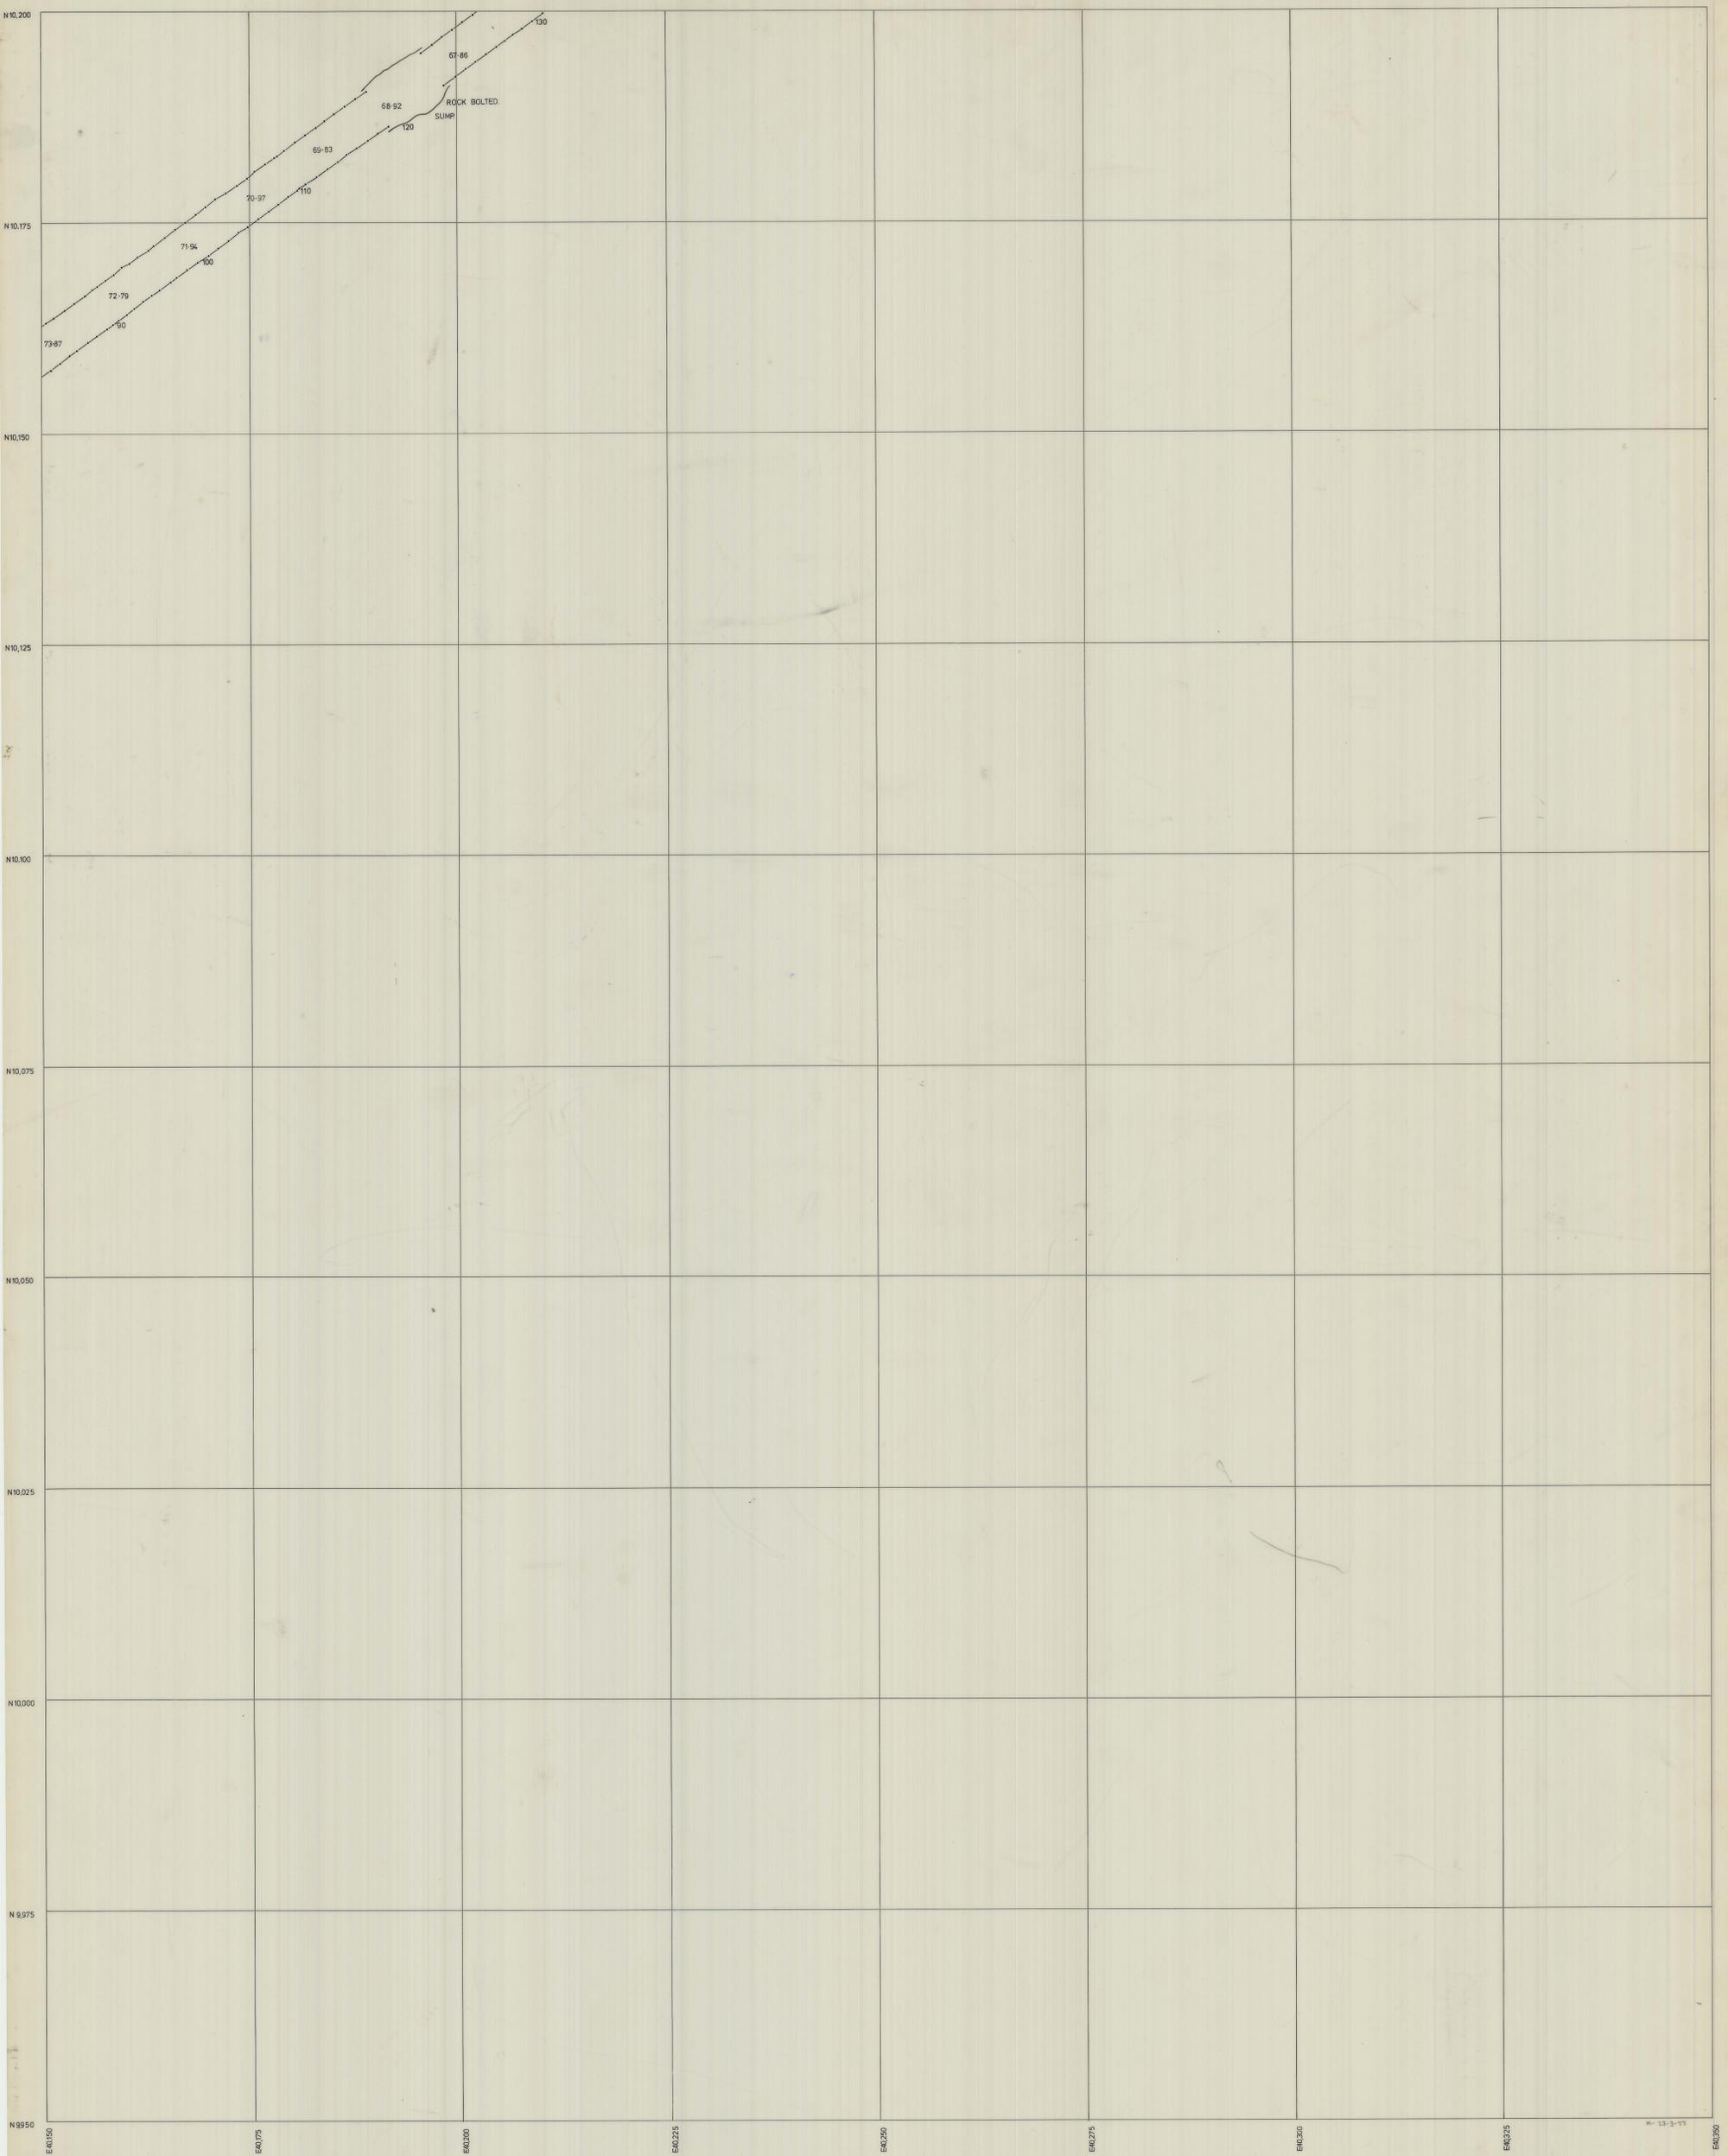

KING ISLAND SCHEELITE LTD.

BOLD HEAD MINE.

SCALE 1:250

