


0374-429

04DM14 - 1150

5 cm

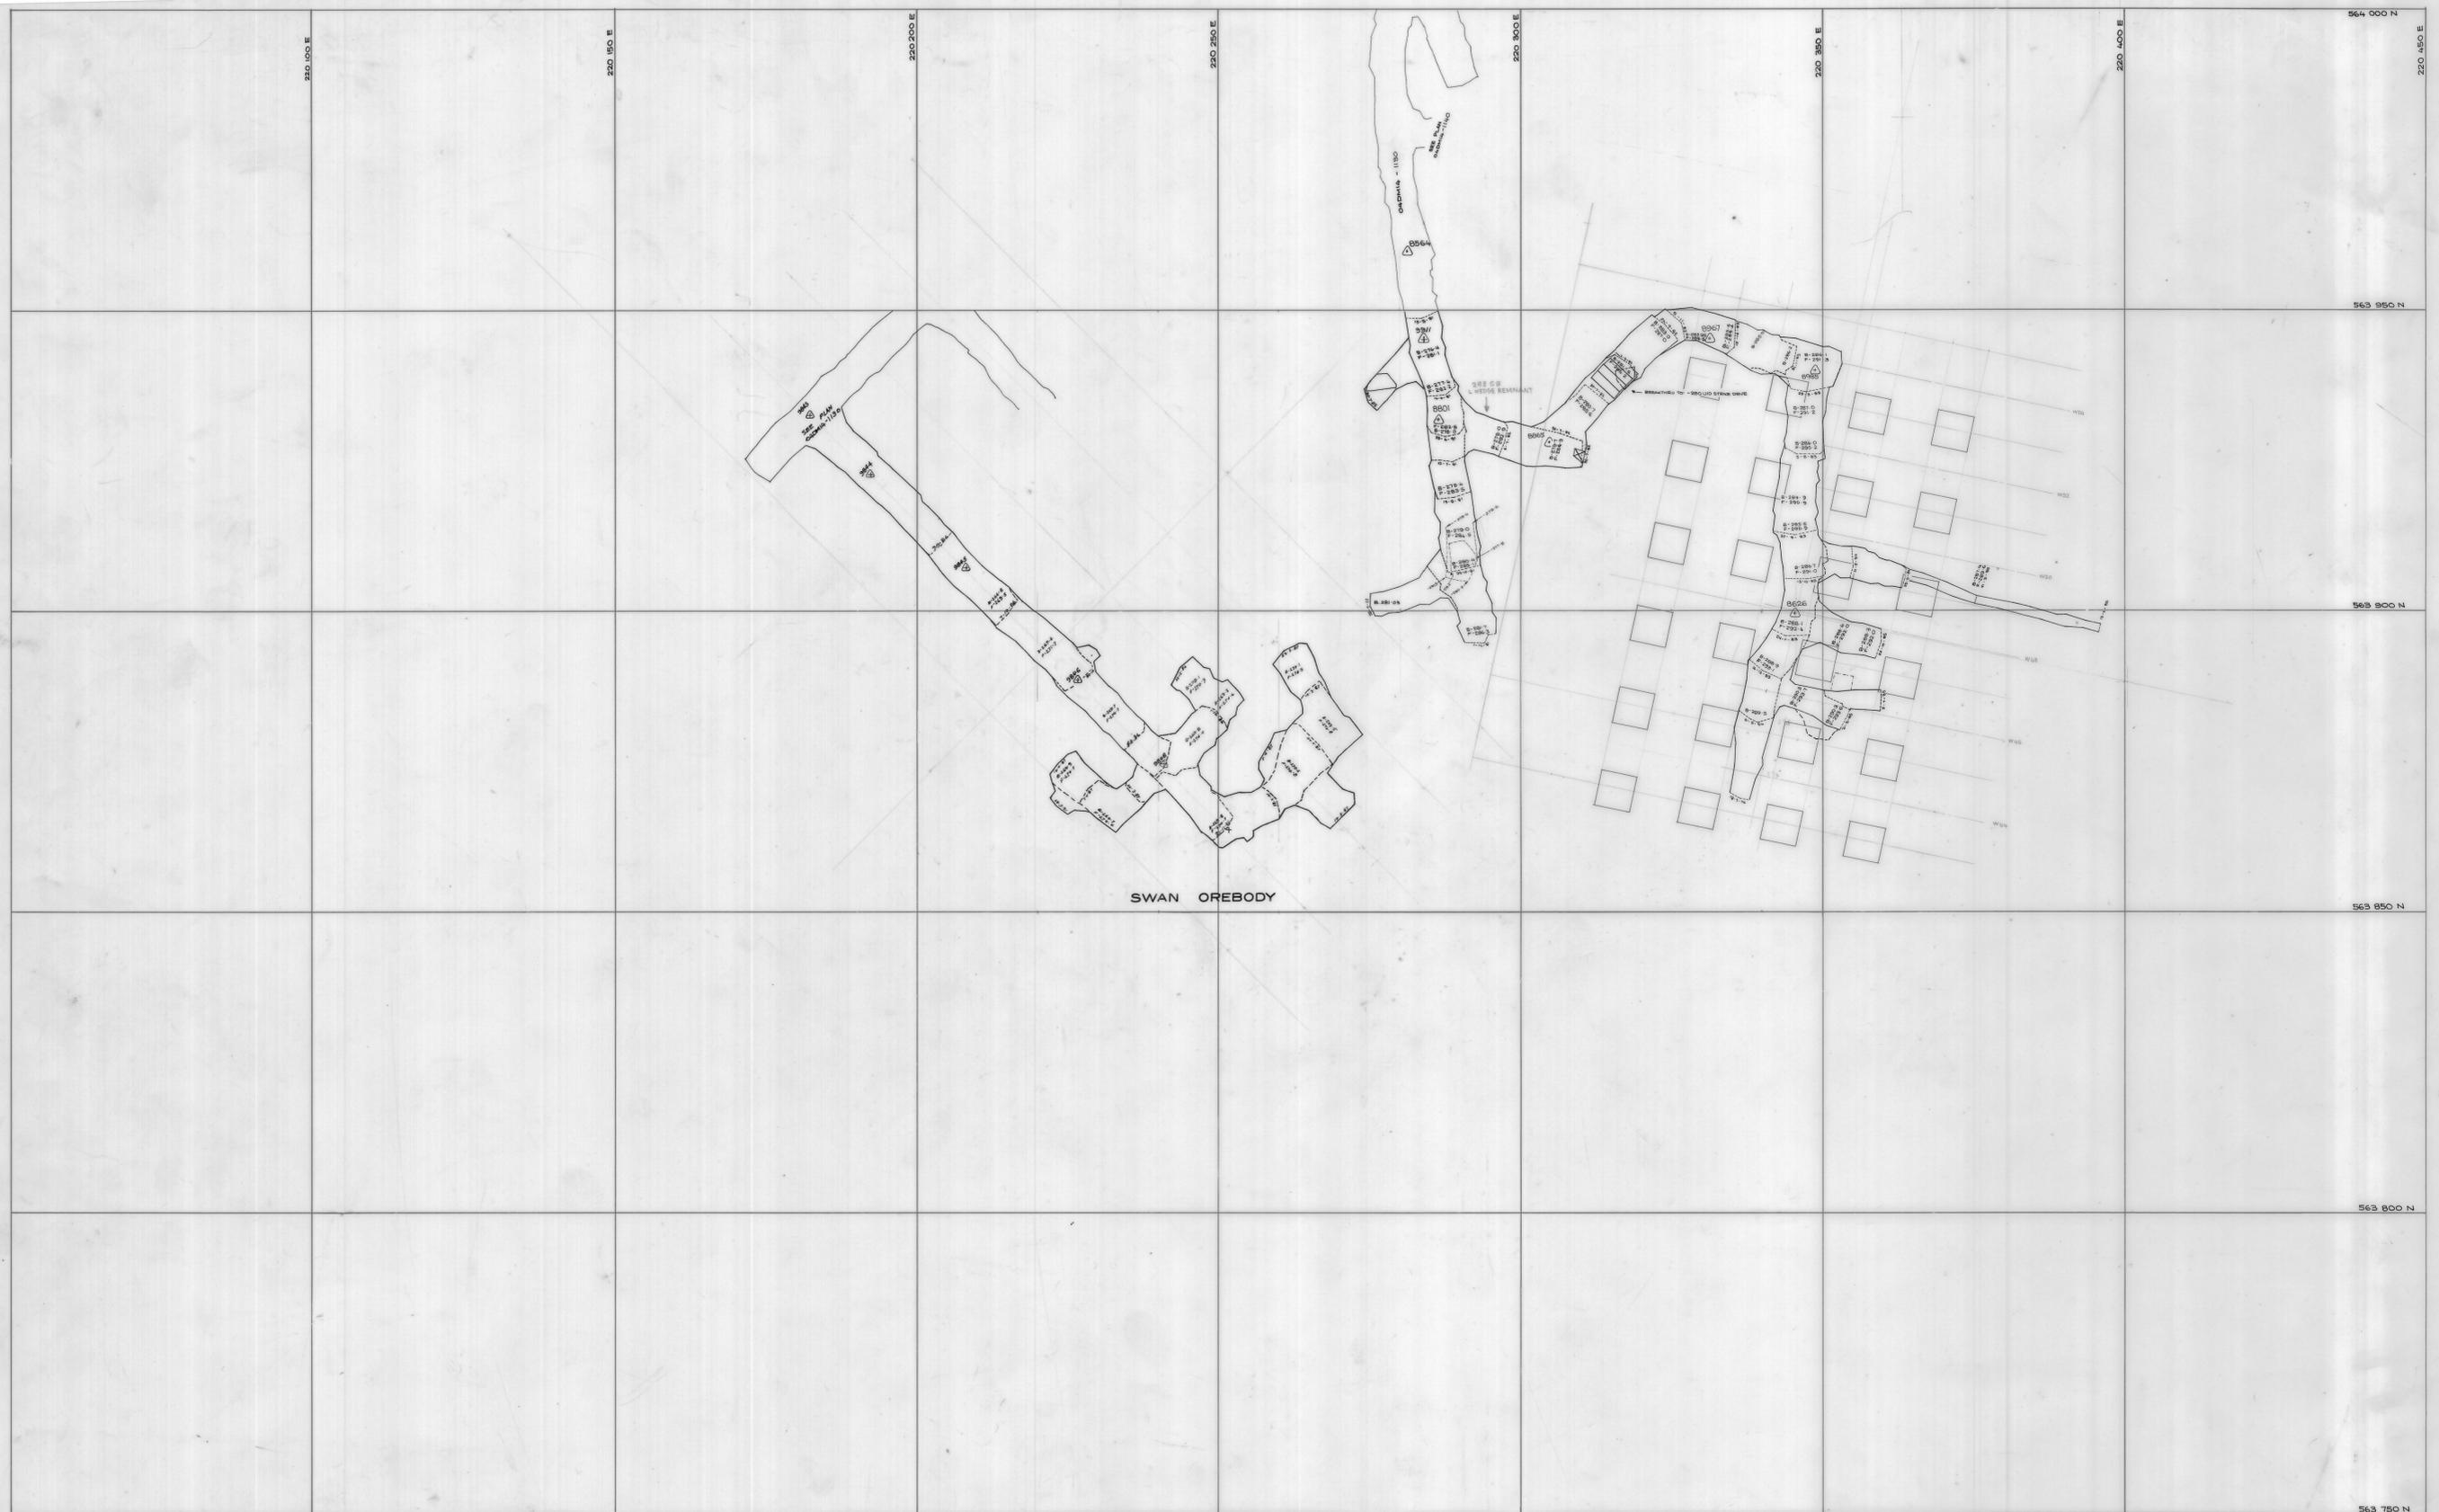

	SCALE 1: 500		LOCATION DOLPHIN MINE  SUBJECT - 280m ZONE	KING ISLAND SCHEELITE A DIVISION OF WARMAN INTERNATIONAL GRASSY KING ISLAND PLAN NUMBER 04DM14 - 1150
--	--------------	--	--	---

1150