


1:1000
Open Cut
Scale of Plan and Section
1-2-28

0374_4291

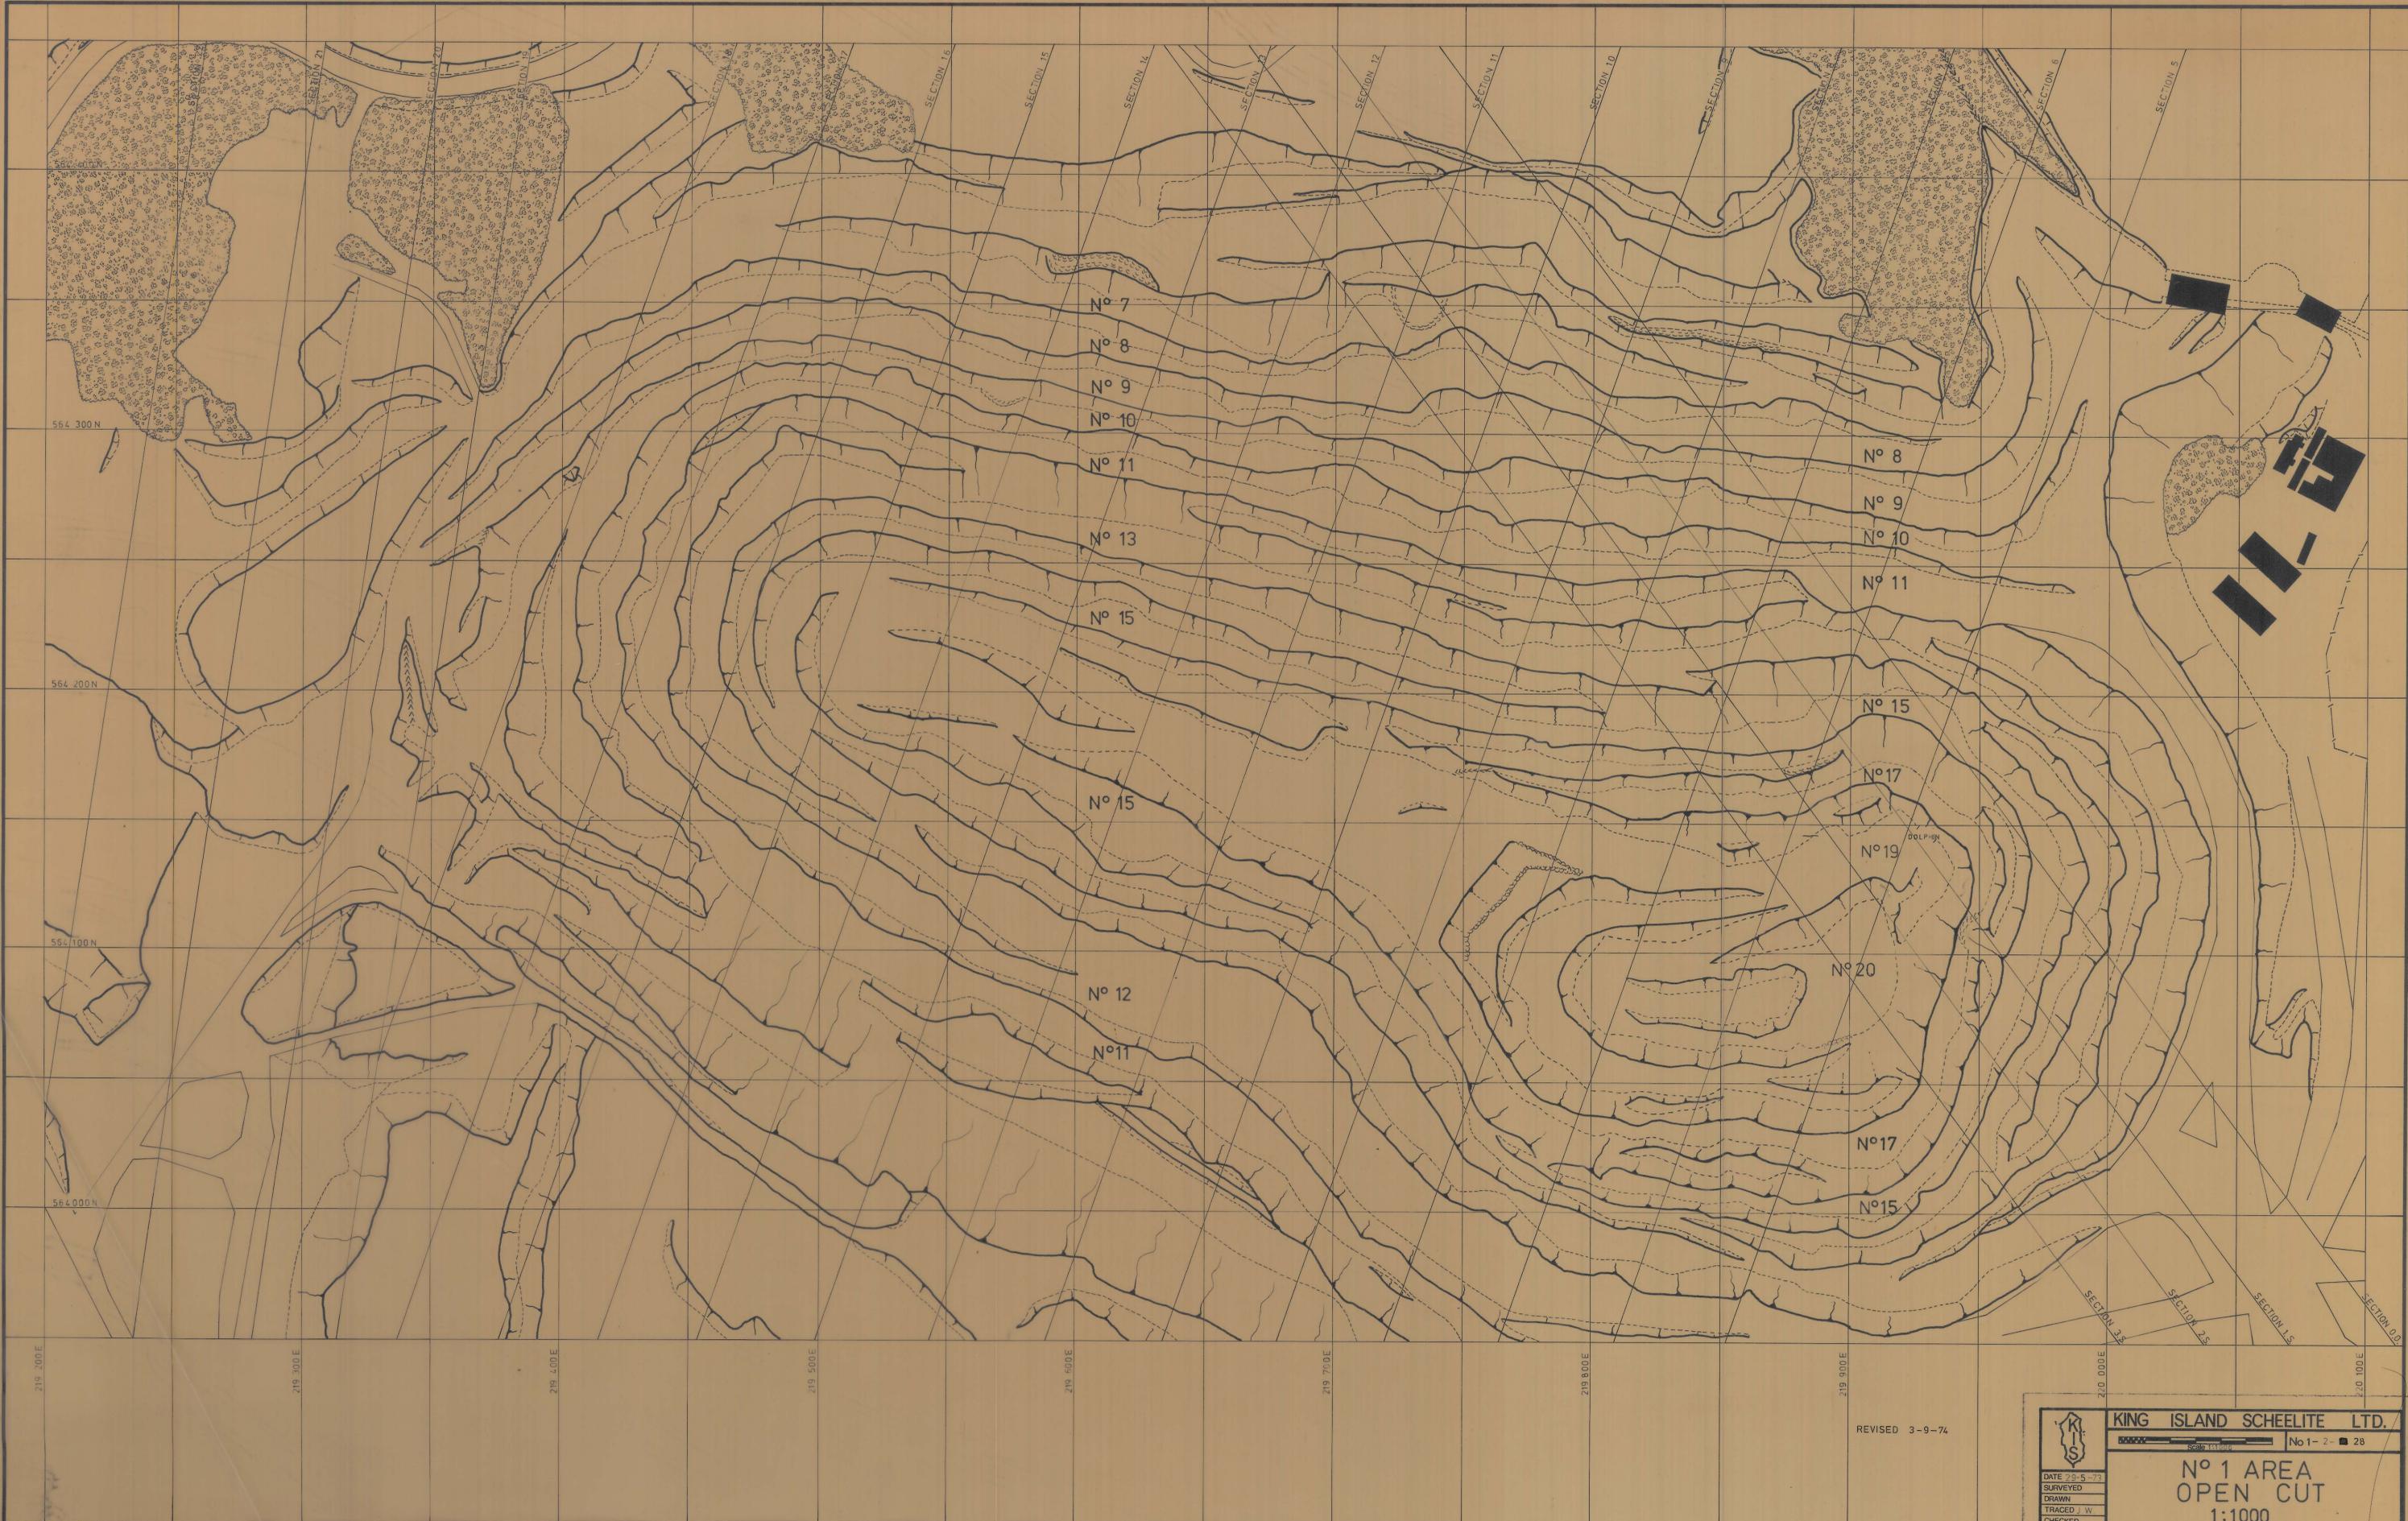

5 cm

REVISED 3-9-74

	KING ISLAND SCHEELITE LTD.	
	No 1-2-28	
	N° 1 AREA OPEN CUT	
	1:1000	