


1:1000  
Open Cut  
Kings Island Scheelite  
1-2-74

0374\_4292

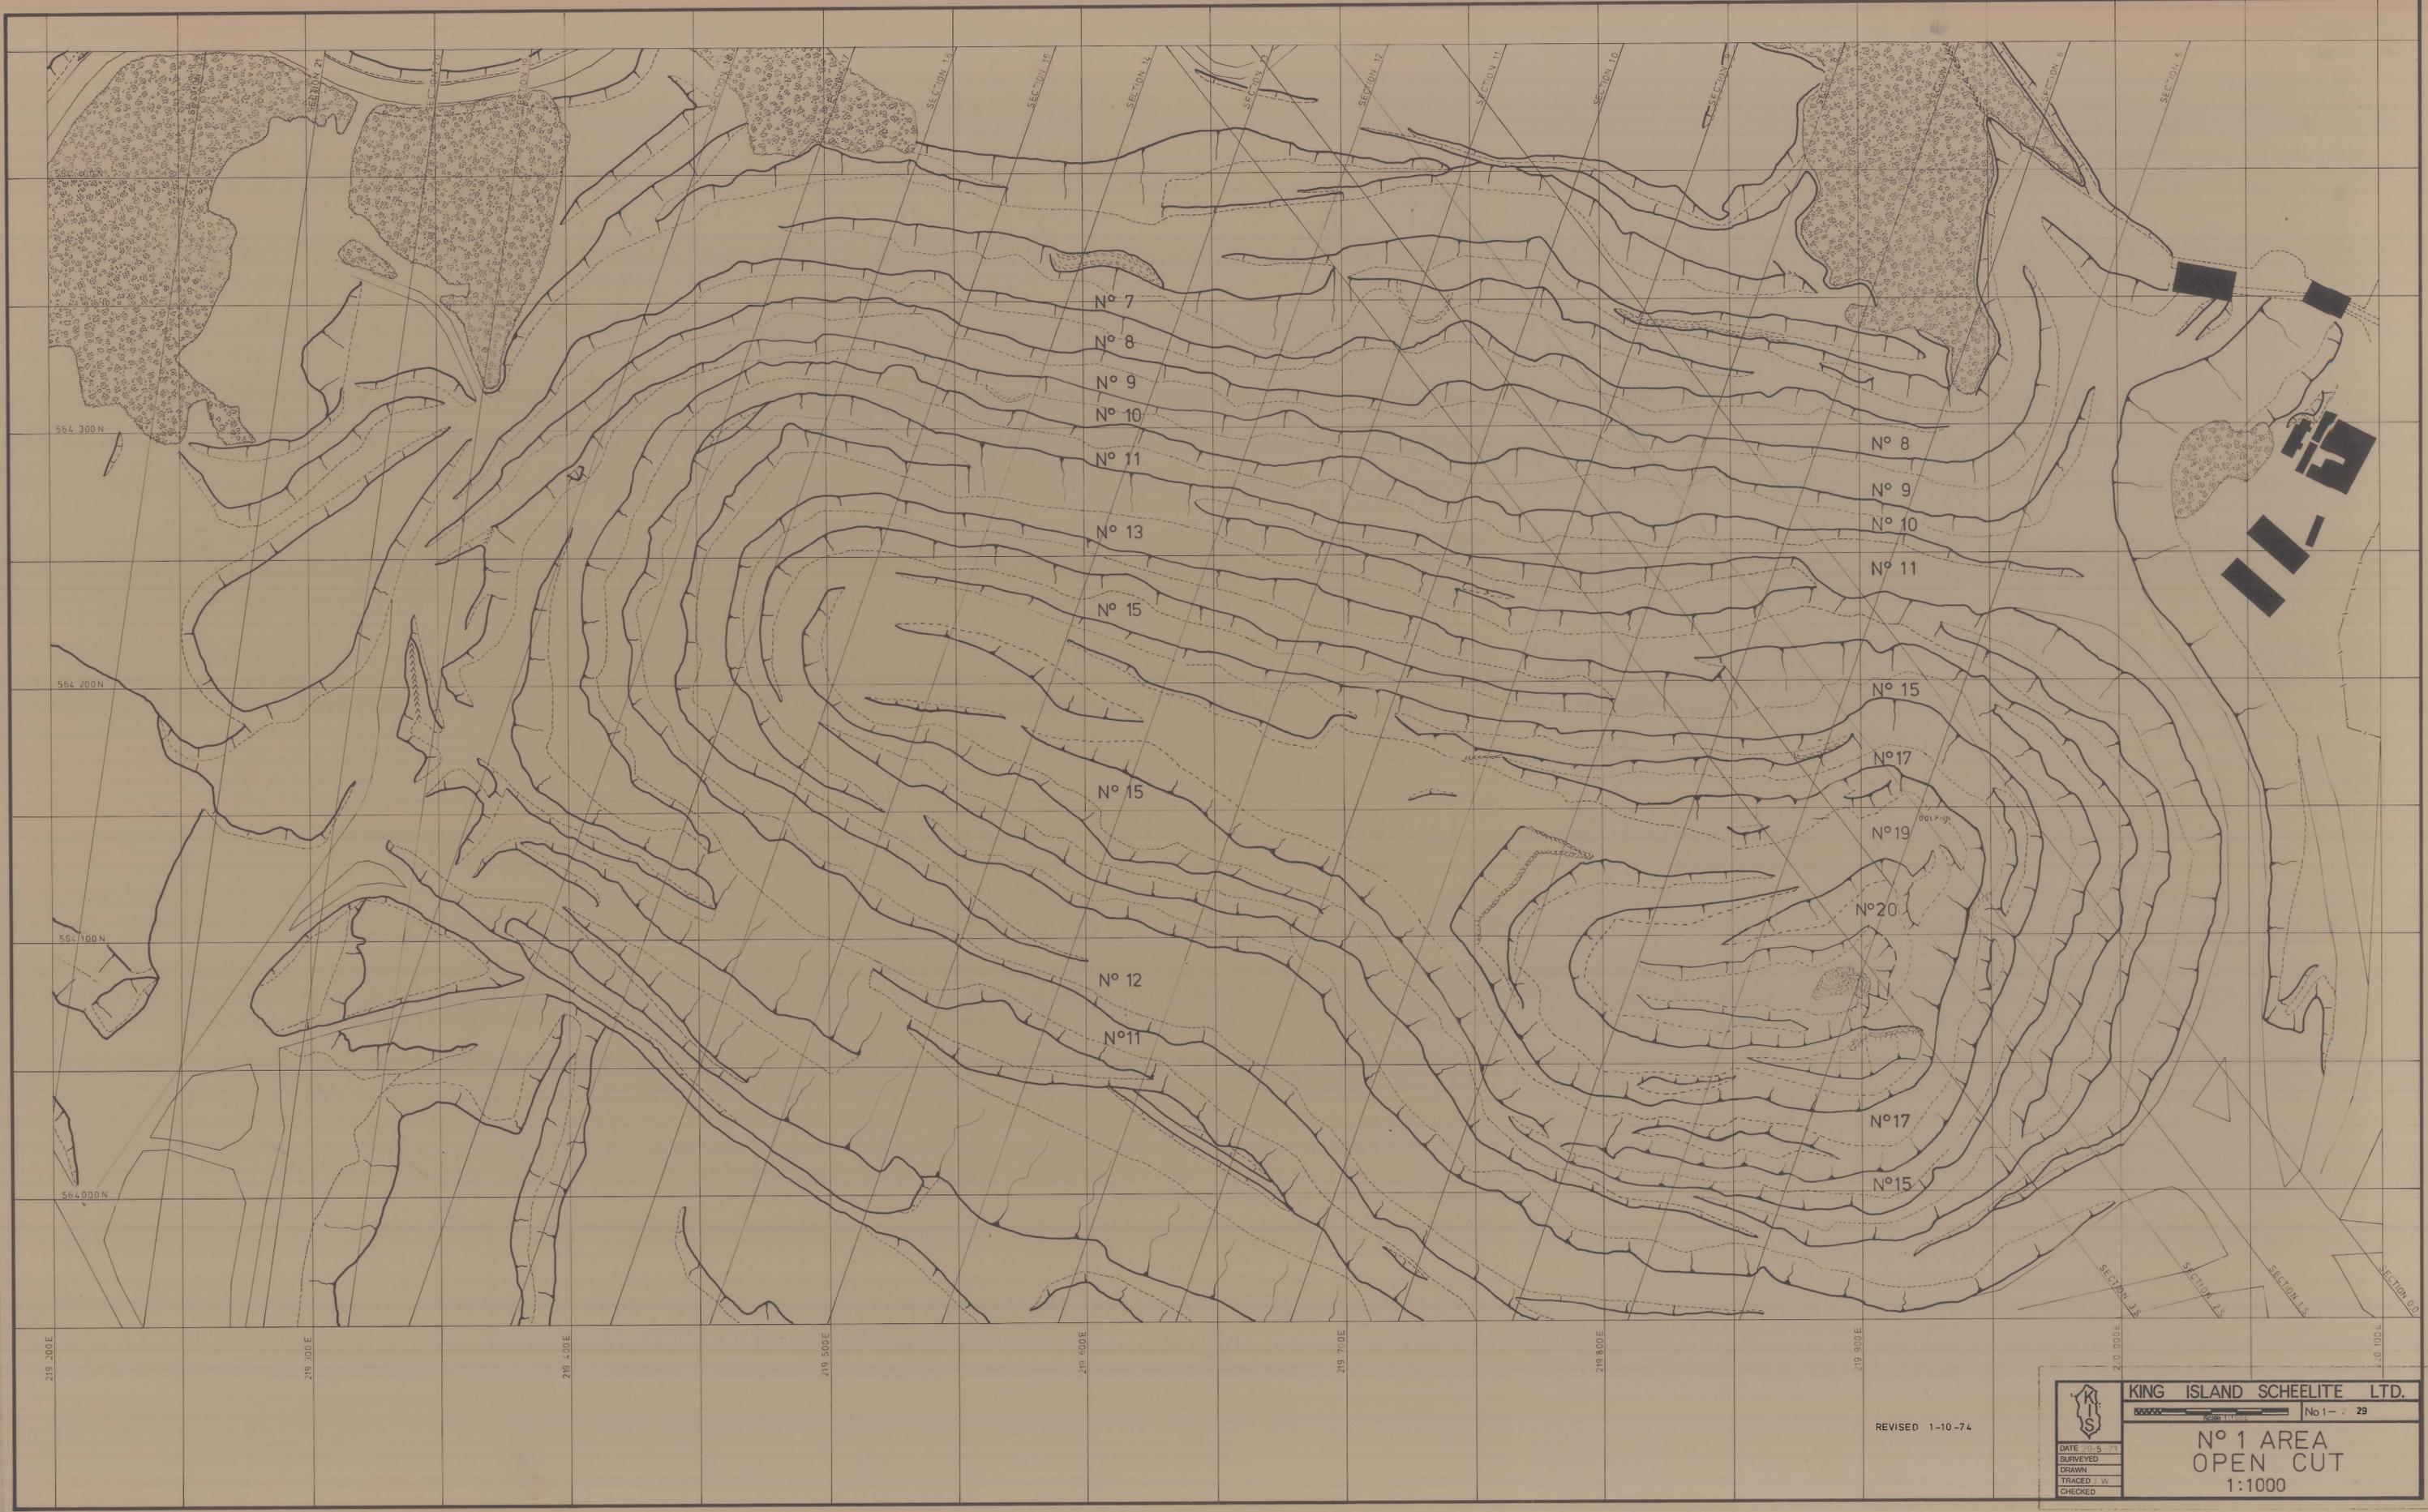

5 cm

REVISED 1-10-74

	KING ISLAND SCHEELITE LTD.	
	No 1 - 29	
<b>N° 1 AREA OPEN CUT</b>		
1:1000		
DATE 20-5-74	SURVEYED	
DRAWN	TRACED	W
CHECKED		