
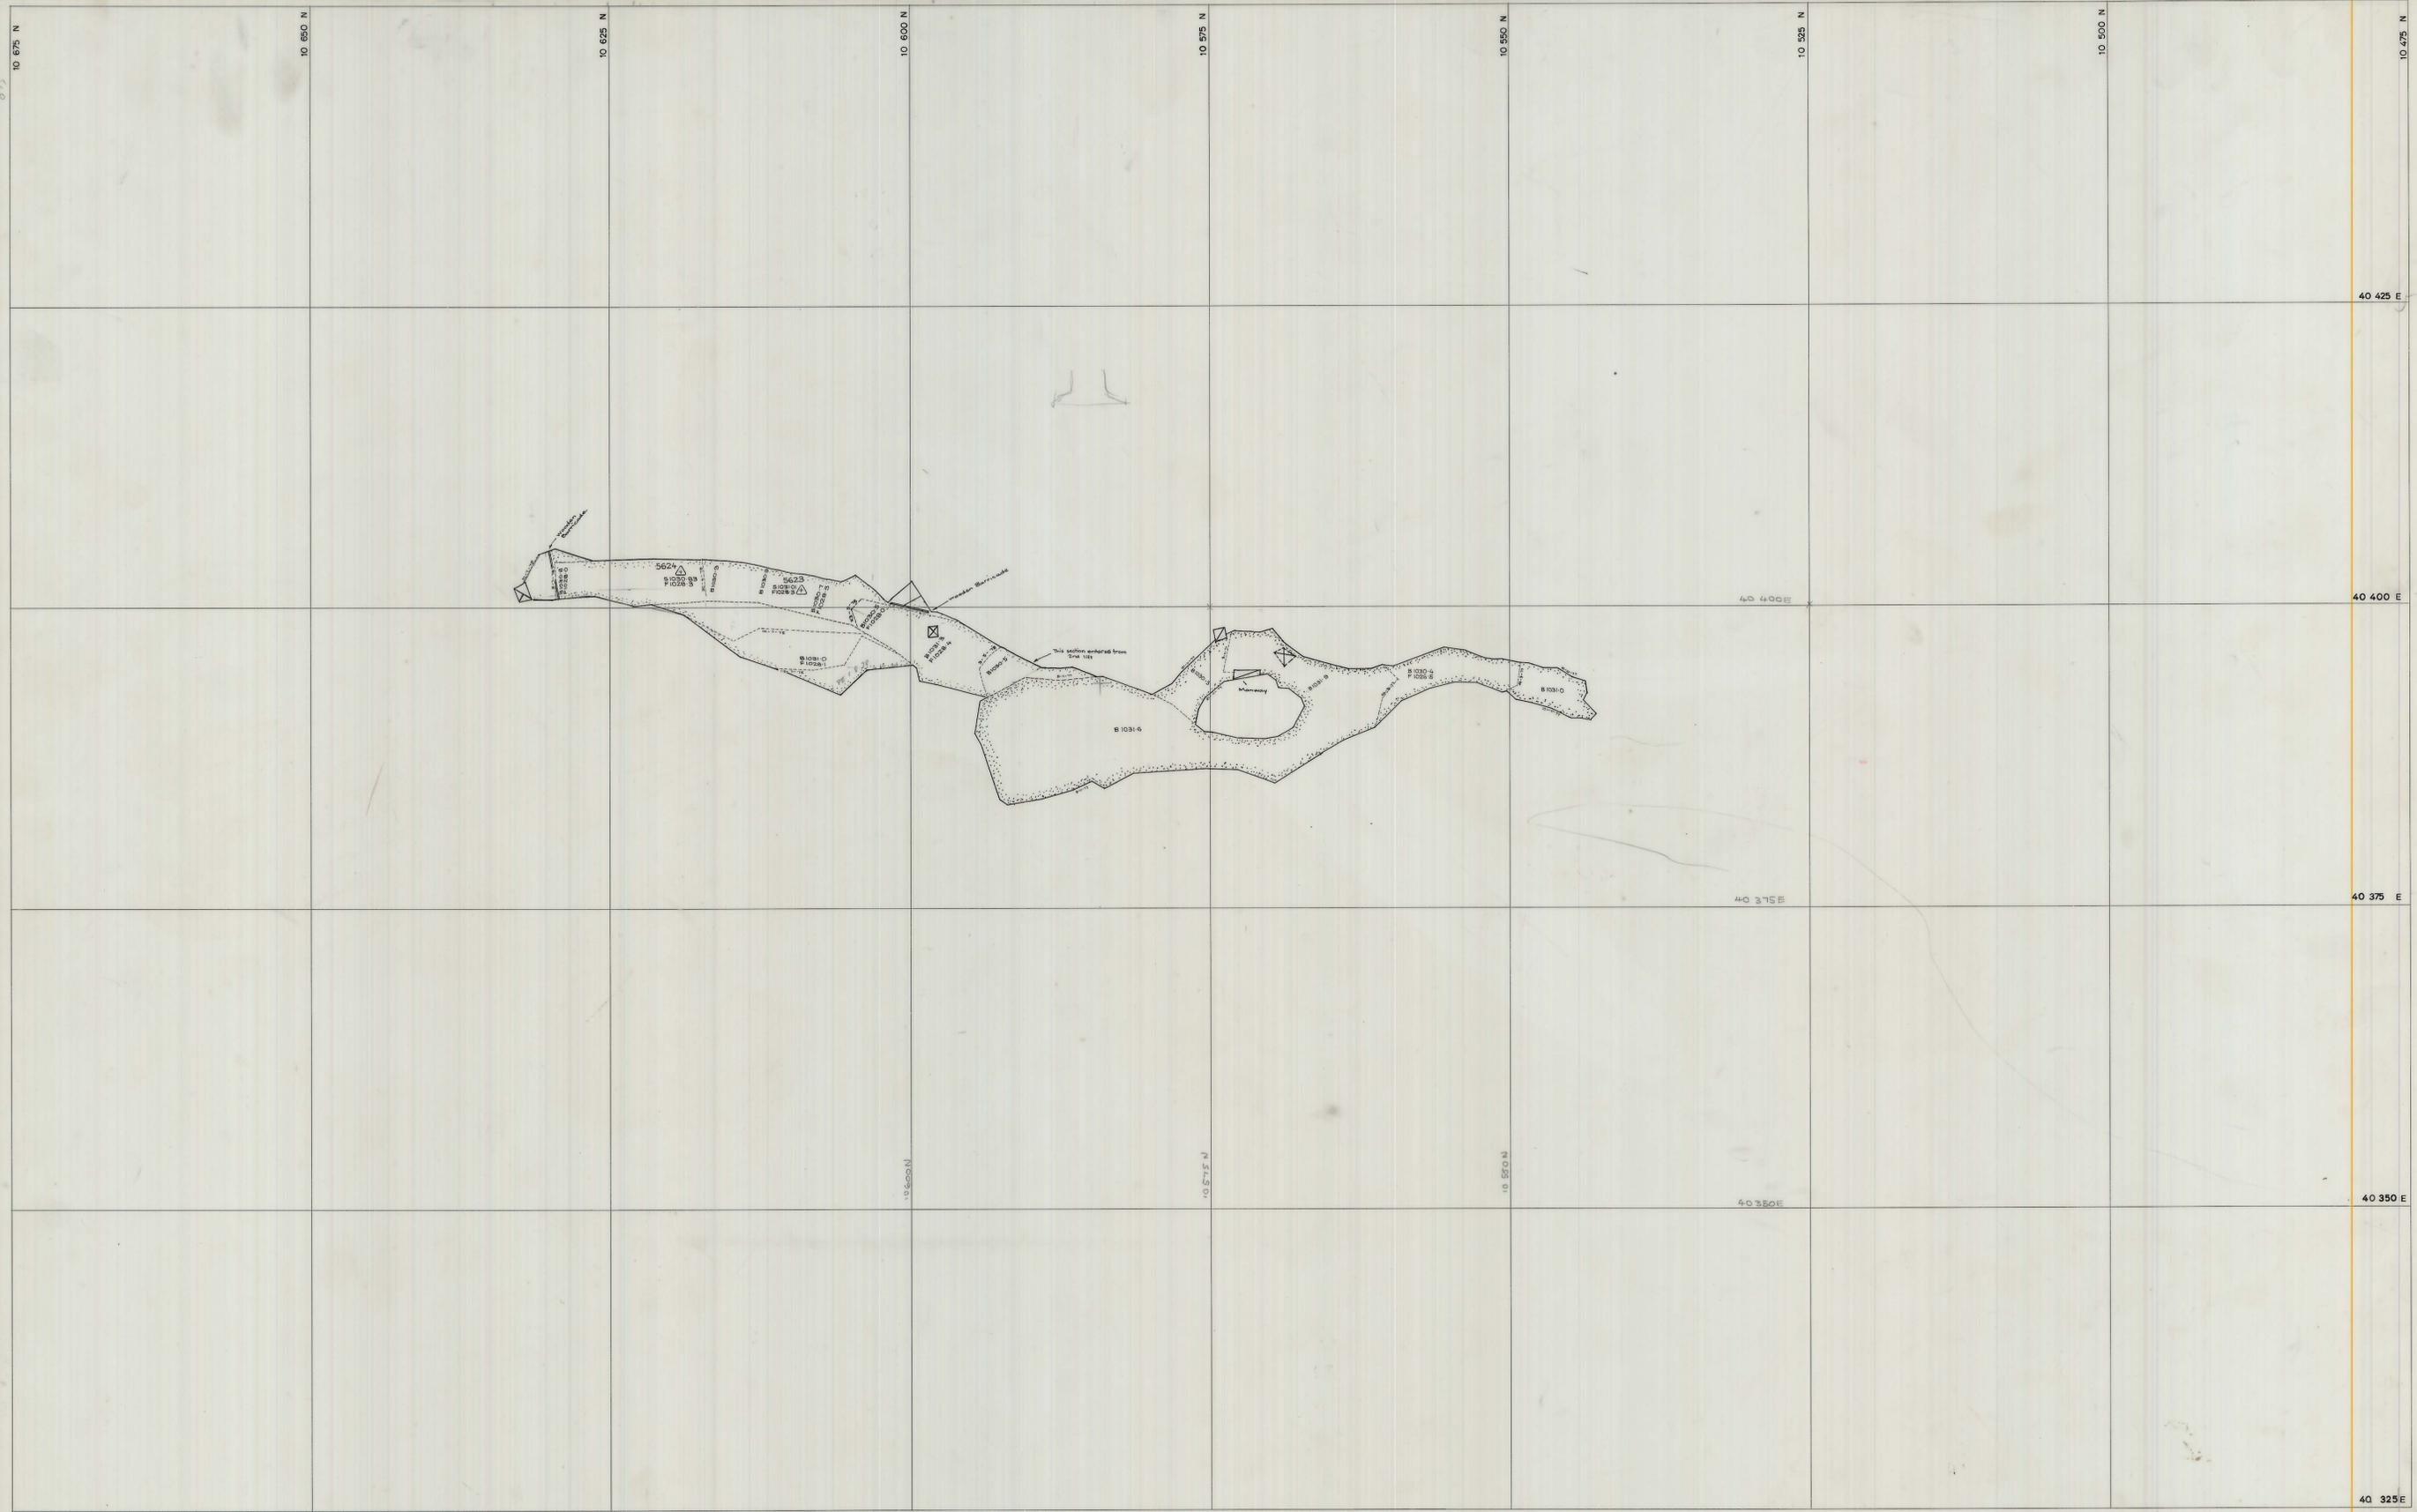


5 cm

04BH13-1030
0374_4294
P. 57
1st LIFT

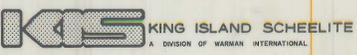

SCALE 1 : 250	north	LOCATION BOLD HEAD	 KING ISLAND SCHEELITE A DIVISION OF WARMAN INTERNATIONAL
		SUBJECT P. 57 STOPE [1st LIFT]	