


5 cm

04BH12 - 156 186S

V45

0374_4298

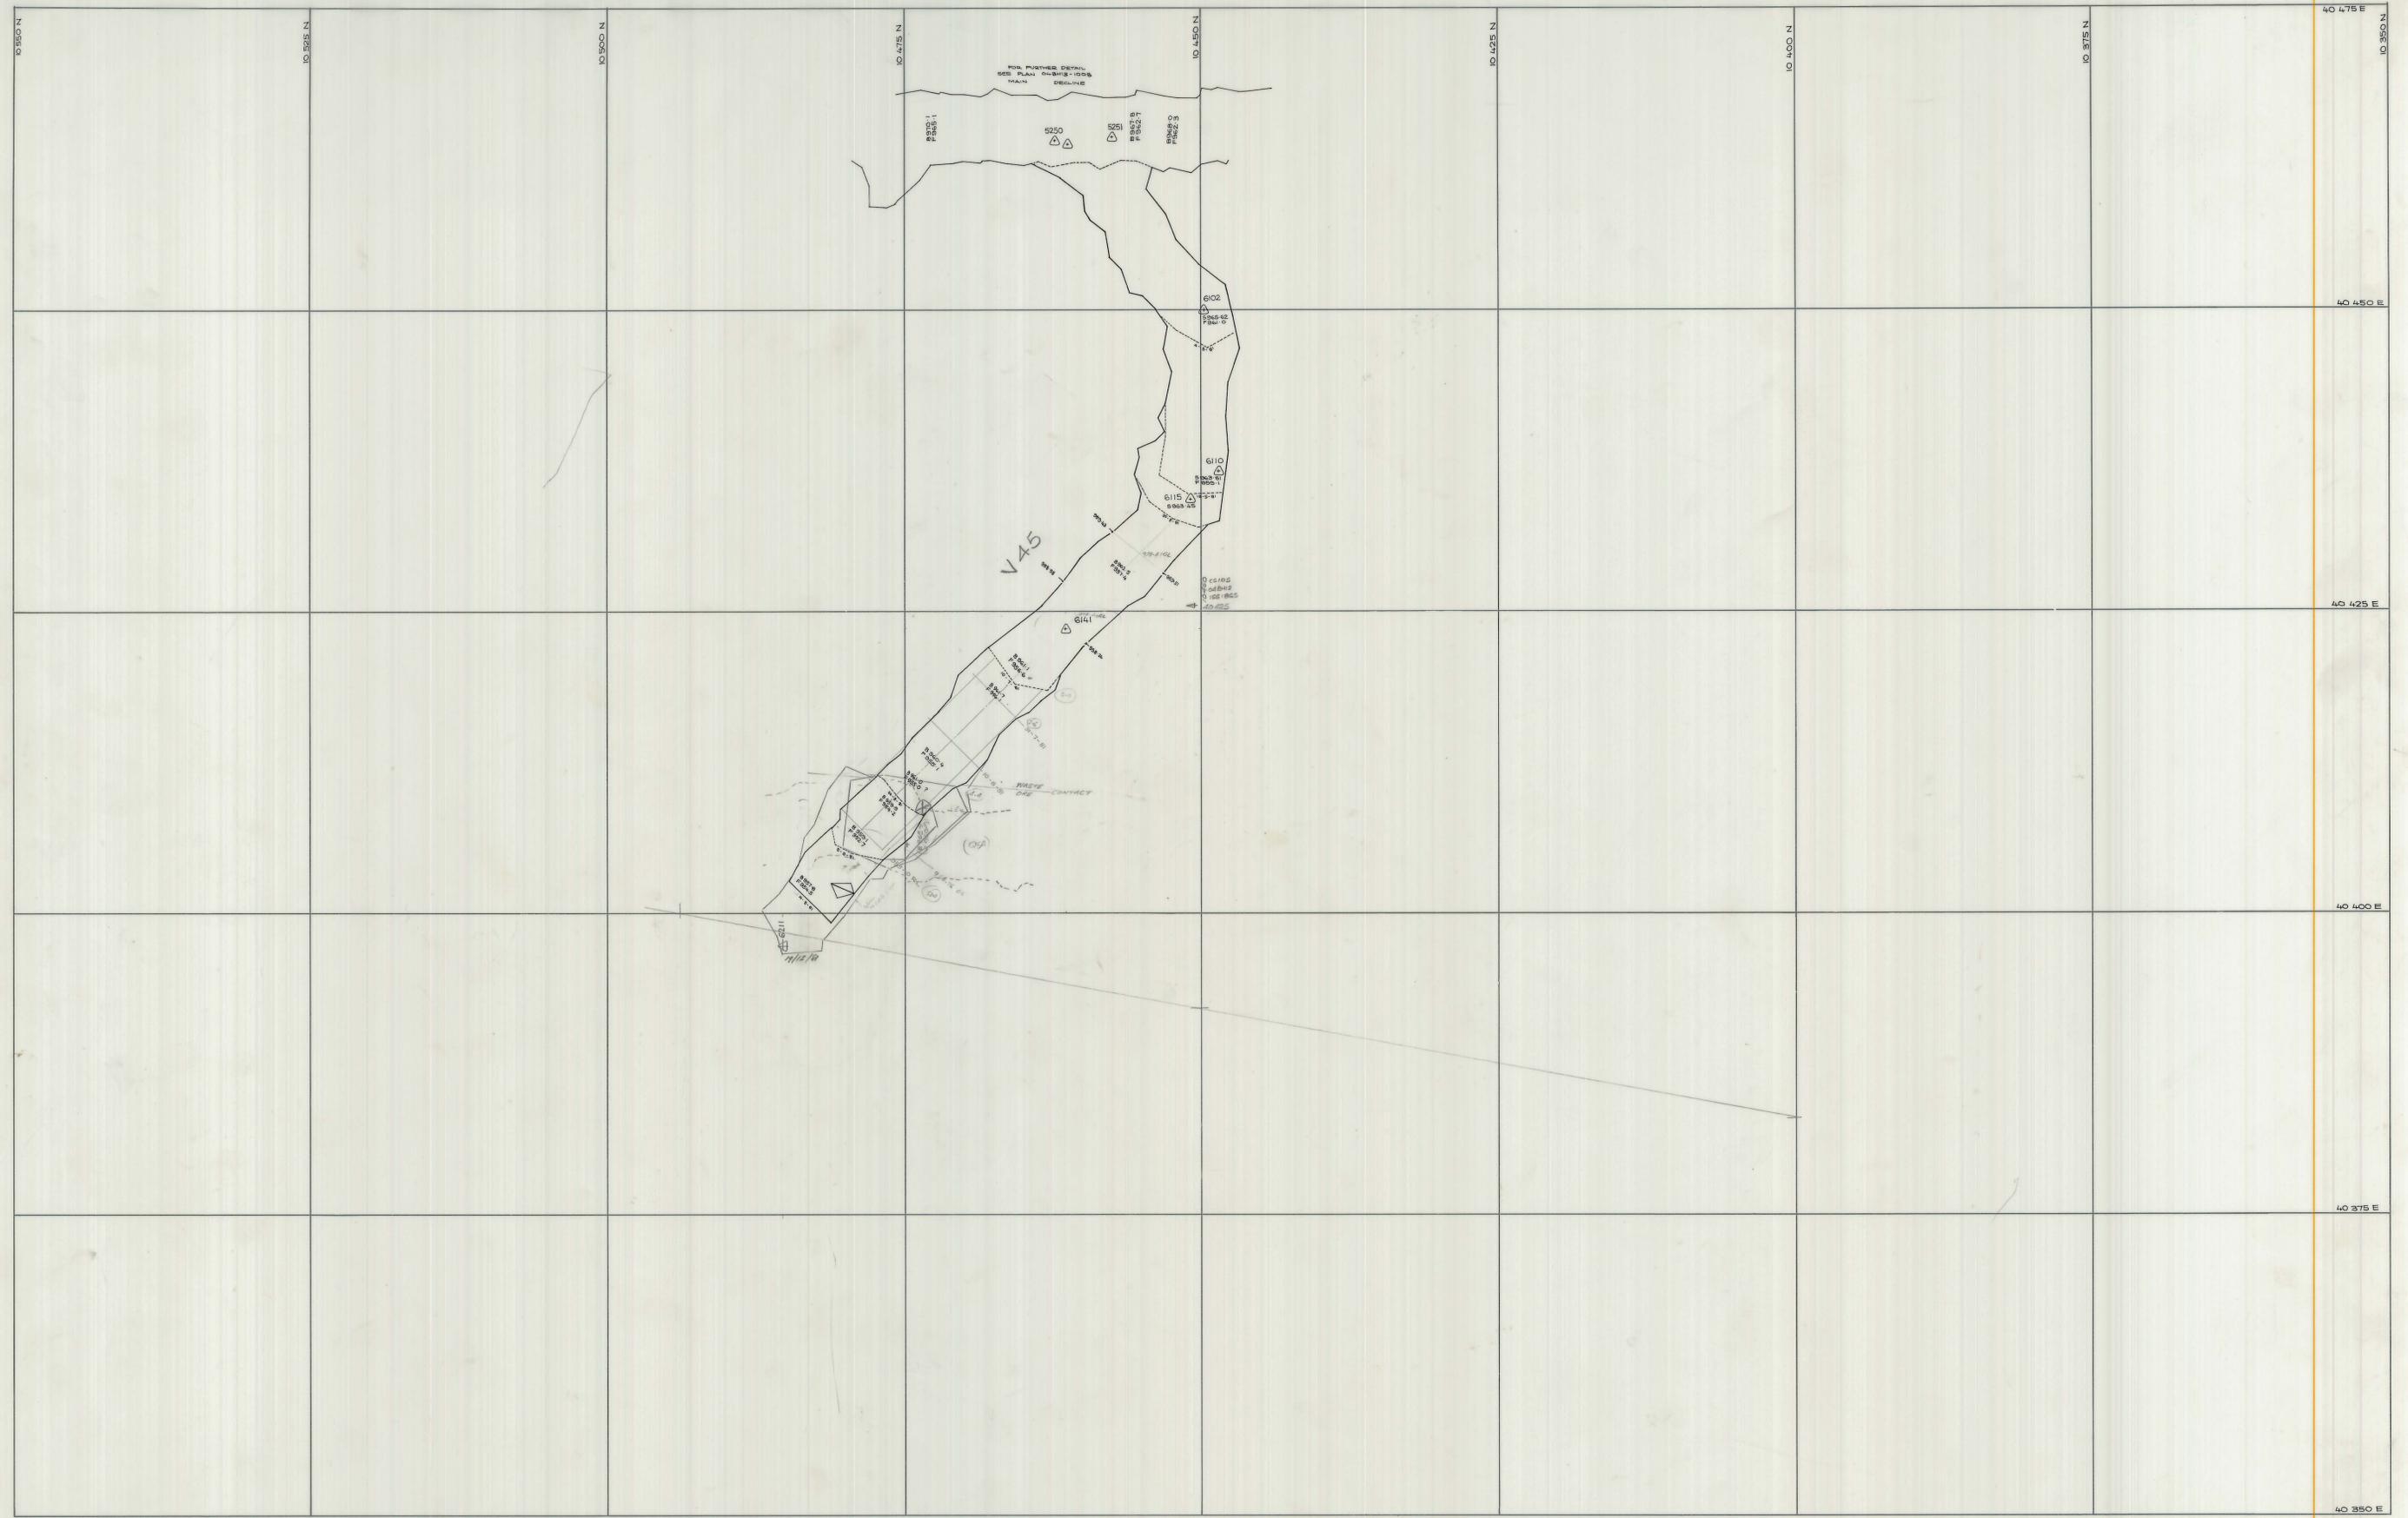

<p>SCALE 1:250</p> <p>Scale Set 105</p>	<p>LOCATION</p> <p>BOLD HEAD MINE</p>	<p>SUBJECT</p> <p>V 45</p> <p>ACCESS TO B.F.2 OREBODY</p>	<p>KIS KING ISLAND SCHEELITE A DIVISION OF WARMAN INTERNATIONAL</p> <p>GRASSY KING ISLAND</p> <p>PLAN NUMBER 04BH12 - 156 186 S</p>
---	---------------------------------------	---	--