



04BH12-156 252

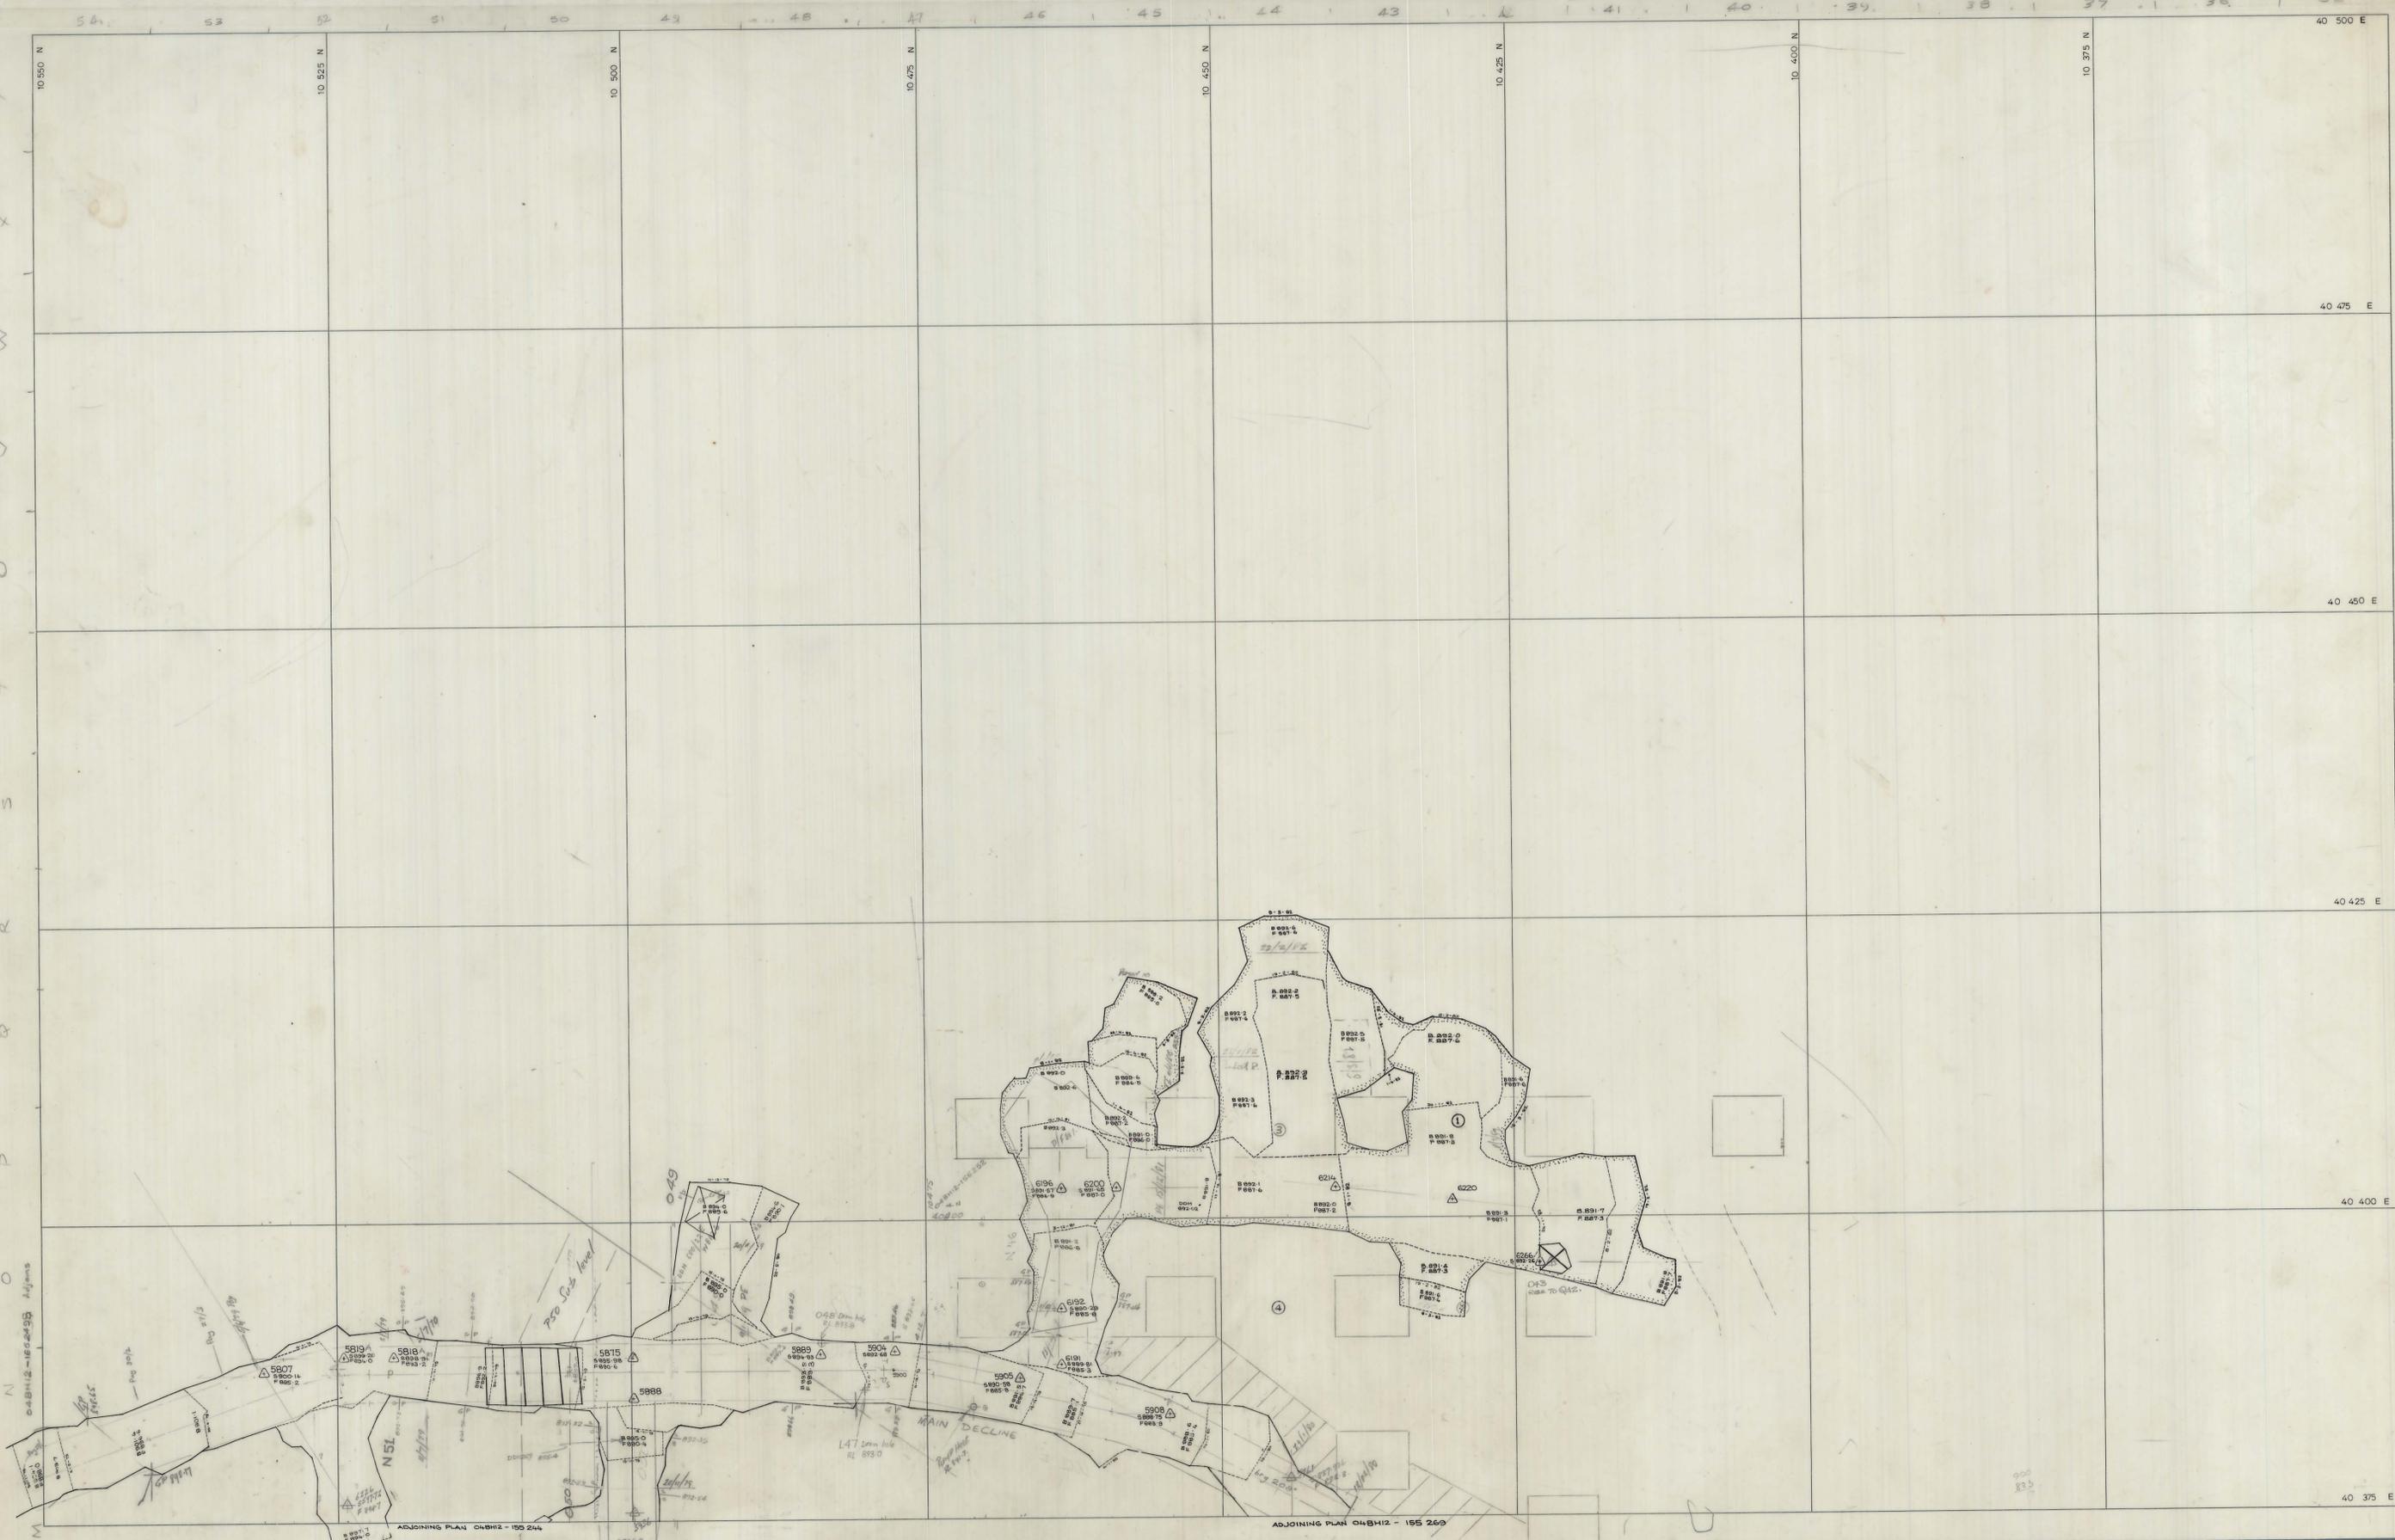

SCALE 1:250  
 Drawn: Cole Sheet # 66 & 7B  
 050: Cole Sheet # 86

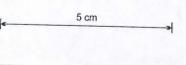

LOCATION BOLD HEAD MINE  
 SUBJECT MAIN DECLINE

**KS** KING ISLAND SCHEELITE  
 A DIVISION OF WARMAN INTERNATIONAL  
 GRASSY KING ISLAND  
 PLAN NUMBER 04BH12-156 252 S