




P57
LIFT 5

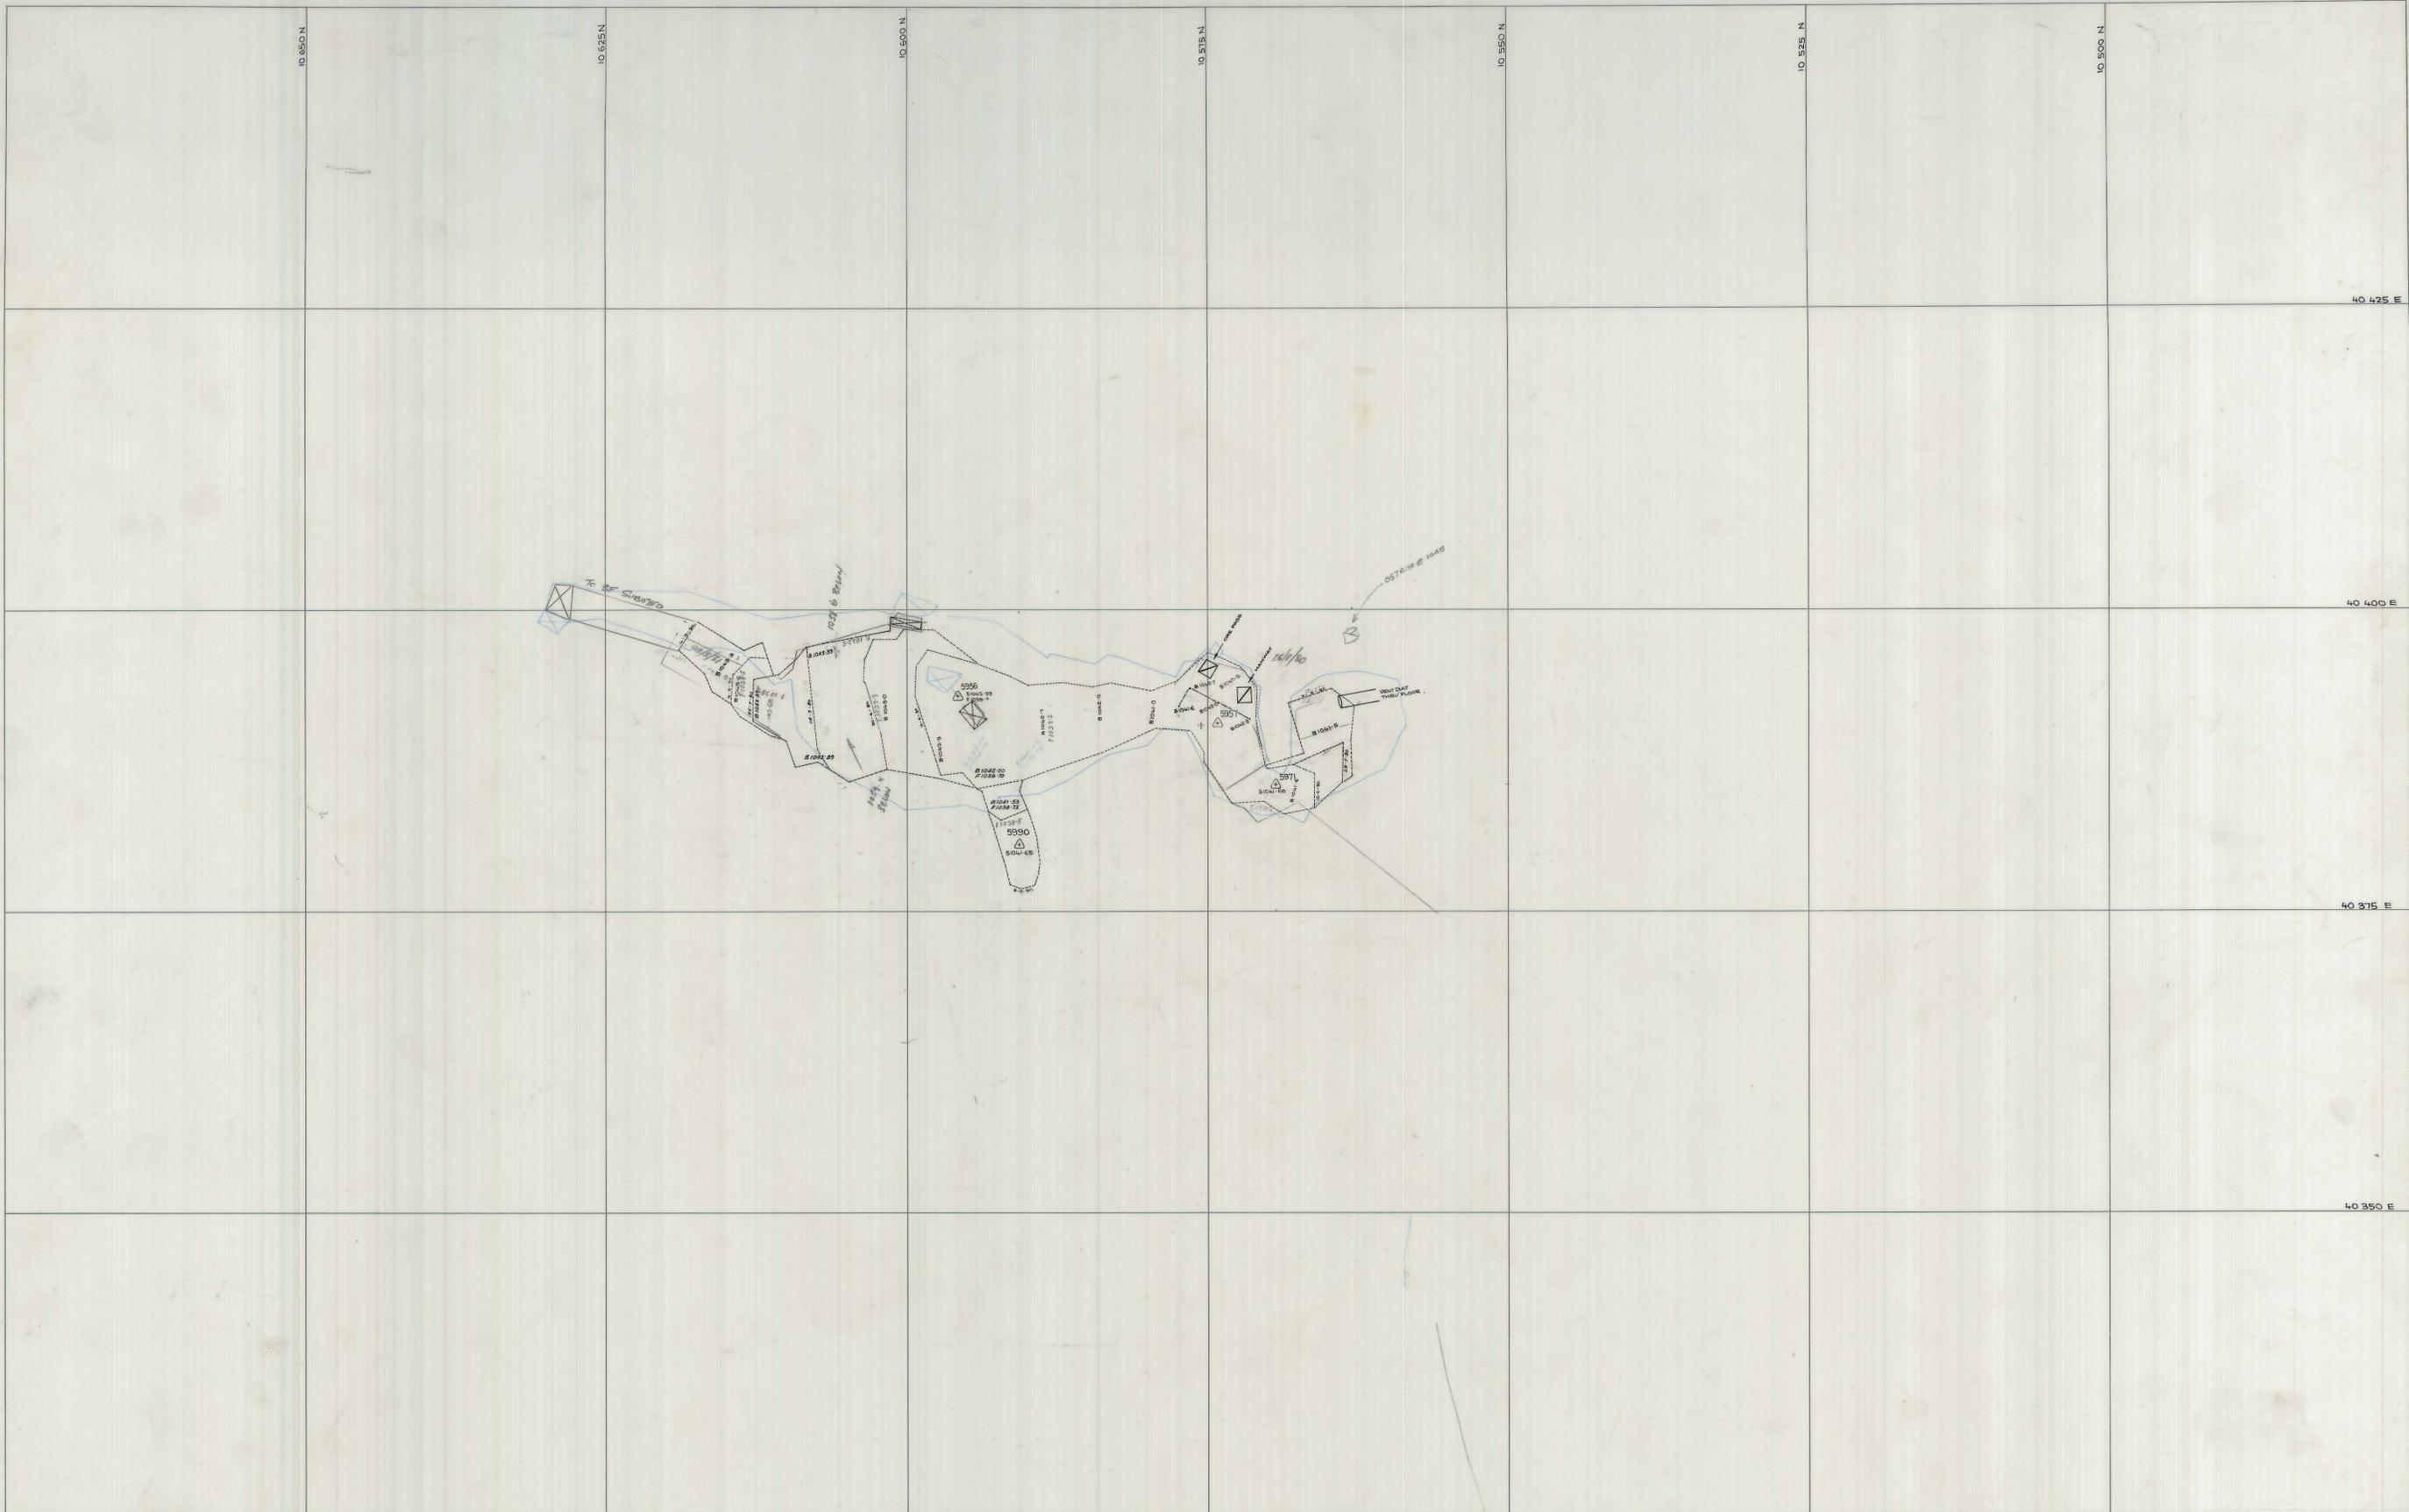

SCALE 1:250

north

LOCATION	BOLD HEAD MINE
SUBJECT	P 57 5th lift

KIS KING ISLAND SCHEELITE
A DIVISION OF NARMAN INTERNATIONAL

GRASSY KING ISLAND

PLAN NUMBER 04BH13 - 1026