


5 cm

04BH13 - 155 258 S

M37
LIFT 3

0374_4323

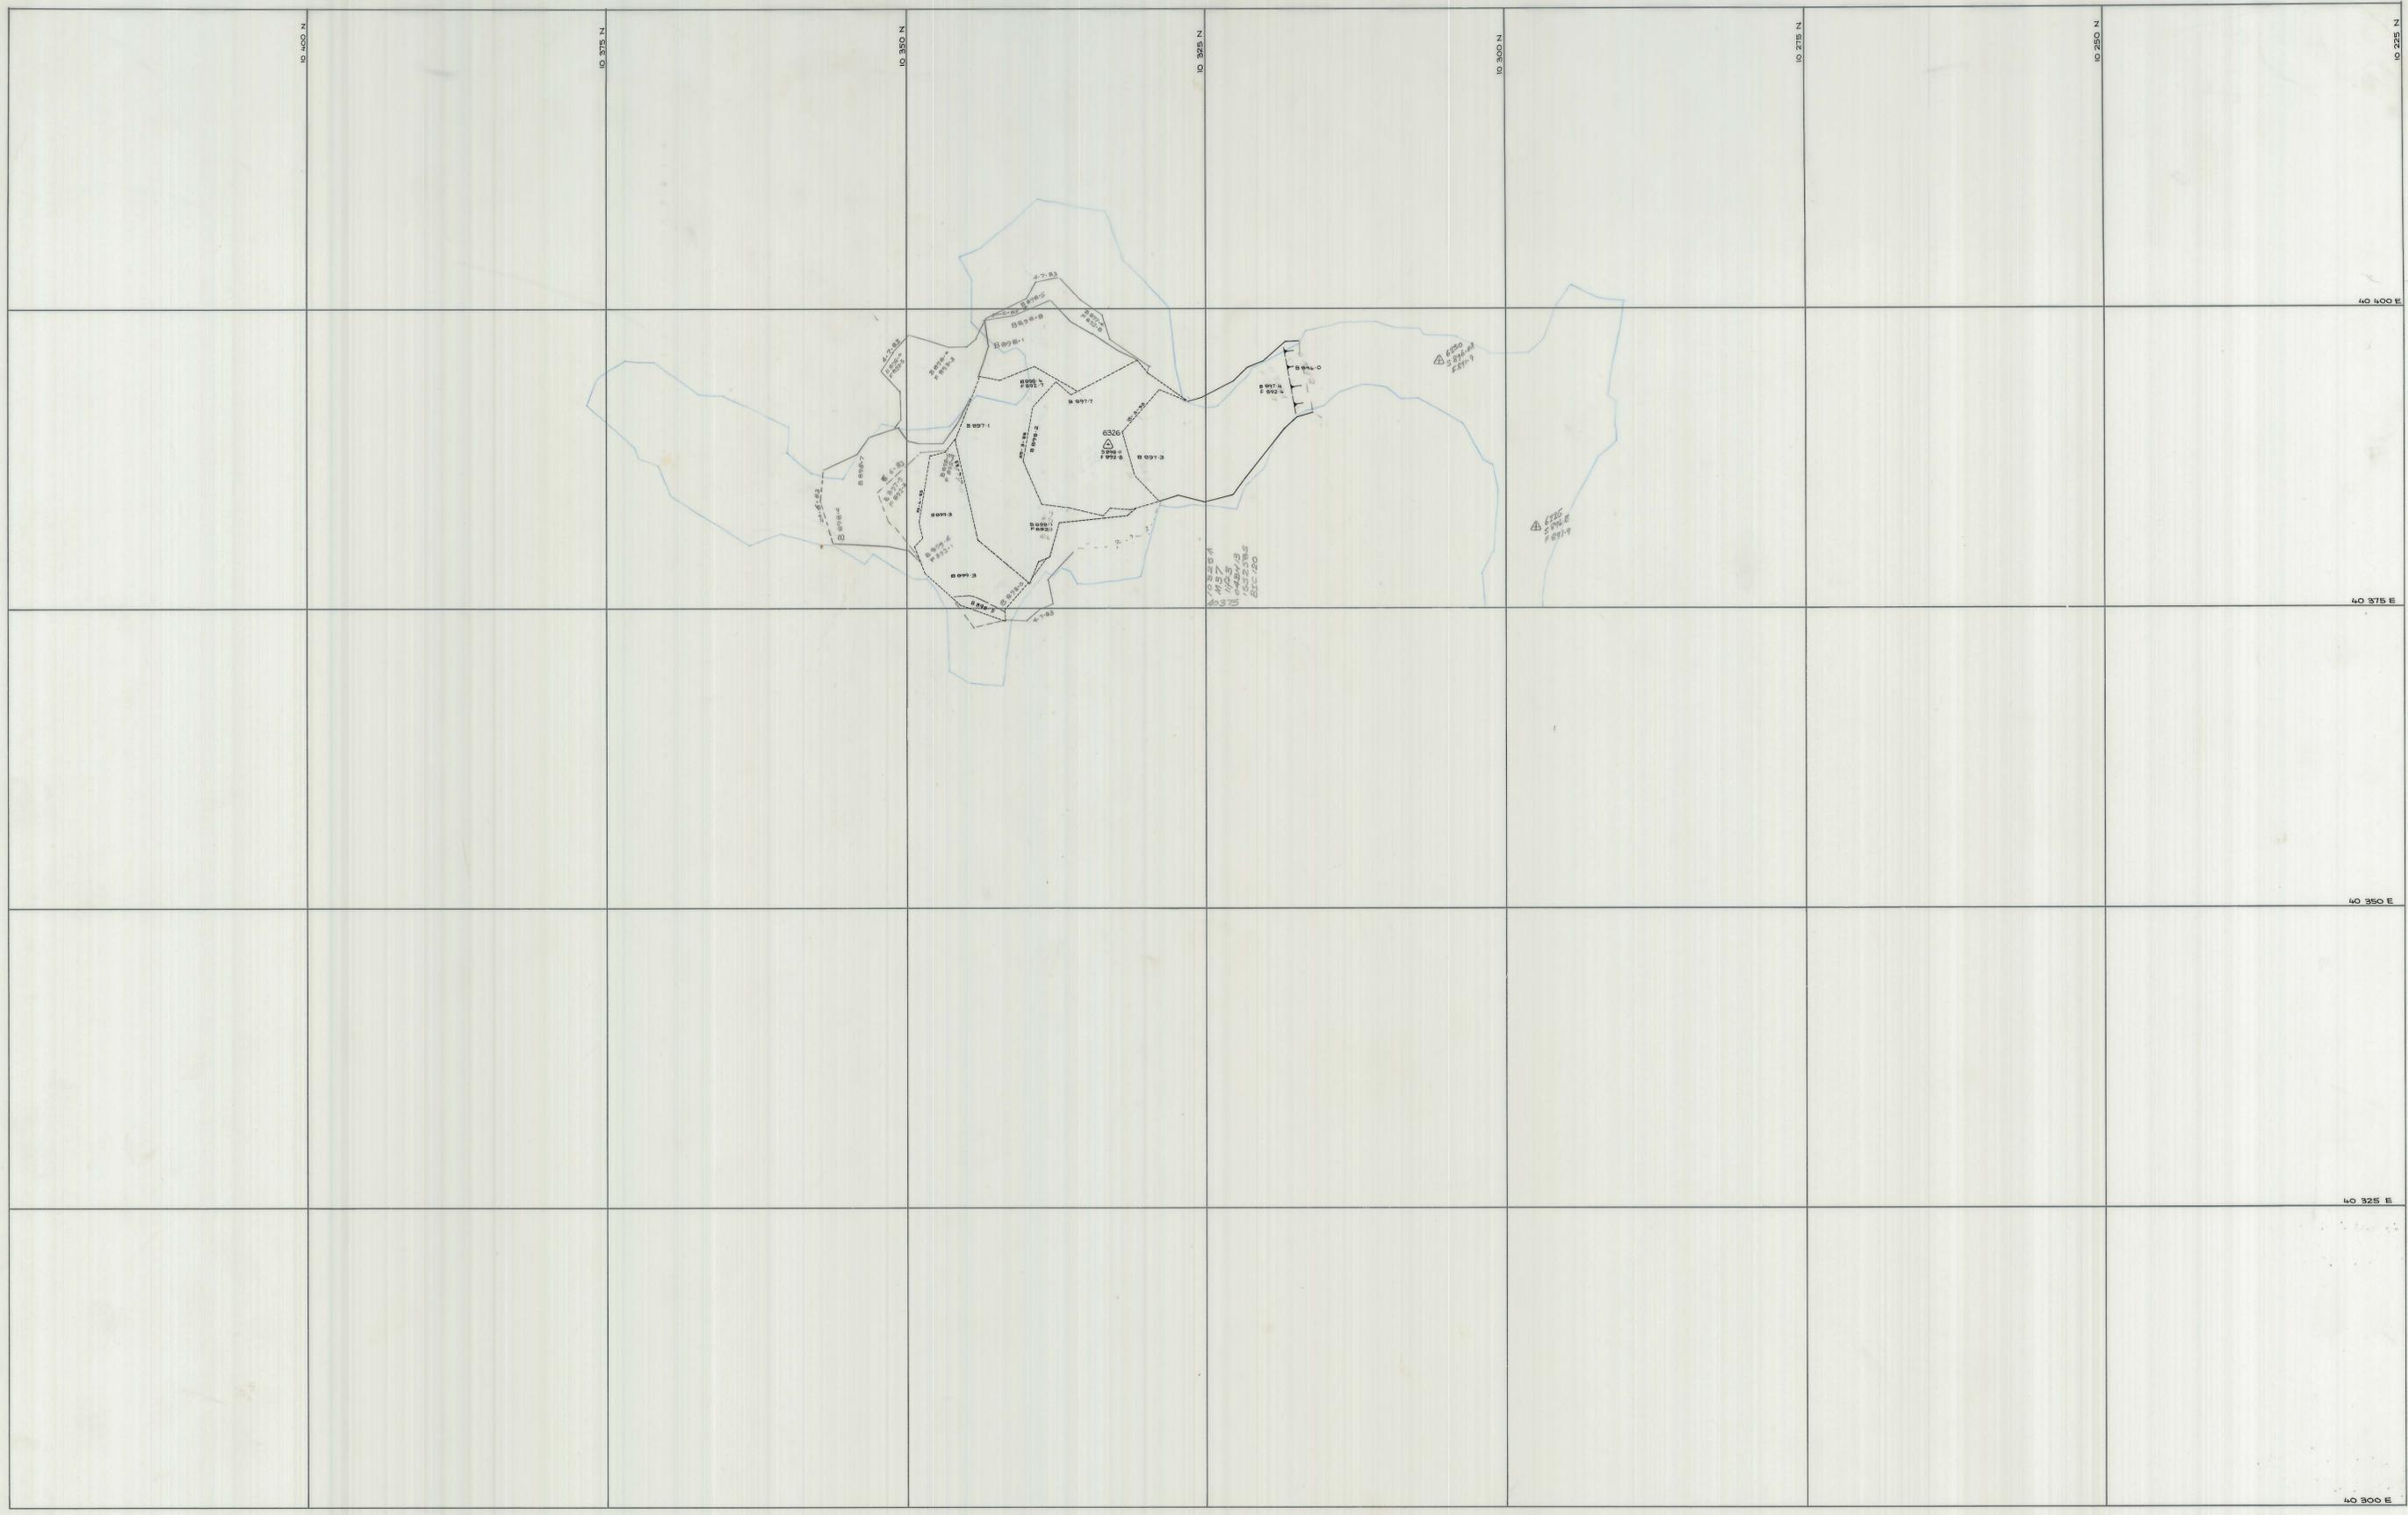

SCALE 1:250



LOCATION BOLD HEAD MINE
 SUBJECT M 37 STOPE
 3rd lift

KIS KING ISLAND SCHEELITE
 A DIVISION OF WARMAN INTERNATIONAL
 KING ISLAND
 GRASSY
 PLAN NUMBER 04BH13 - 155 258 S