


04BH13 - 155 236 S  
T47 lift 1  
Q49

0374\_4329



SCALE 1:250

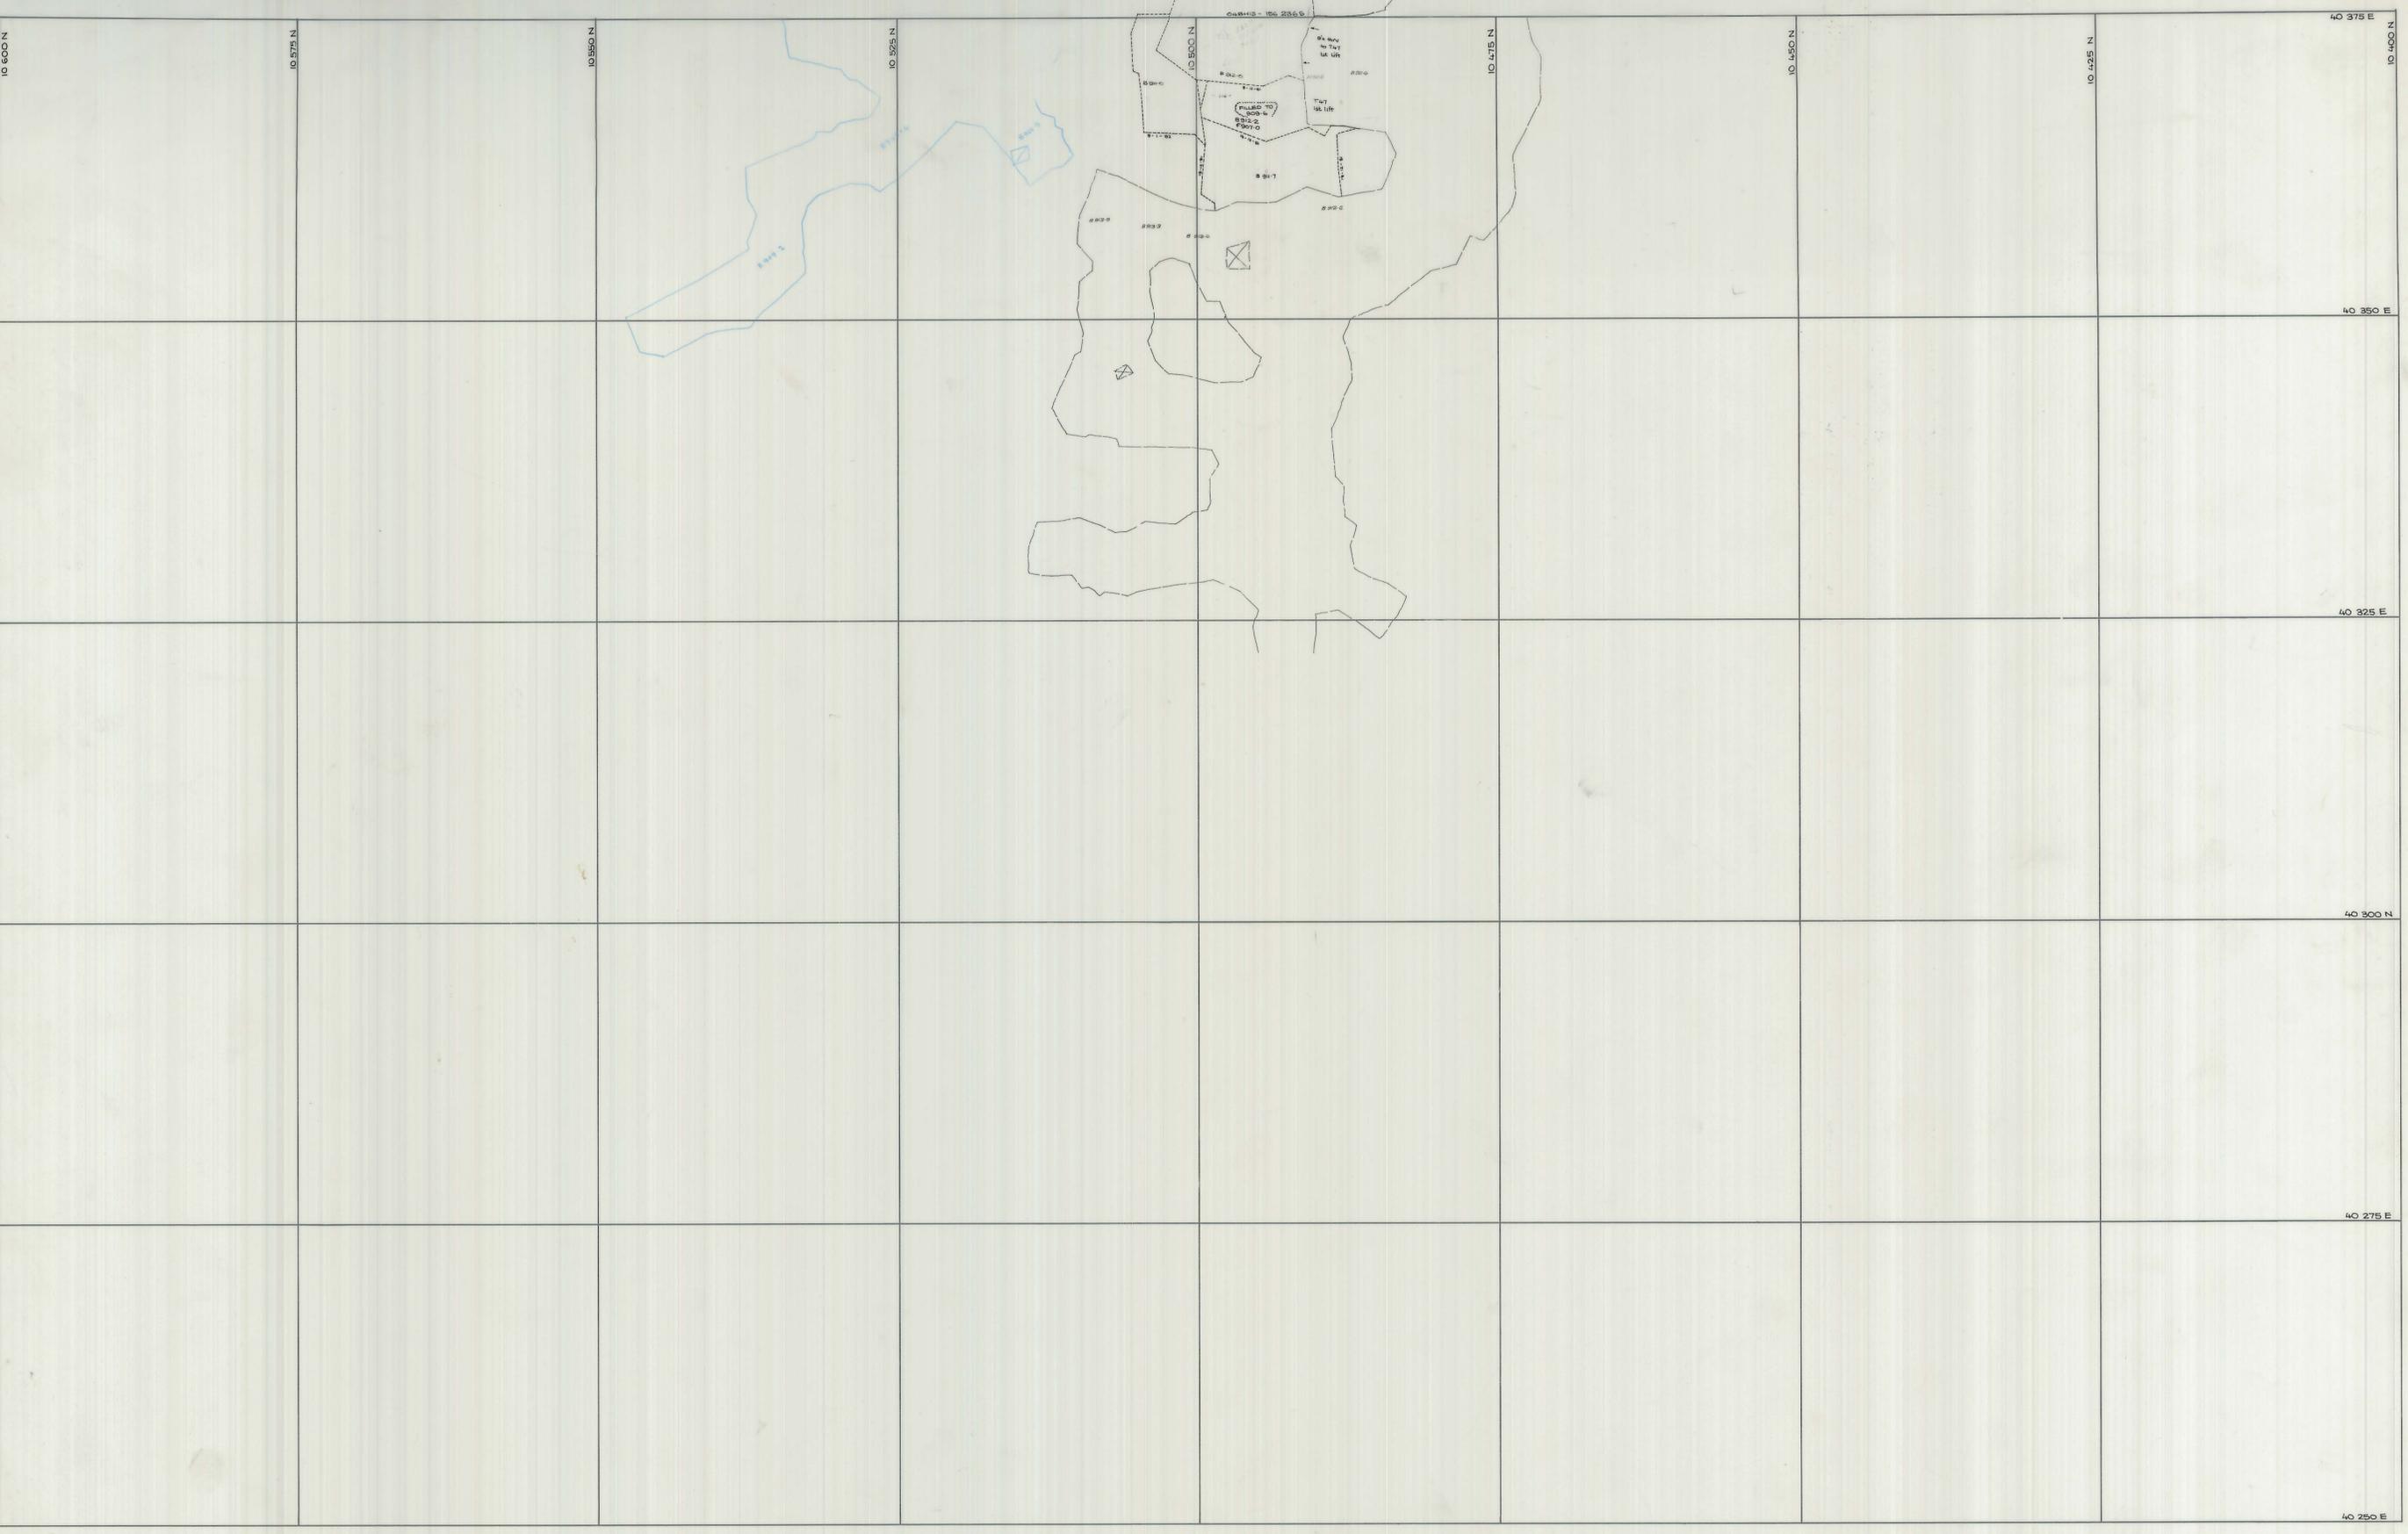

LOCATION BOLD HEAD MINE

SUBJECT

Q 49  
[T47 STOPE - 2nd lift]

**KIS** KING ISLAND SCHEELITE  
A DIVISION OF WARMAN INTERNATIONAL

GRASSY KING ISLAND

PLAN NUMBER 04BH13 - 155 236 S