
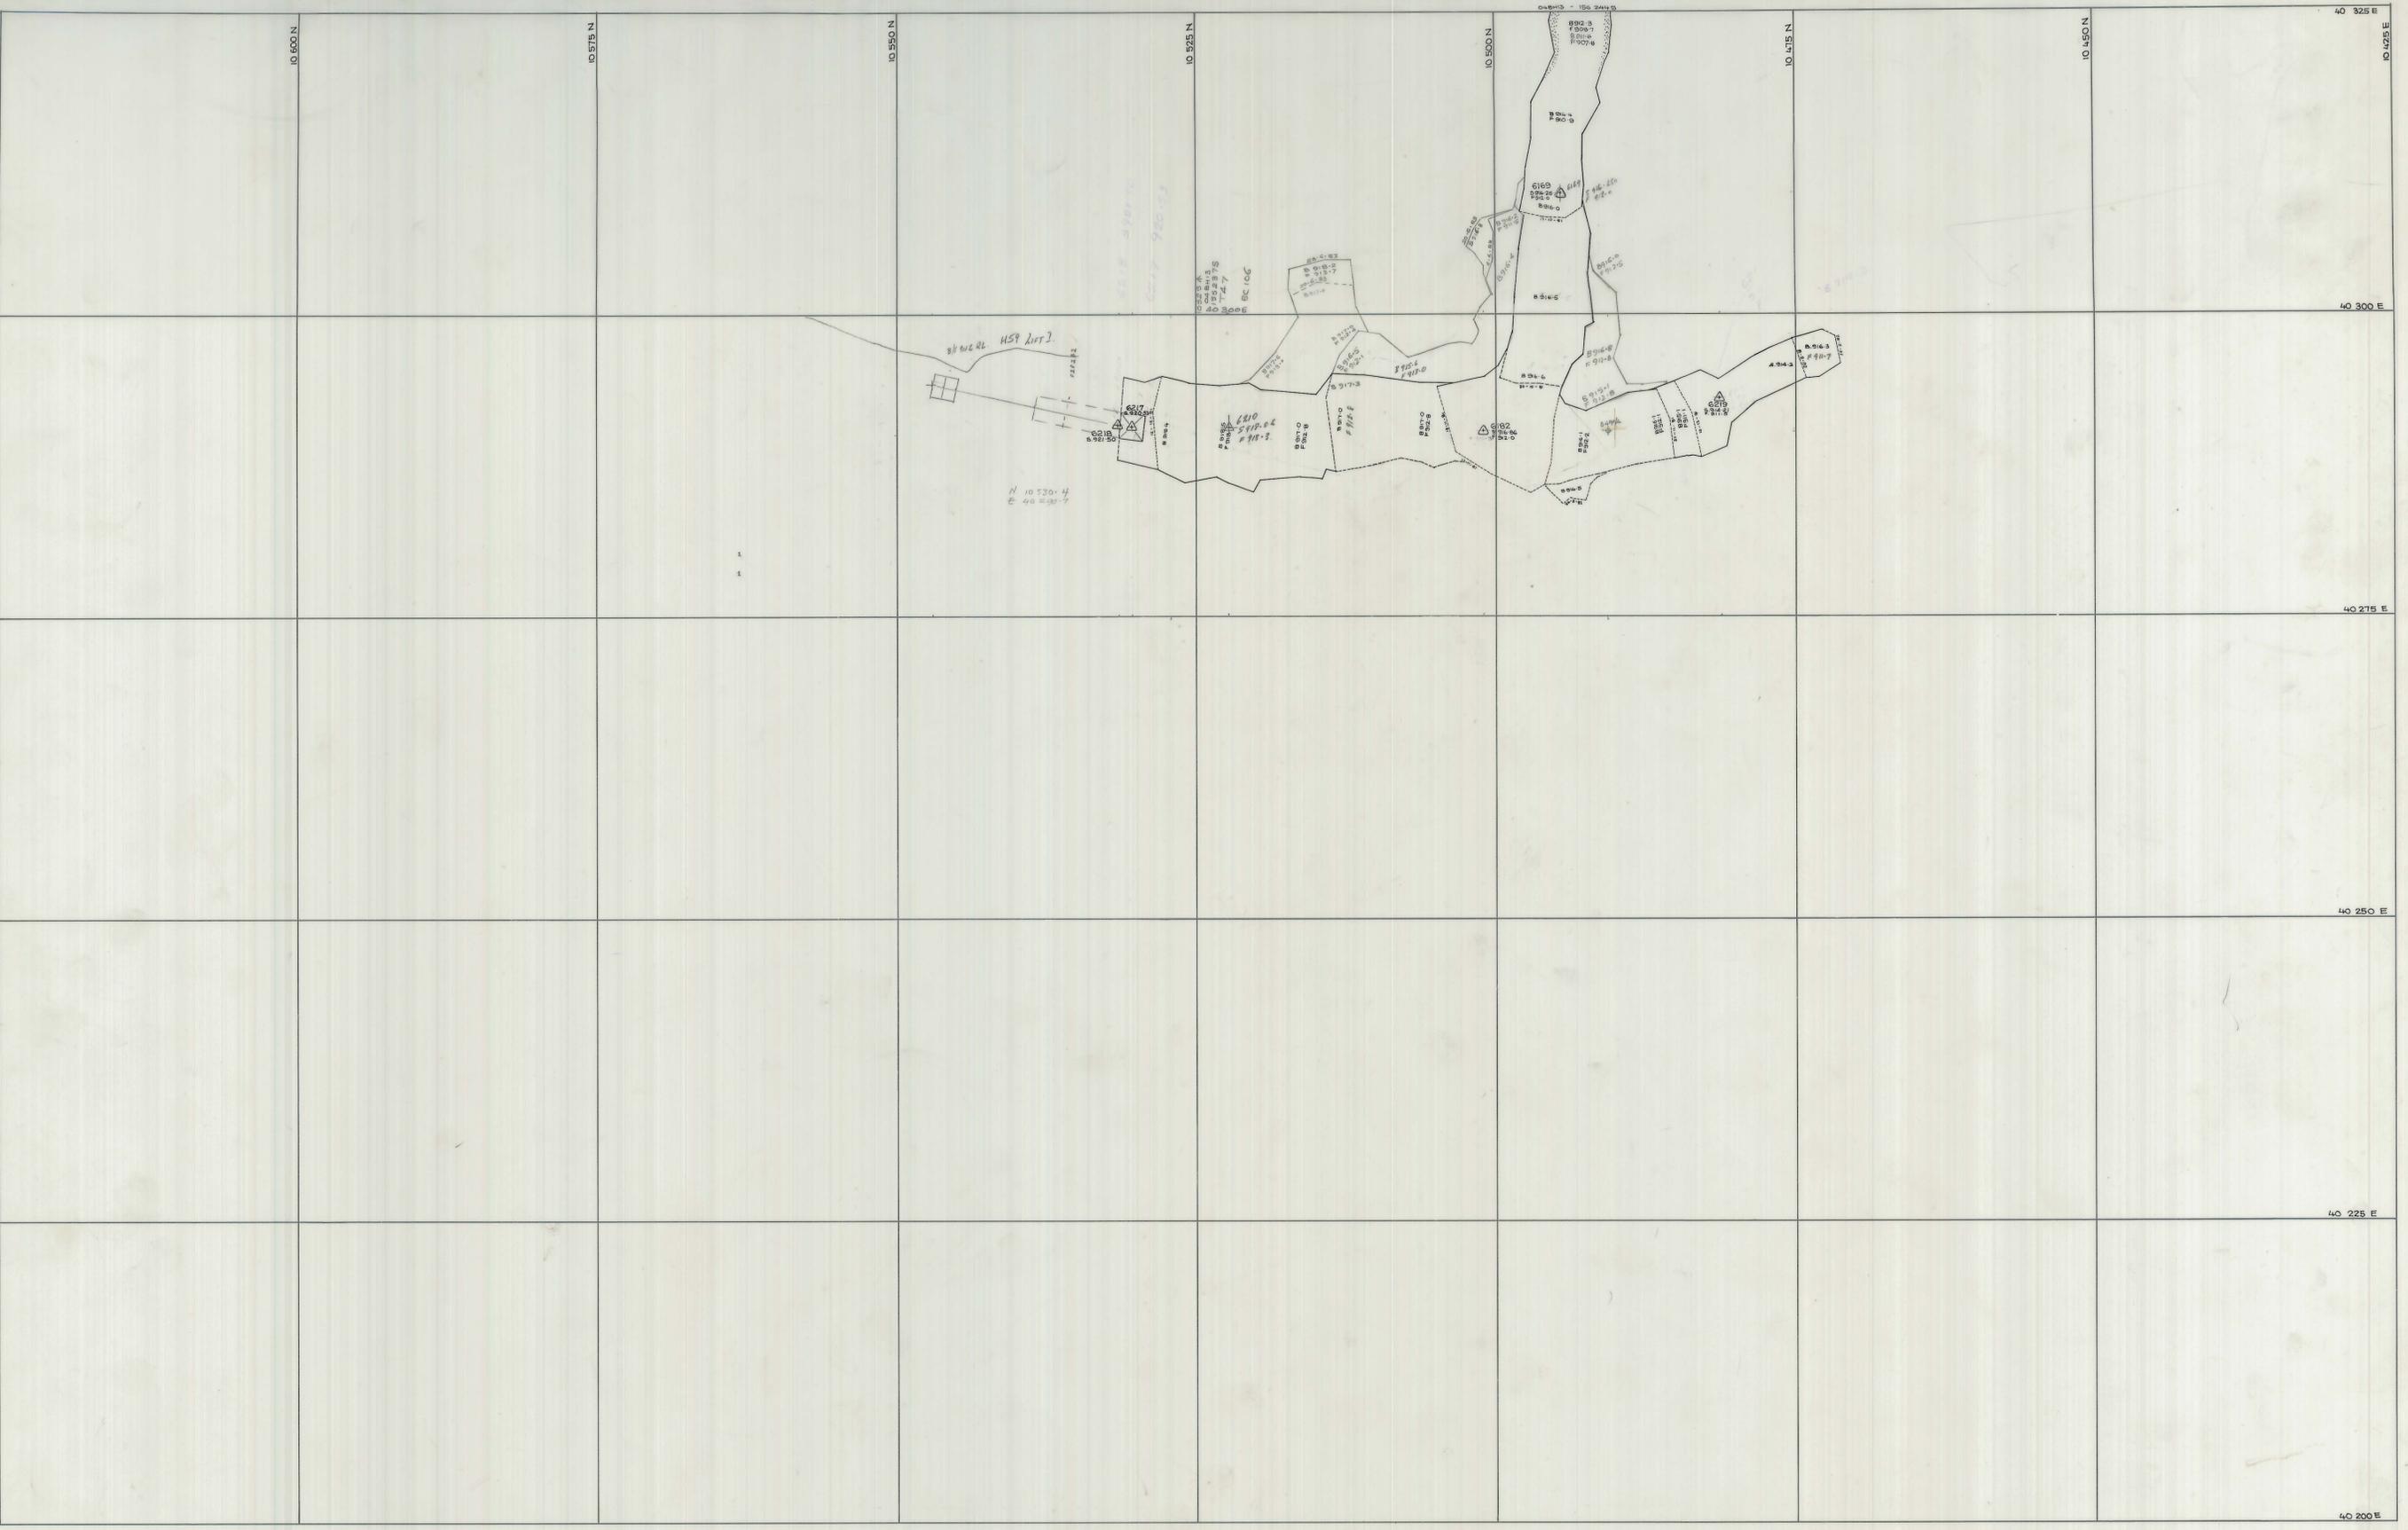


04BH13 - 155 237 S
127 (CL-127)
LIFT 0

0374_4330

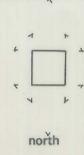

1150
913
37

<p>SCALE 1: 250</p>	 <p>north</p>	<p>LOCATION BOLD HEAD MINE</p> <p>SUBJECT ACCESS TO C LENS WEST (kda stop) from T47 Stope [1st lift]</p>	 <p>KING ISLAND SCHEELITE A DIVISION OF WARMAN INTERNATIONAL</p> <p>GRASSY KING ISLAND</p> <p>PLAN NUMBER 04BH13 - 155 237 S</p>
---------------------	--	--	---