


04BH13 - 155 243 S

N51
LIFT ①

0374_4333

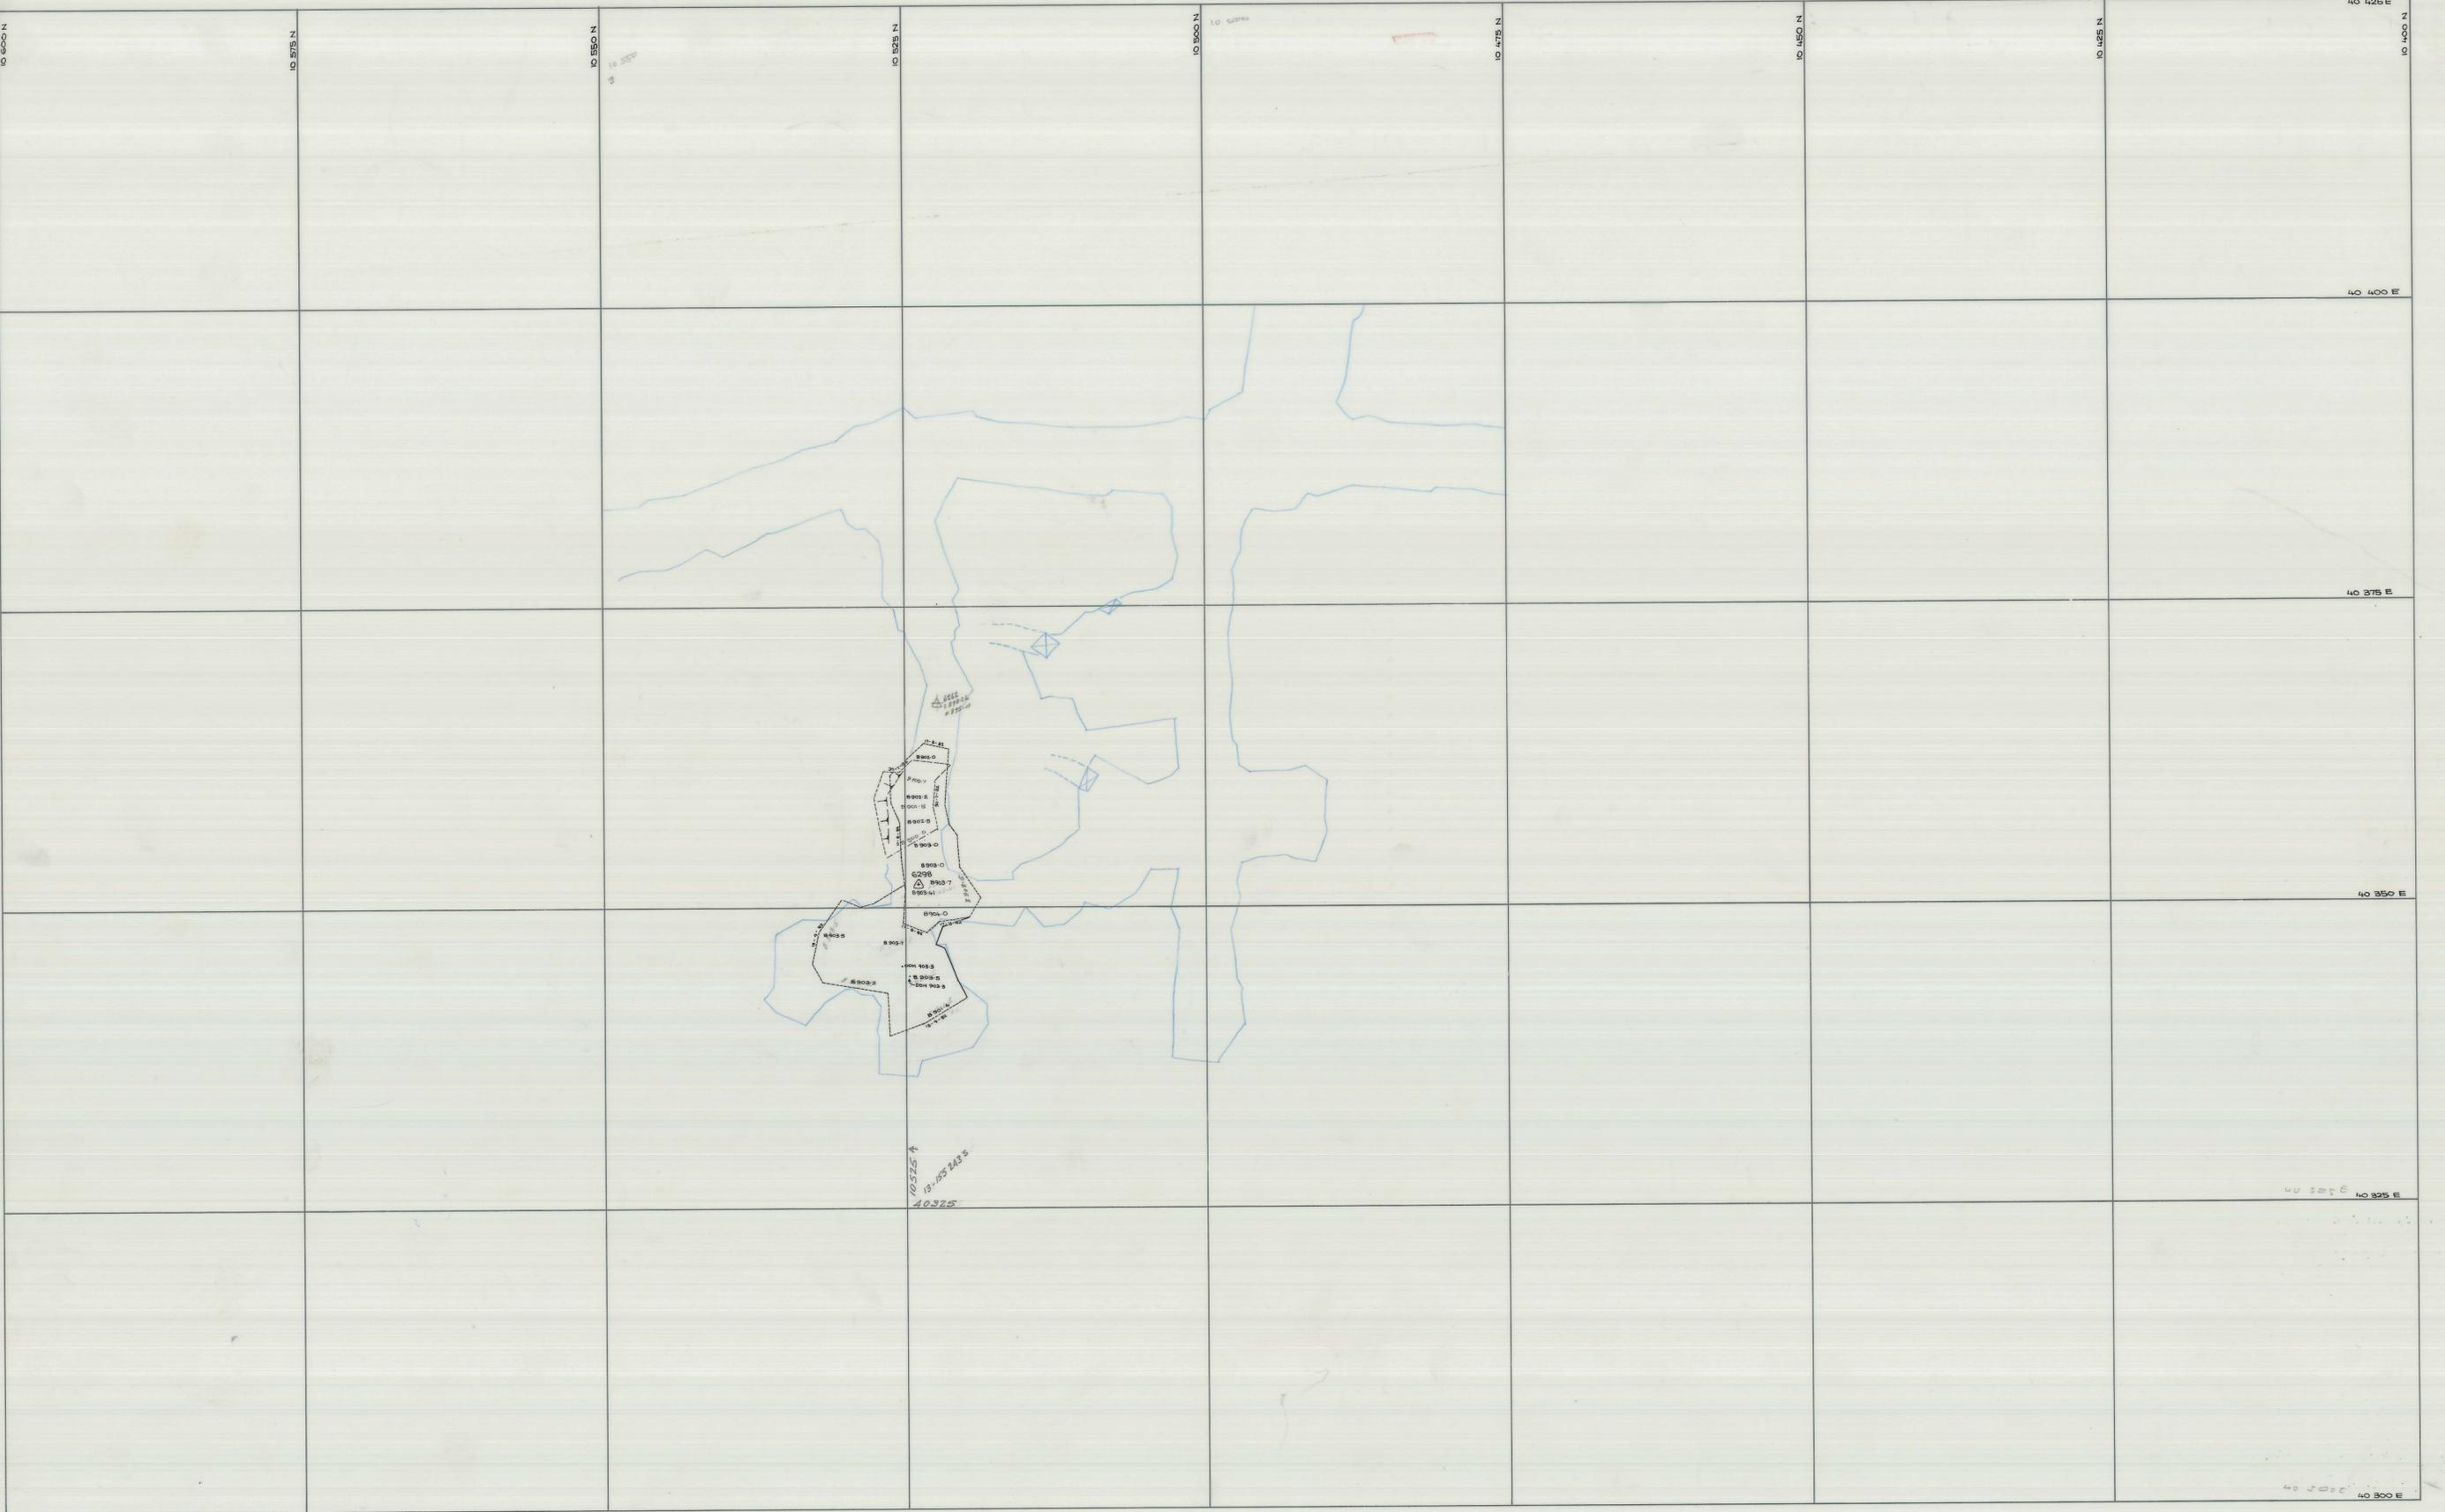

SCALE 1: 250	 <p>north</p>	<p>LOCATION BOLD HEAD MINE</p> <p>SUBJECT N 51 1st lift</p>	 <p>A DIVISION OF WARMAN INTERNATIONAL</p> <p>GRASSY KING ISLAND</p>
			<p>PLAN NUMBER 04BH13 - 155 243 S</p>