


27 JUN 1981

5 cm

0374\_4334

046

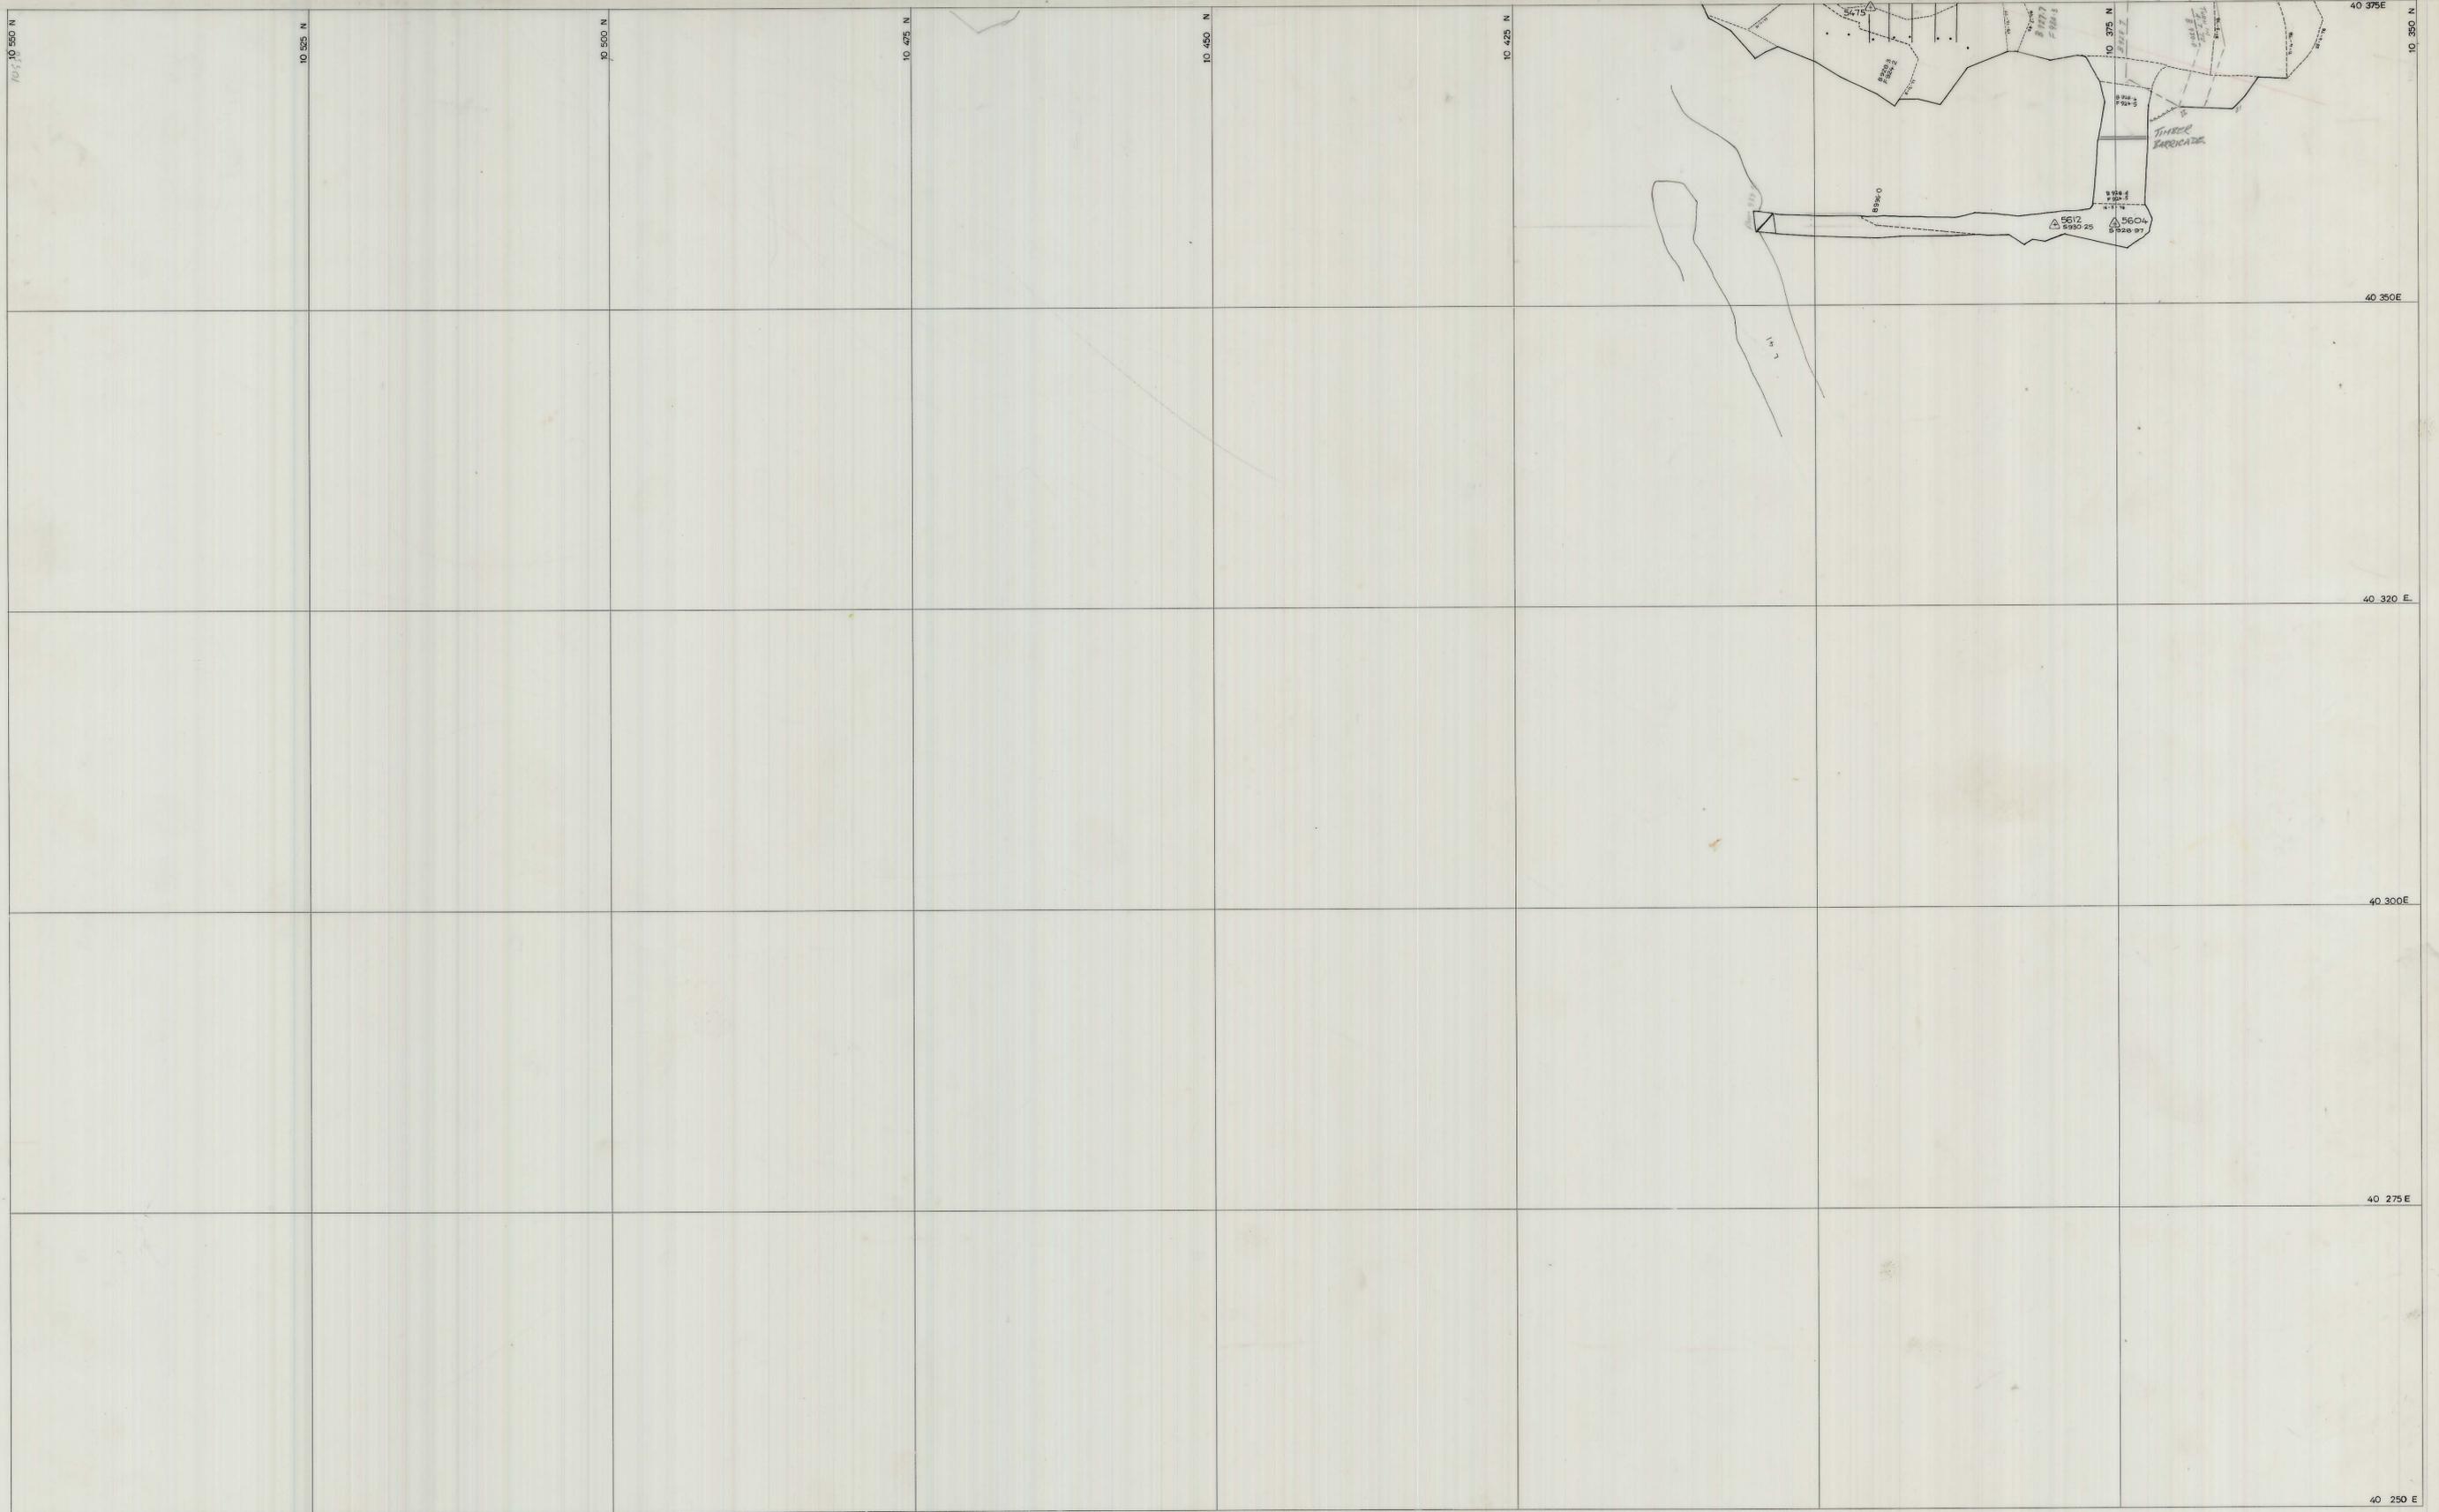

SCALE 1:250

LOCATION BOLD HEAD

SUBJECT

B.F.2

north

**KIS** KING ISLAND SCHEELITE  
A DIVISION OF HARMAN INTERNATIONAL

GRASSY KING ISLAND

PLAN NUMBER  
04BH13-155225